



KANSAS CORPORATION COMMISSION

Remediation Site Status Report

2015

**Abandoned Oil and Gas Well / Remediation Site Fund
Remediation Sites
Status Report**

Introduction

During the 1996 legislative session House Substitute for Senate Bill 755 was passed. Part of this legislation creates an Abandoned Oil and Gas Well / Remediation Fund with the expressed purpose of providing funds to the Kansas Corporation Commission to plug abandoned wells and remediate contamination sites (sites and wells having no responsible parties) related to oil and gas exploration and production activities. The legislation also requires that the Kansas Corporation Commission prepare an annual Remediation Site Status Report for the office of the Governor and certain legislative committees. This report for the period January 1, 2014, through December 31, 2014, contains information for each of the sites with regard to the following: (1) A description and evaluation of the site; (2) the immediacy of the threat to public health and environment; (3) the level of remediation sought; (4) any unusual problems associated with the investigation or remediation; (5) any remedial efforts completed during the review period; (6) current contaminate level; (7) status of the site; (8) direct and indirect costs associated with remedial efforts; and (9) an estimate of the cost to achieve the recommended level of remediation, or an estimate of the cost to conduct an investigation sufficient to determine the cost of remediation. The Site Remediation cash expenditures for FY2015 are projected to be approximately \$50,000.

Site Inventory

The inventory of sites listed in the current Remediation Site Status Report consists of 52 sites. This report includes sites that were transferred to the control of the Kansas Corporation Commission (KCC) from the Kansas Department of Health and Environment (KDHE) by legislative action in 1995 and in-house sites already under KCC jurisdiction. Of the original 109 sites, four were combined with other sites. During previous evaluation periods, 76 sites have been resolved and 23 sites have been added. The current evaluation period, January 1, 2014, through December 31, 2014, ended with the resolution of one site, resulting in a total of 51 active sites. Summary tables for site impacts and immediacy levels as well as estimated costs are found at the beginning of the report. The tables below provide an overview of distribution of sites with respect to both resources impacted and the range of immediacy levels for required remediation.

Distribution of Active Sites with Respect to Impacted Resources

Impacted Resources	Number of Sites
Groundwater, Surface Water, Soil and Well Problems (Cavity, Abandoned)	74
Public Water Supply	8
Domestic Supply	21
Stock Supply	14
Irrigation Supply	11

*Some sites have impacts to multiple resources


Distribution of Active Sites with Respect to Immediacy Levels

Range of Immediacy Level	No. of Sites
Low & Low to Moderate	25
Moderate	8
Moderate to High & High	12
Other (Under Remediation)	6
Total	51

Site Status


In general each contamination site has a definable life cycle. This cycle begins with, then follows a sequence, of investigatory and possible remedial activities which move the site toward ultimate resolution. The first phase of the cycle is the site assessment. This phase defines general site parameters and conditions forming the basis for additional efforts at the site. Once the assessment is complete the site moves on to a new phase. This next phase may be short term or long term monitoring followed by resolution of the site. Another scenario might include an extensive investigation phase followed by the installation of a monitoring system whose sample results may indicate the necessity for certain remedial activities and additional post remediation monitoring prior to resolution of the site. The following graphs depict the current status of the 52 listed sites on a statewide and K.C.C. District basis.

STATEWIDE DISTRIBUTION OF SITES BY STATUS

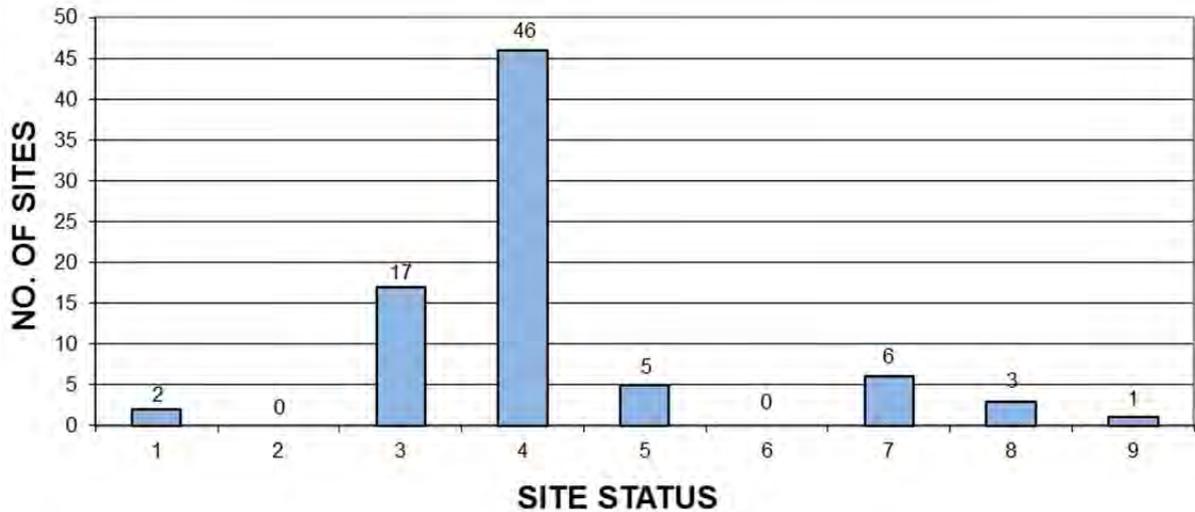


1. SITE ASSESSMENT	2. SHORT TERM MONITORING	3. INVESTIGATION
4. LONG TERM MONITORING	5. REMEDIATION PLAN	6. INSTALLATION
7. REMEDIATION	8. POST REMEDIATION MONITORING	9. RESOLVED

DISTRICT 1 DISTRIBUTION OF SITES BY STATUS

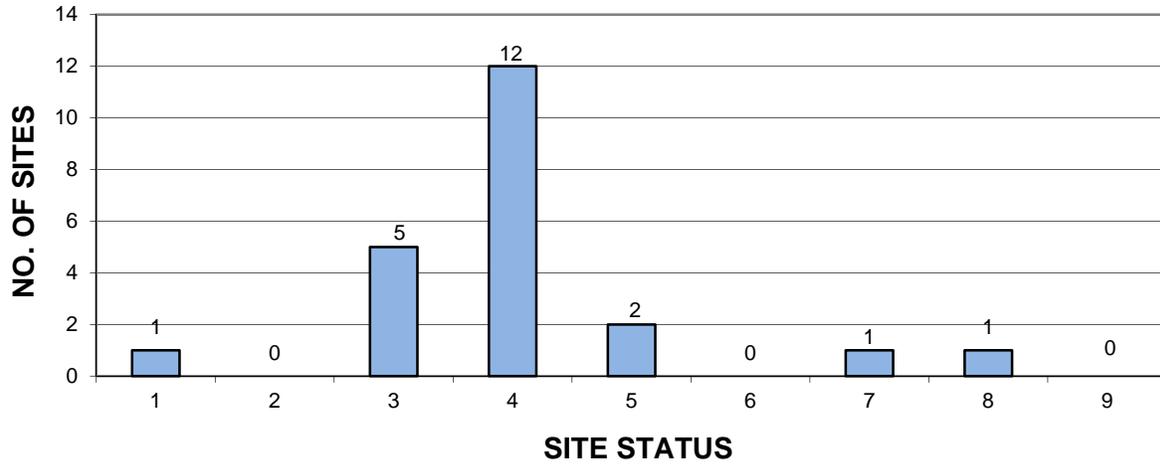


- | | | |
|-------------------------|--------------------------------|------------------|
| 1. SITE ASSESSMENT | 2. SHORT TERM MONITORING | 3. INVESTIGATION |
| 4. LONG TERM MONITORING | 5. REMEDIATION PLAN | 6. INSTALLATION |
| 7. REMEDIATION | 8. POST REMEDIATION MONITORING | 9. RESOLVED |

DISTRICT 2 DISTRIBUTION OF SITES BY STATUS

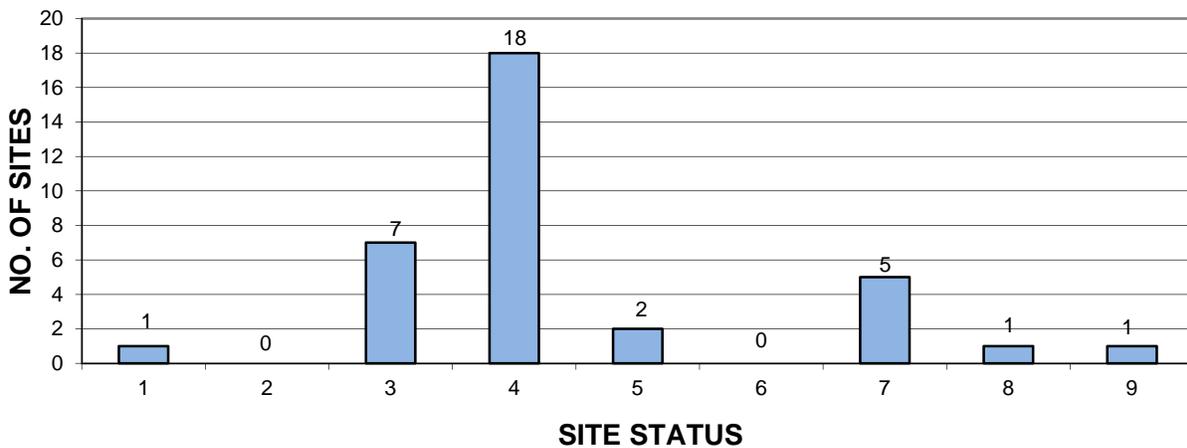


- | | | |
|-------------------------|--------------------------------|------------------|
| 1. SITE ASSESSMENT | 2. SHORT TERM MONITORING | 3. INVESTIGATION |
| 4. LONG TERM MONITORING | 5. REMEDIATION PLAN | 6. INSTALLATION |
| 7. REMEDIATION | 8. POST REMEDIATION MONITORING | 9. RESOLVED |

DISTRICT 3 DISTRIBUTION OF SITES BY STATUS

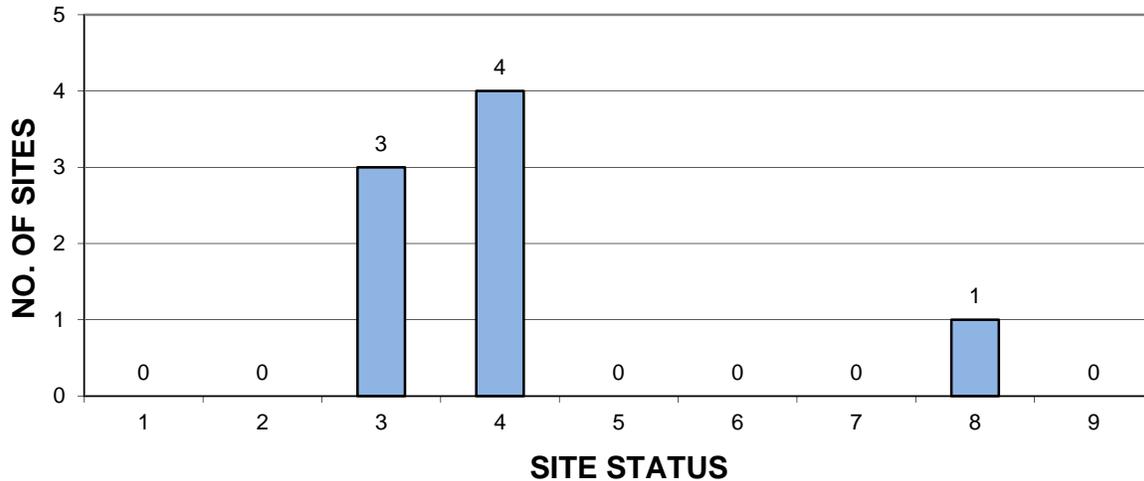

- | | | |
|-------------------------|--------------------------------|------------------|
| 1. SITE ASSESSMENT | 2. SHORT TERM MONITORING | 3. INVESTIGATION |
| 4. LONG TERM MONITORING | 5. REMEDIATION PLAN | 6. INSTALLATION |
| 7. REMEDIATION | 8. POST REMEDIATION MONITORING | 9. RESOLVED |


DISTRICT 4 DISTRIBUTION OF SITES BY STATUS

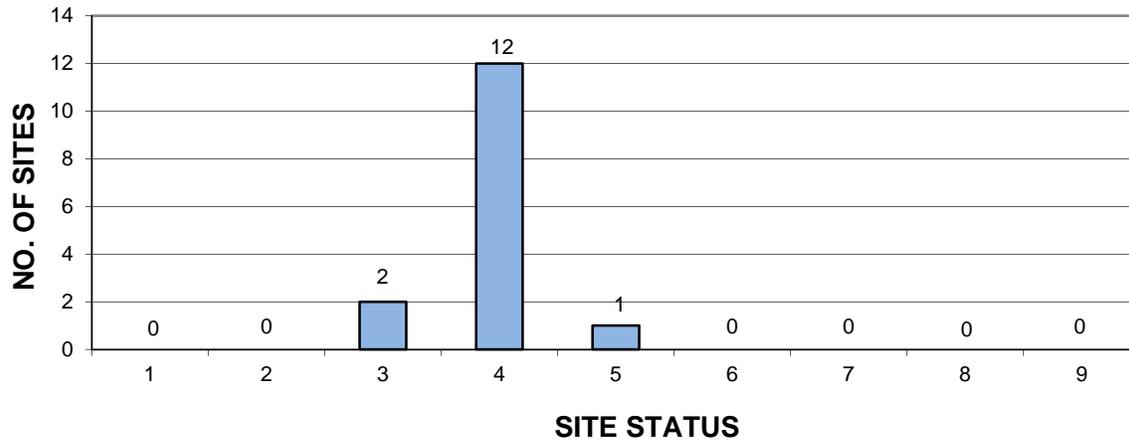

- | | | |
|-------------------------|--------------------------------|------------------|
| 1. SITE ASSESSMENT | 2. SHORT TERM MONITORING | 3. INVESTIGATION |
| 4. LONG TERM MONITORING | 5. REMEDIATION PLAN | 6. INSTALLATION |
| 7. REMEDIATION | 8. POST REMEDIATION MONITORING | 9. RESOLVED |

This graph depicts the distribution of sites by status for the reporting periods 2011 through 2015.

Distribution of Sites by Status for Reporting Periods 2011 - 2015

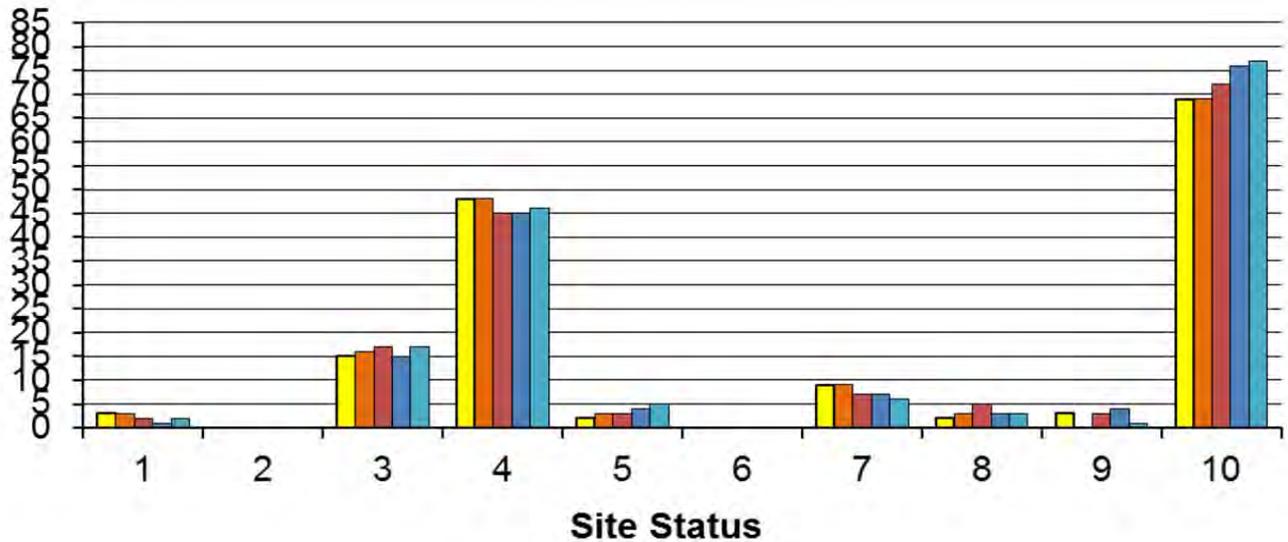

- | | | |
|----------------------------|--------------------------------|------------------|
| 1. SITE ASSESSMENT | 2. SHORT TERM MONITORING | 3. INVESTIGATION |
| 4. LONG TERM MONITORING | 5. REMEDIATION PLAN | 6. INSTALLATION |
| 7. REMEDIATION | 8. POST REMEDIATION MONITORING | 9. RESOLVED |
| 10. RESOLVED - CUMMULATIVE | | |

Conclusions

This report provides information concerning the location, resource impact, immediacy level, and site description and status for 52 listed contamination / remediation sites related to exploration and production activities in the state. In addition, data is presented with regard to staff expenditures for site management, administration, and inspections, as well as authorization and/or expenditures against the Abandoned Well / Remediation fund for investigatory and remedial activities at the sites.

The Conservation Division of the Corporation Commission is committed to work with the oil and gas industry of the state, other state agencies and the public to provide a scientifically sound and technically based remediation program.

**Impacts, Immediacy and Target Remediation Levels
For
Kansas Corporation Commission Contamination Sites**

Site Name	County	KCC District	Impact	Immediacy	Target Level Of Remediation	Unusual Problems	Estimated Total Cost
Arlington	Reno	2	GW / Soil / DM / IR / WSW UR	UR	250 ppm	Yes	\$ 7,500*
Balthazor	Graham	4	GW / Domestic(Sole Source)	Low	250 ppm	No	\$ 10,000
Brazil	Neosho	3	SW / GW / PWS / Soil	Low-Mod	500 ppm	No	\$ 63,000
Brothers	Rice	2	Groundwater	Low	500 ppm	Yes	\$ 4,000
Burrton	Harvey/Reno	2	GW / Domestic / Irrigation	High	Variable	Yes	\$3,000,000
Clawson(Mesa)	Haskell	1	Groundwater / Irrigation	Mod-High	500 ppm	Yes	\$ 450(yr)*
Curtis	Stafford	1	Groundwater / Irrigation	Low-Mod	500-1000 ppm	Yes	\$ 27,000
Dinkel	Ellis	4	GW / Domestic (SS)	Low	250 ppm	Yes	\$ 30,000
Dinkler	Butler	2	GW / Domestic / Irrigation	Resolved	Reached	Yes	\$ 21,792
EB-3C	Reno	2	Groundwater	Low	No Free Liquid Hydrocarbon	Yes	\$ 8,000
Elm Creek	Rooks	4	GW / Domestic / Stock Well	Mod-High	500 ppm	Yes	\$ 300,000
Enoch-Thompson	Pawnee	1	Groundwater / Stock Well	Low-Mod	1000 ppm	No	\$ 500(yr)*
Fink, Leon	Graham	4	Groundwater / Stock Well	Low	500 ppm	Yes	\$ 2,000

Site Name	County	KCC District	Impact	Immediacy	Target Level Of Remediation	Unusual Problems	Estimated Total Cost
Fowler	Montgomery	3	Soil	Low	300 ppm	Yes	\$ 4,500
French	Stafford	1	GW / SW / SD / WP	Mod-High	500 ppm	Yes	\$ 3,000
Galva City	McPherson	2	Groundwater	UR	500 ppm	Yes	\$ 500,000
Harbaugh	Barber	1	GW / Domestic / Stock Well	High	1000 ppm	Yes	\$ 450,000*+
Hollow-Nikkel	Harvey	2	GW / Domestic / Irrigation	Moderate	500 ppm	Yes	\$ 75,000
Hrencher	Barber	1	GW/ STK / Soil / SW	Mod-High	1000 ppm	No	\$ 150,000
Irey - Hrabe	Rooks	4	Groundwater	Moderate	500 ppm	No	\$ 15,000
Jennings	Decatur	4	Groundwater / PWSW	Low-Mod	500 ppm	Yes	\$ 2,000
Johnson, C	Rice	2	Groundwater / SD	Low	750 ppm	No	\$ 2,500
Knackstedt	McPherson	2	WP (Cavity)	Moderate	NA	Yes	\$ 5,000
Korf	Hodgeman	1	GW / SW/ Soil	Low	1000 ppm	Yes	\$ 2,500*
Leesburg Sink	Stafford	1	WP (Cavity)	Mod-High	NA	Yes	\$ 62,000*
Little River	Rice	2	Groundwater / PWS	High	300 ppm	Yes	\$ 46,500
Macksville	Pawnee	1	Groundwater / IR	Mod-High	300 ppm	Yes	\$ 20,000(yr)*
Mantooth	Montgomery	3	GW / Domestic (SS) / SW	Moderate	500 ppm	Yes	\$ 10,000+
Maupin	Russell	4	Groundwater / Stock Well	Low	500 ppm	No	\$ 2,000

Site Name	County	KCC District	Impact	Immediacy	Target Level Of Remediation	Unusual Problems	Estimated Total Cost
McDonald - East	Linn	3	Surface Water	Low	500 ppm	No	\$ 1,500(yr)
McPherson LandFill	McPherson	2	GW / DM / SD / INDWSW	UR	500 ppm	No	\$ 26,500*
Nikkel-Epps	McPherson	2	GW / Domestic (SS)	Mod-High	500 ppm	Yes	\$ 20,000
Packard	Barber	1	GW / Water Well / STK	Moderate	1000 ppm	Yes	\$ 10,000
Ruder	Ellis	4	Groundwater / SW	Moderate	500 ppm	Yes	\$ 29,000
Running Turkey Ck	McPherson	2	DM/PWS/SW/SD/STK/IR	Mod-High	500 ppm	Yes	\$ 125,000
Russell City	Russell	4	GW / Domestic / Irrigation	Low	1000 ppm	Yes	\$ 400,000
Russell RWD #1	Russell	4	Groundwater / PWSW	Low-Mod	250 ppm	Yes	\$ 33,000
Sample	Sedgwick	2	Groundwater	Low	500 ppm	Yes	\$ 2,000
Sander	Russell	4	GW / Domestic / Stock Well	Low	1000 ppm	No	\$ 300
Schraeder	Hodgeman	1	Groundwater / Stock Well	Low	350 ppm	No	\$ 30,000
Schruben-Rogers	Rooks	4	GW / Domestic (SS)	Low	250 ppm	No	\$ 2,000
Schulte Field	Sedgwick	2	GW / Domestic / PWSW	UR	500 ppm	Yes	\$ 300,000
Selzer	McPherson	2	Groundwater / SW	Moderate	500-750 ppm	Yes	\$ 20,000
Smith-Finn	Morton	1	Groundwater / Domestic	UR	500 ppm	Yes	\$ 200,000*
South Spivey	Kingman	2	GW / DM / SW	Low	750 ppm	Yes	\$ 5,000*

Site Name	County	KCC District	Impact	Immediacy	Target Level Of Remediation	Unusual Problems	Estimated Total Cost
South Wichita	Sedgwick	2	GW / PWSW / DM / IR	Low	500 to 750 ppm	Yes	\$ 43,000
Stowe-Zaid	Rice	2	Groundwater / Soil	Low	350 ppm	Yes	\$ 12,000
Trostle	Kingman	2	GW / Domestic / STK / Soil	Low	500 ppm	No	\$ 2,500*
Voshell	McPherson	2	GW / SW / DM / IR / STK	Moderate	500 ppm	Yes	\$ 20,000
Wildboy's	Barber	1	GW / SW / PWSW	Mod-High	500 ppm	No	\$ **
Wingate	Wilson	3	Groundwater / Soil	Low	500 ppm	Yes	\$ 15,000
Yoeman	Kingman	2	GW / DM / Stock Well	UR	NA	Yes	\$ 56,000+
Total Estimated Cost							\$6,177,042

ABDW=Abandoned Well DM=Domestic GW=Groundwater INDWSW=Industrial Water Supply Well IR=Irrigation Well
Mod=Moderate PWSW=Public Water Supply Well SD=Surface Damage STK=Stock Well SW=Surface Water
SS=Sole Source UR=Under Remediation WSW=Water Supply Well WP=Well Problem

*PRP – Potential Responsible Party involvement **See Harbaugh Site for costs +Actual costs have exceeded original estimate

CONTAMINATION SITE EXPENDITURES

SITE NAME	CONTROL NO.	STAFF HOURS	EXPENDITURE FOR STAFF HOUR	REMEDIATION FUND AUTHORIZATION / EXPENDITURE	
				FY 2014/15	TOTAL
ARLINGTON	20030016-001	22	\$585.26		
BALTHAZOR	970023-00	32	\$771.22		
BRAZIL	990040-001	65.5	\$1,728.88		\$10,767.25
BROTHERS	970029-00	11	\$296.07		\$4.26
BURRTON	970003-00	33.5	\$862.26	\$4,229.68	\$320,247.99
CLAWSON	970005-00	8	\$213.58		
CURTIS	970034-00	10	\$269.78		\$4,199.17
DINKEL	970035-00	14	\$347.56		
DINKLER	20050047-001	5	\$142.50		\$9,642.50
EB-3C	970042-00	8	\$217.20		\$2,350.00
ELM CREEK	970043-00	44	\$1,064.98		\$29,212.25
ENOCH THOMPSON	970044-00	5	\$138.33		
FINK	970007-00	23	\$565.05		
FOWLER	970046-00	24	\$637.84		
FRENCH	990002-001	2	\$59.46		\$346.50
GALVA CITY AREA	980033-001	449	\$11,908.87	\$29,949.35	\$266,736.01
HARBAUGH	970049-00	59.5	\$1,548.14	\$950.00	\$536,980.90
HOLLOW NIKKEL	970009-00	155.5	\$4,006.36	\$2,460.12	\$34,782.77
HRENCHER	970051-00	8	\$217.20		\$189.94
IREY-HRABE	970053-00	52	\$1,255.16		
JENNINGS	970054-00	40	\$950.08		
JOHNSON	970055-00	22	\$585.26		\$416.28
KNACKSTEDT	970060-00	12	\$322.36		\$153.39
KORF	20140017-001	3.5	\$98.90		
LEESBURG SINK	20040003-001	3.5	\$98.90		\$6,266.00
LITTLE RIVER	20000057-001	38	\$974.42		\$3,112.20

SITE NAME	CONTROL NO.	STAFF HOURS	EXPENDITURE FOR STAFF HOUR	REMEDIATION FUND AUTHORIZATION / EXPENDITURE	
				FY 2014/15	TOTAL
MACKSVILLE	970066-00	64	\$1,628.86	\$1,200.00	\$74,212.02
MANTOOTH	980058-001	59.5	\$1,571.14		\$17,349.00
MAUPIN	970068-00	53	\$1,285.30		
MC DONALD-EAST	970070-00	70	\$1,847.18		
MCPHERSON LANDFILL	980034-001	12	\$364.06	\$663.83	\$19,817.81
NIKKLE-EPPS	20100082-001	33	\$845.49		\$8,318.75
PACKARD	970075-00	7	\$190.91		\$310.09
RUDER	970082-00	32	\$782.54		\$12,960.00
RUNNING TURKEY CREEK	20010033-001	20.5	\$547.91		\$61,603.07
RUSSELL CITY	970083-00	22	\$543.40		\$1,192.60
RUSSELL RWD #1	970084-00	19	\$464.30		
SAMPLE	970088-00	9	\$230.82		
SANDER	970089-00	15	\$372.04		
SCHRAEDER	970013-00	7	\$190.91		\$1,590.90
SCHRUBEN-ROGERS	970014-00	18	\$445.48		
SCHULTE	970015-00	262.5	\$6,745.06	\$1,532.34	\$147,927.02
SELZER	970093-00	51.5	\$1,360.82		\$12,133.50
SMITH-FINN	970095-00	9	\$243.49		
SOUTH SPIVEY	970096-00	46	\$1,158.30		
SOUTH WICHITA	970016-00	52	\$1,373.96		\$10,767.02
STOWE-ZAID	20000035-001	14	\$374.94		\$4,057.85
TROSTLE	980038-001	13	\$348.65		
VOSHELL	20030059-001	30	\$795.58	\$302.12	\$19,276.56
WILDBOY'S	970017-00	4.5	\$125.19		
WINGATE	970107-00	40	\$1,058.48		\$8,296.00
YEOMAN	20060021-001	10	\$269.78		\$93,690.76
Totals:		2123.5	\$55,030.17	\$41,287.44	\$1,718,910.36

**REMEDICATION
SITES
REPORT
2015
EXISTING SITES**

Project: Arlington Site

Site Location: The site is located approximately 5 miles west and 1 mile south of Arlington, Kansas. The brine spill, which was the source of the contamination at this site, took place on the Henson lease located in the NE/4 of Section 14, Township 25 South, Range 9 West, Reno County. Rama Operating Company is the Primary Responsible Party, and operator of the Henson lease. The Henson lease has been plugged and abandoned for several years.

Impact/Immediacy: Impacts are to both soil and groundwater as a result of a large saltwater line leak from August 2000. Initially the spill impacted irrigation well in the SE/4 of Section 11 and a domestic well on the lease in late 2001. The domestic well was abandoned and a new one was drilled, and the irrigation well was taken out of use for several seasons allowing the saltwater plume to migrate back to the southeast and be remediated in the NE/4 of Section 14. This site immediacy level should be classified as moderate.

Site Description: The south half of section 11 and northwestern section 13 is cultivated farmland with various crops grown. There is circle irrigation in both the SW/4 and SE/4 of section 11 and the northwest of section 13. The north half of section 14 is in CRP, and the topography is relatively flat with only eleven feet of total relief across the area. The subsurface strata consist of 3 to 4 feet of topsoil and brown clay grading into sands ranging in size from very fine to coarse mixed with clay layers down to the Harper Siltstone, which is the bedrock. Bedrock depths range from 47 to 56 feet. The highest chlorides have been found on the bedrock indicating the clay layers across the area are not contiguous forming aquitards. Depth to water ranges from 13 to 17 feet during non irrigation, and 17+ feet during irrigation. The only visible remnant of the line leak at the surface is a soil scar approximately 100 feet by 40 feet that is located near the center of the NE/4.

Unusual Problems: Water quality must be constantly monitored during summer because of offsetting irrigation wells.

Status of the Project: Since 2001 Rama Operating Company has installed 16 monitoring wells and 8 recovery wells within the area of the Arlington contamination Site. Since late 2010, Rama has been allowed to move the site into post remediation monitoring. Up to this time Rama had utilized the recovery wells in an effort to remediate the immediate groundwater onsite. Annual sampling by KCC has shown that the chloride plume has stayed mainly contained in the NE/4 of section 14, with the highest levels of chlorides found in MW #6 (11,500 mg/L). Bedrock mapping of the Harper Siltstone indicates a slight depression along the bedrock at MW #6, therefore containing the highest concentration of saltwater in this feature.

On October 7, 2014, eight groundwater monitoring wells (MW-1, MW-2, MW-3(D), MW-4, MW-5, MW-6, MW-7, MW-8, MW-9, MW-11, MW-14, MW-15) and the eastern irrigation test well, located in section 13 were gauged and sampled. MW-10 was found to be broken to ground level by an unknown vehicle; it was temporarily sealed in the field for possible future repairs. Prior to sampling, groundwater levels were measured in each monitoring well using an electronic water level indicator. Air-lift technology was used to purge a minimum of three well volumes of groundwater from each well, save MW-15 which was pumped via submersible Proactive® Water-Spout water pump. The irrigation well was bailed three times via hand bailer before sampling. Purge water was tested for conductivity and contained in a 250 gallon poly-tank if conductivity was high before disposed of into a deep injection well. Groundwater samples from each monitoring well were collected in one 250 (ml) polyurethane container for analysis at the KCC District #2 Laboratory. Each sample for this monitoring event was analyzed for the presence of Chloride by United States Environmental Protection Agency USEPA Silver Nitrate Buret Titration Method - Method 8225


Level of Remediation Sought:

- Ideal:** 30 to 80 ppm (background)
- Target:** 250 ppm


Recommendation for Future Work: It will be suggested to Rama Operating Company, to reactivate Recovery Well No. 8, and any other recovery wells adjacent to MW #6 in an effort to expedite the remediation efforts since natural attenuation will not likely occur anytime soon. RW 8 is the closest recovery well to the “hot spot” in plume, and should have a positive effect on chloride levels. MW-10 will need to be repaired if possible and a plan for the work is scheduled for the winter of 2015.

Estimated Total Cost: \$2500 for Annual Groundwater sampling and well repairs. Staff time will include performing reviews and research into reports remediating the Site.

Control No.	Staff Hours/Expenditures	Fund Expenditures	
		FY 2014/15	Total
20030016-001	22 Hrs. / \$585.26		
Current Contaminate Level: 11,500 mg/l in MW-6			
<input type="checkbox"/> 1. Site Assessment	<input type="checkbox"/> 2. Short Term Monitoring	<input type="checkbox"/> 3. Investigation	
<input type="checkbox"/> 4. Long Term Monitoring	<input type="checkbox"/> 5. Remediation Plan	<input type="checkbox"/> 6. Installation	
<input checked="" type="checkbox"/> 7. Remediation	<input checked="" type="checkbox"/> 8. Post Rem. Monitoring	<input type="checkbox"/> 9. Resolved	

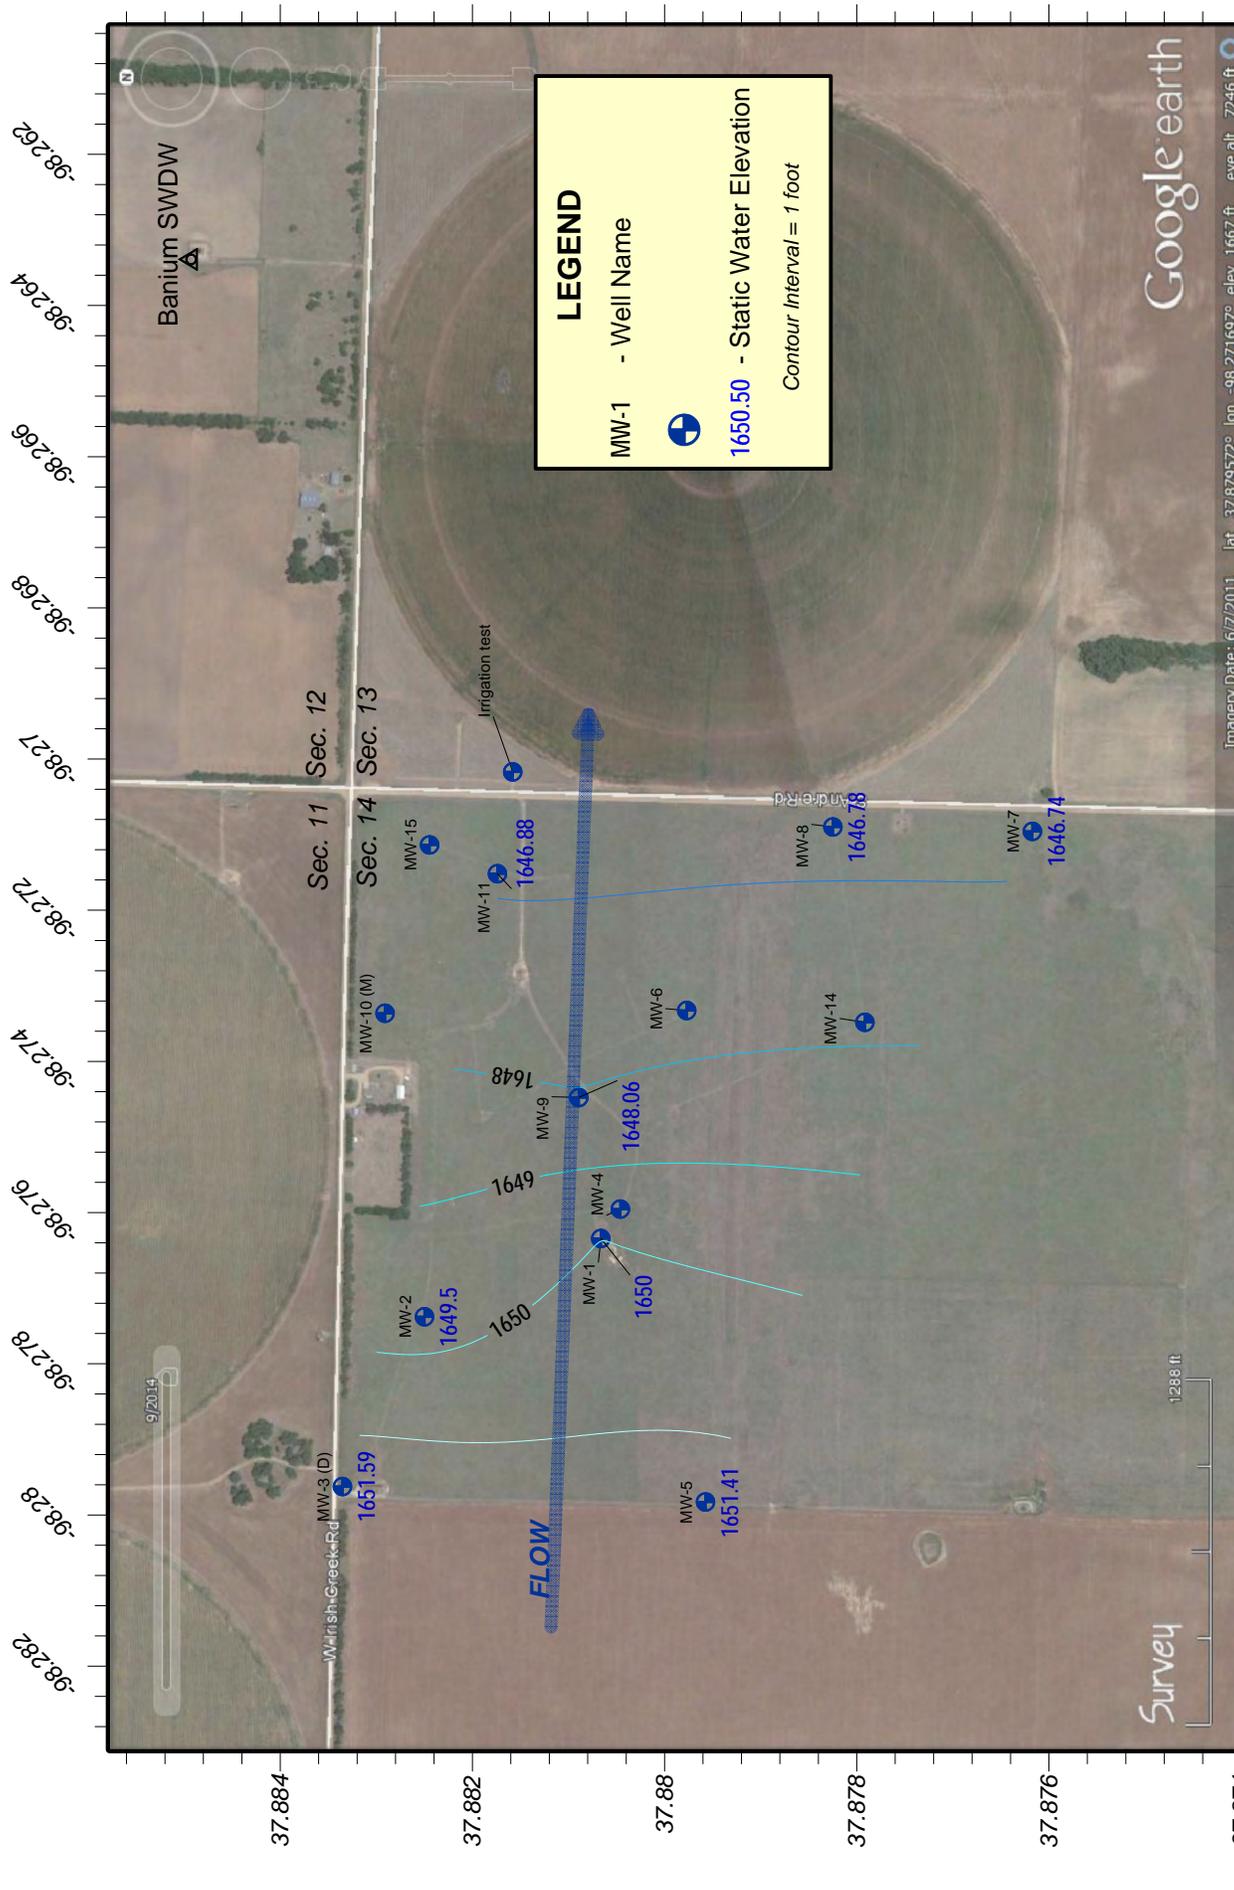


Arlington Contamination Site
 Section 14 - Township 25 South - Range 9 West, Reno County, Kansas
2014-15 Groundwater Elevation Levels
 KCC Project code #20030016-001 - KCC District #2 Field Office
 Well Gauged on 10/7/2014 - Map Drawn on 10/29/2014 by D. Bollenback

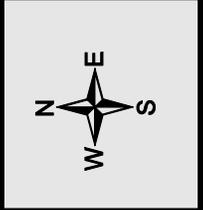


Imagery Date: 6/7/2011 | lat: 37.879572° | lon: -98.271697° | elev: 1667 ft. | eye alt: 7246 ft.

98.282 98.278 98.276 98.274 98.272 98.27 98.268 98.266 98.264 98.262

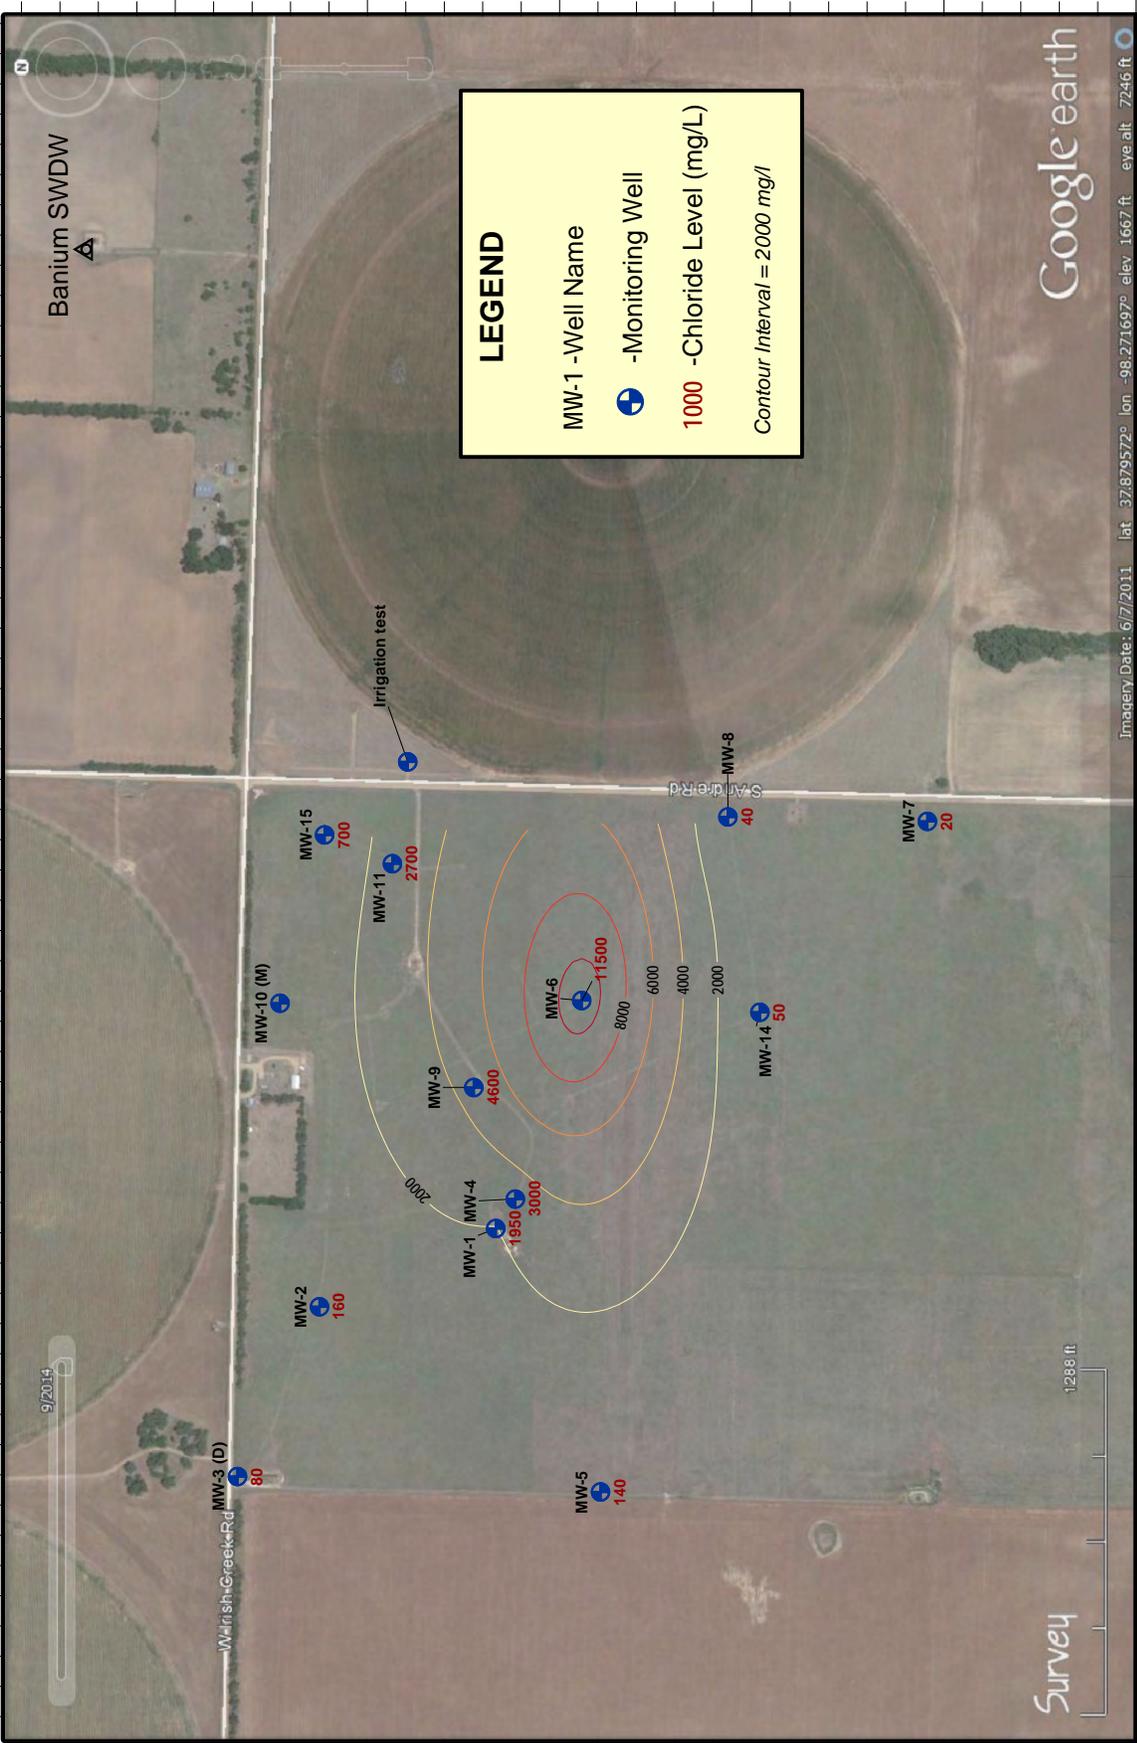

Arlington Contamination Site
 Section 14 - Township 25 South - Range 9 West, Reno County, Kansas
2014-15 Chloride Concentration
 KCC Project code #20030016-001 - KCC District #2 Field Office
 Well Sampled on 10/7/2014 - Map Drawn on 10/29/2014 by D. Bollenback

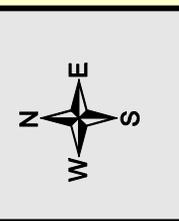

Google earth

Survey

Imagery Date: 6/7/2011 lat: 37.879572° lon: -98.271697° elev: 1667 ft. eye alt: 7246 ft

Project: Gil Balthazor Contamination Site

Site Location: Section 23 of Township 9 South, Range 21 West, Graham County.

Impact/Immediacy: Pollution from past oil field activity has impacted an aquifer which supplies all domestic water to a homestead. The immediacy level is rated as low due to concentration, and water use habits of the residents.

Site Description: At the time that the site was listed, a well in section 14 was the sole source of water for the residence, but this well is no longer utilized by the landowner, though the chloride concentration was at 600 ppm when it was last tested in 2002. The sole source of domestic water for the residence is a shallow water well in a gentle draw to the south in section 23. The quarter that the water well is located in has three oil wells that are dry and abandoned, four that are plugged and abandoned, and four producers. The majority of these wells were originally drilled in the 1940's

Unusual Problems: None

Status of Project: When the new domestic well was drilled in 2011, the chloride level was 2300 ppm. In 2012 the chloride levels in the new well tested at 1700 ppm chlorides, and the downward trend continued through 2013, when the chloride concentration had dropped to 700 ppm, and into 2014, when the water sample contained chloride levels of 600 ppm. The three monitoring wells on the location have remained relatively stable with a subtle overall decrease in contamination. Their contamination levels are 1400 ppm in monitoring well #1, 1500 ppm in monitoring well #2, and 60 ppm in monitoring well #3.

Level of Remediation Sought:


Ideal: 250 ppm Chloride

Target: 250 ppm Chloride

Recommendations for Future Work: The source of the contamination is likely an old brine pit in the NW/4 of Section 23, T.9S. R.21W., however the site parameters do not warrant a full remedial effort. The contamination level will continue to be monitored, and the feasibility of decreasing the contamination level by pumping groundwater to waste will be considered.

Estimated Total Costs: \$10,000.00

Control No.	Staff Hours/Expenditures	Fund Expenditures	
		FY 2014/15	Total
970023-00	32 Hrs. / \$771.22		
Current Contaminate Level: 60 ppm to 1,500 ppm Cl⁻			
Status:			
<input type="checkbox"/> 1. Site Assessment	<input type="checkbox"/> 2. Short Term Monitoring	<input type="checkbox"/> 3. Investigation	
<input checked="" type="checkbox"/> 4. Long Term Monitoring	<input type="checkbox"/> 5. Remediation Plan	<input type="checkbox"/> 6. Installation	
<input type="checkbox"/> 7. Remediation	<input type="checkbox"/> 8. Post Rem. Monitoring	<input type="checkbox"/> 9. Resolved	

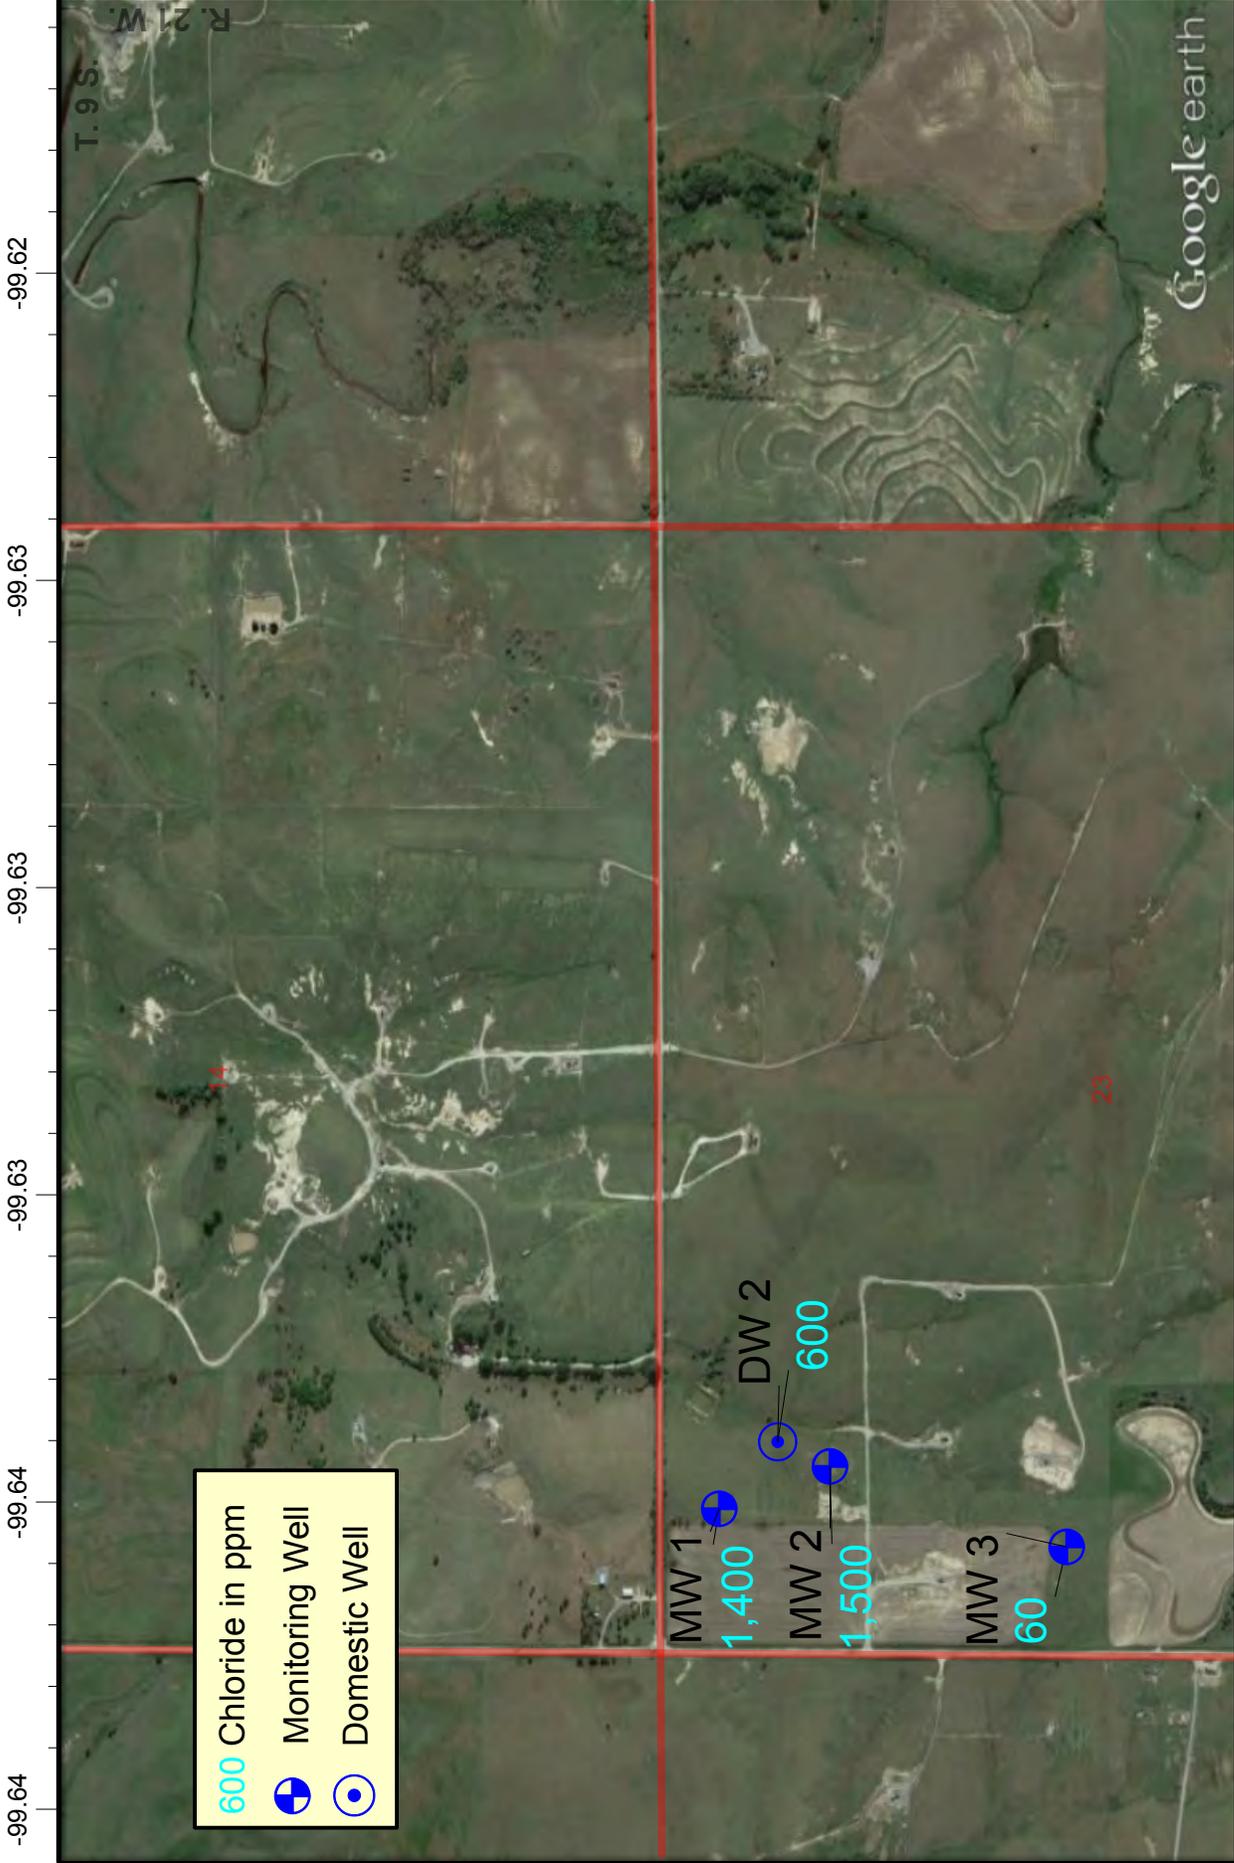

Balthazor Groundwater Monitoring Site
 Section 23 of Township 9 South, Range 21 West, Graham County, Kansas
 2014 Groundwater Chloride Levels
 District #4 - Sampled 5/29/2014 and 8/19/2014 - Map Drawn on 8/22/2014 by C. Neeley



Project: *Brazil Contamination Site*

Site Location: Section 27, Township 28 South, Range 18 East, Neosho County.

Impact/Immediacy: Chloride contamination at this site has verified impacts to both surface water and soil resources with a strong potential for ongoing impact to groundwater resources. The immediacy level is rated as low to moderate for water resources and low to moderate for soil resources.

Site Description: The site consisted of an abandoned oil lease with 30 abandoned wells. Surface runoff over areas of past brine spillage and near surface leakage from abandoned wells is affecting both surface water and soil resources. The surface drainage through this lease is a minor tributary to the Neosho River, which is a public water supply source.

Unusual Problems: None.

Status of Project: The Fee Fund Plugging Project for this lease was completed in early spring of 1999. Twenty-three wells were plugged while seven of the wells were determined to already have been plugged. Four new monitoring wells were constructed in early 2012. These wells were specifically located to further determine the extent and possible source area of the chlorides impacting the area groundwater and surface soils. This property has also been leased by Quest Cherokee and six new gas wells have been drilled in this section since 2006. Some drainage modifications have been implemented by Operator. The following sample results were obtained this year on: **02/18/2014:** Well #MW01; 1,500 ppm Cl-; Well # MW02; 1,400 ppm Cl- ; Well # MW03; 400 ppm Cl- and Well # MW04; 1,600 ppm Cl- . On **08/20/2014:** Well #MW01; 1,400 ppm Cl-; Well # MW02; 1,400 Cl-; Well #MW03; 400 ppm Cl- and Well # MW04; 1,500 ppm Cl- . Overall CL- concentrations continue to trend down slightly for the year.

Level of Remediation Sought:


Ideal: 250 ppm Chloride

Target: 500 ppm Chloride

Recommendation for Future Work: Future work at the site, beyond possible plugging operations, will include collection of additional data from the newly constructed monitoring wells and possible construction of additional monitoring wells. Additional field work to locate possible unplugged abandoned wells or old wells in which the initial plugs have failed. This information will assist in determining the location and extent of the brine impact. All work will need to be coordinated with the current Operator.

Estimated Total Cost: Plugging cost for this site totaled \$57697.10. Monitoring Well Construction completed in early 2012 totaled \$8,196.00.

Control No.	Staff Hours/Expenditures	Fund Expenditures	
		FY 2014/15	Total
990040-001	65.5 Hrs. / \$1,728.88		\$10,767.25
Current Contaminate Level: 400 ppm to 1,600 ppm Cl-			
Status:			
<input type="checkbox"/> 1. Site Assessment	<input type="checkbox"/> 2. Short Term Monitoring	<input checked="" type="checkbox"/> 3. Investigation	
<input checked="" type="checkbox"/> 4. Long Term Monitoring	<input type="checkbox"/> 5. Remediation Plan	<input type="checkbox"/> 6. Installation	
<input type="checkbox"/> 7. Remediation	<input type="checkbox"/> 8. Post Rem. Monitoring	<input type="checkbox"/> 9. Resolved	

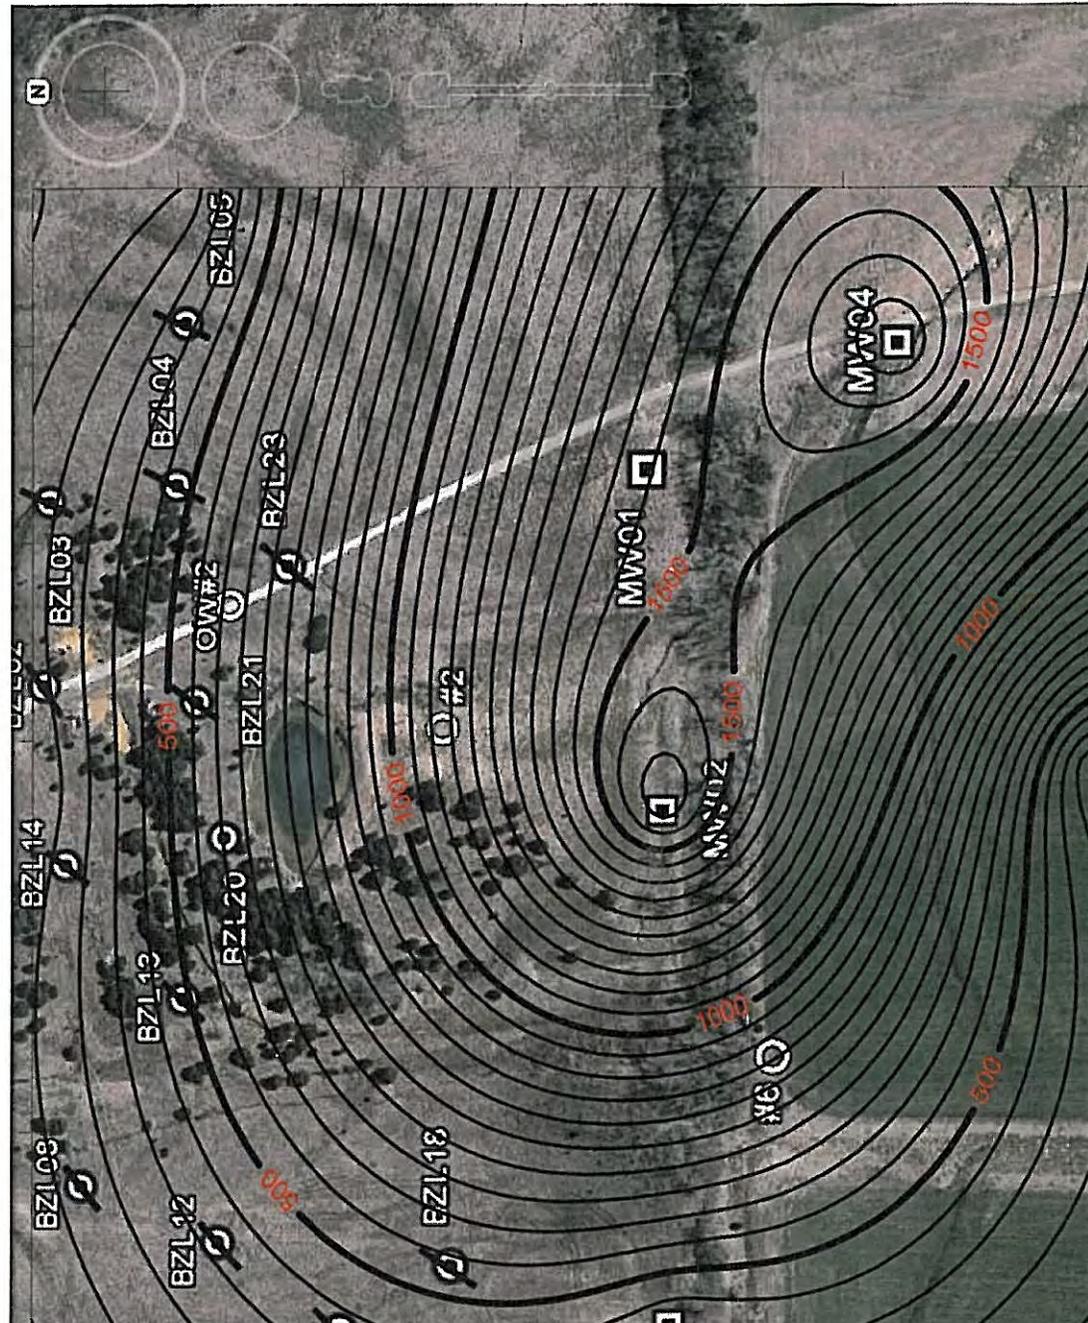

- Active CBM Well
- Free Fund Plugged Well
- Possible Well Location / Historical Documents / No Surface Evidence
- Monitoring Well
- Cl- Concentration Contour = 50 ppm

KANSAS CORPORATION COMMISSION
 Brazil Remediation Site
 E 1/2 Sec 27 - T28S - R18E
 Neosho County, Kansas
 Project 990040-001

11/20/2014 District 3



Project: *Brothers Contamination Site*

Site Location: This contamination site is located nine miles east, two and one half miles north of Sterling. The legal location is S/2 NE of Section 12, Township 21 South, Range 7 West, Rice County, Kansas.

Impact\Immediacy: Low immediacy. The only water wells within one mile are to the southwest and were drilled in the 1980s as oil field supply wells.

Site Description: The site is located in the Sand Hills of Rice County. The groundwater aquifer is a shallow permeable zone consisting of loose fine-grained sand underlain by a thick clay layer. The groundwater flow is to the south-southwest.

Unusual Problem: Monitoring wells onsite have shown that the aquifer has low deliverability.

Status of Project: KCC visited the site and collected water samples on June 20th, 2014. KCC laboratory results of the three monitoring wells show that chloride levels are stable in all the wells. MW-2 is screened in the lower aquifer and was still below 100 ppm chlorides. A sample was taken at the pond this year and was tested at 500 ppm chlorides. Frogs and other biota were witnessed in the pond.

Level of Remediation Sought:



Ideal: 250 mg/l Chloride

Target: 500 mg/l Chloride

Recommendations for Future Work: KCC recommends that the site remain in the monitoring phase due to the lack of priority of the site. In the future KCC recommends that a Geoprobe[®] rig be used to probe the area surrounding the site. Probe work could indicate whether or not the chloride contamination is still high in the old drilling pit area. Probe work could also show whether or not this chloride contamination is part of a larger chloride situation from past oil field activities. Data found from a probing event could be used to help plan on a time table for site closure or help indicate other avenues of remediation in order to hasten clean up.

Estimated Total Costs: \$750 for monitoring, research and report writing. Geoprobe work would cost around \$4000.

Control No.	Staff Hours/Expenditures	Fund Expenditures	
		FY 2014/15	Total
970029-00	11 Hrs / \$296.07		\$4.26
Current Contaminate Level: 60 mg/l to 1900 mg/l Chloride			
Status:			
<input type="checkbox"/> 1. Site Assessment	<input type="checkbox"/> 2. Short Term Monitoring	<input type="checkbox"/> 3. Investigation	
<input checked="" type="checkbox"/> 4. Long Term Monitoring	<input type="checkbox"/> 5. Remediation Plan	<input type="checkbox"/> 6. Installation	
<input type="checkbox"/> 7. Remediation	<input type="checkbox"/> 8. Post Rem. Monitoring	<input type="checkbox"/> 9. Resolved	

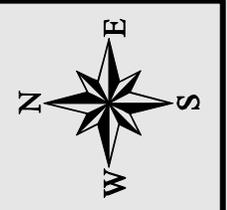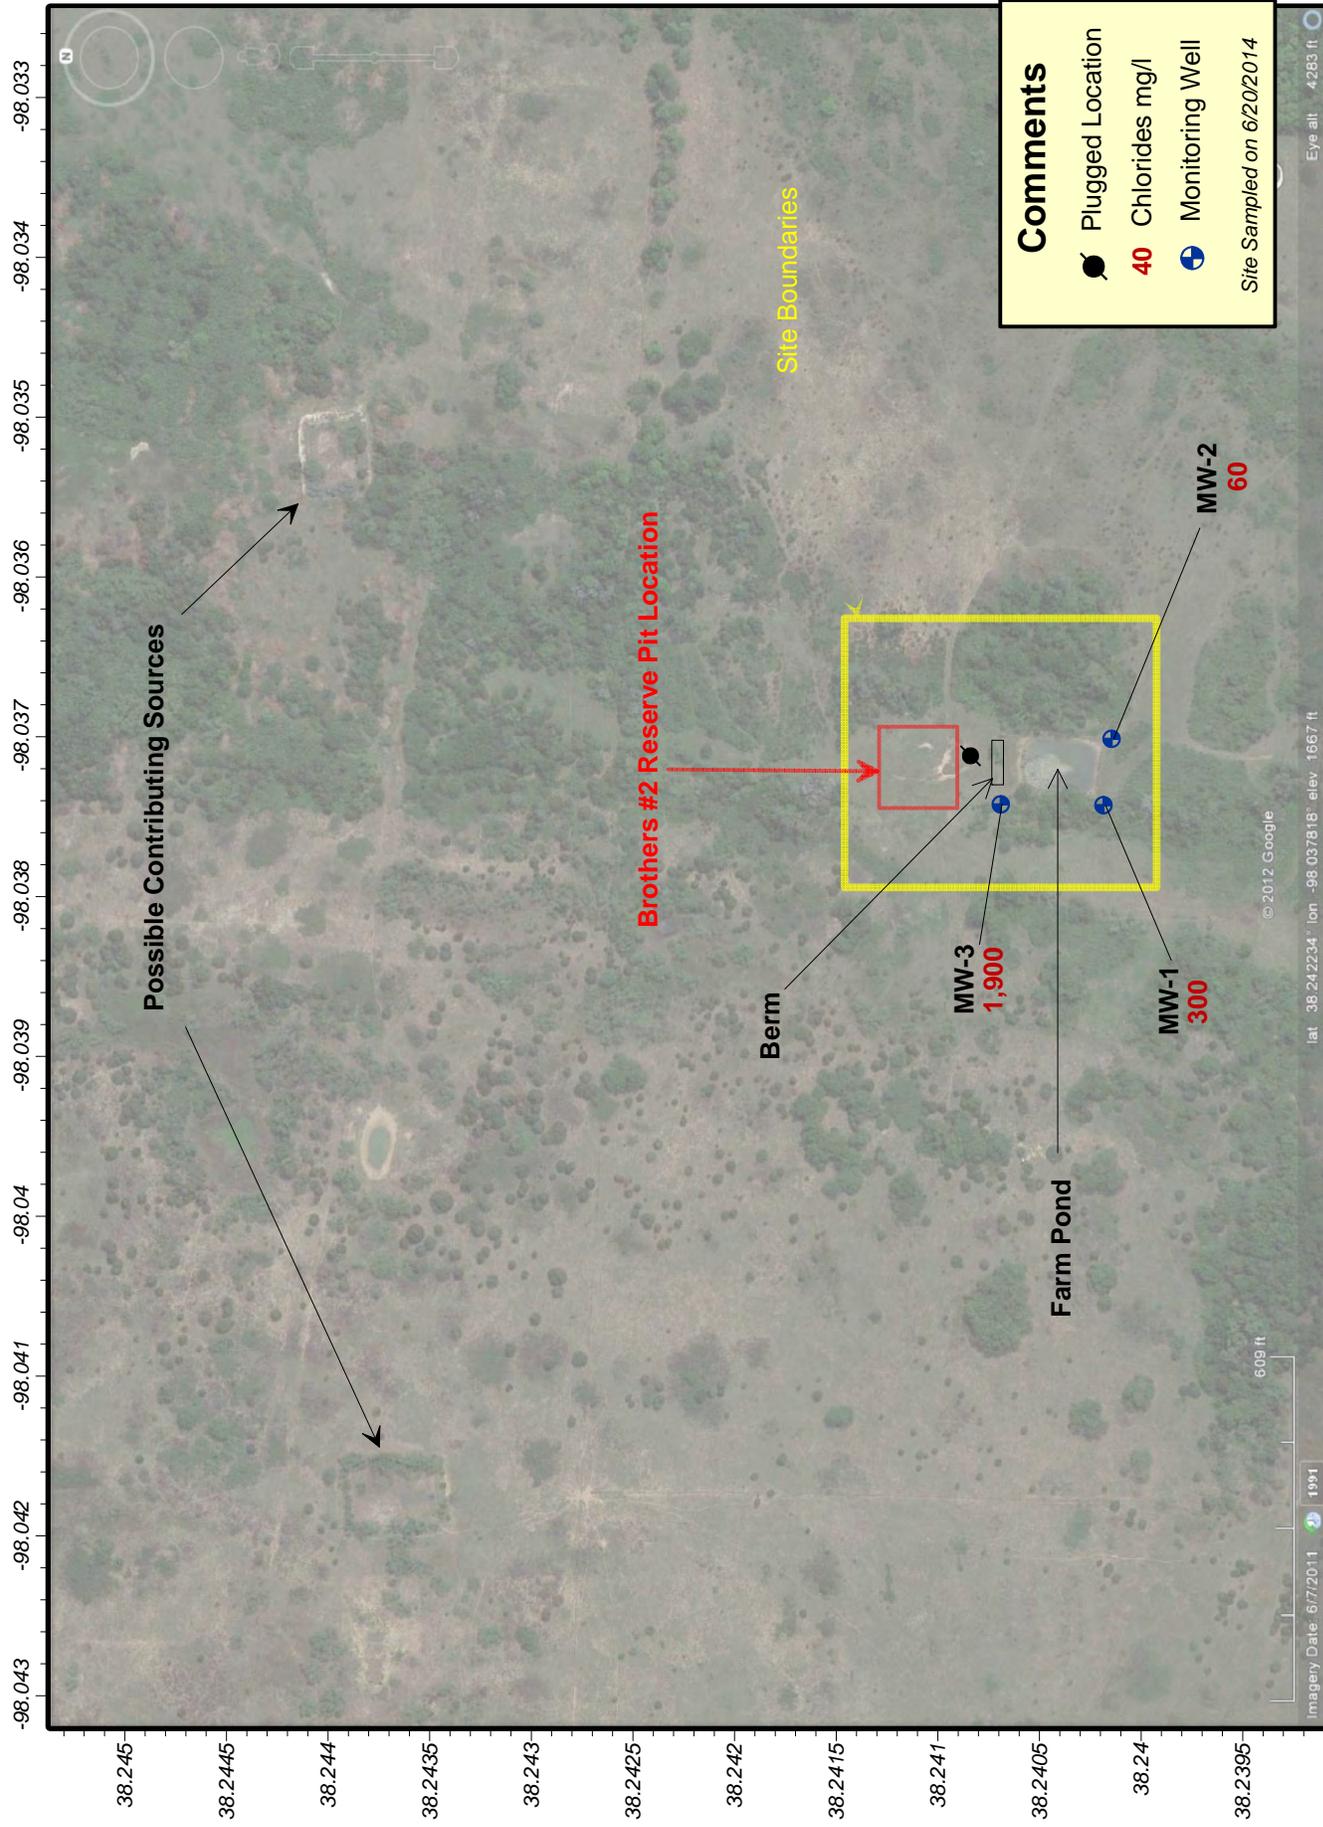

Brothers Contamination Site
 S/2 NE of 12-T21S-R7W - Rice County

2014 Annual Groundwater Sampling Event - Chloride Levels
 KCC Code #970029-00 - District #2 - D. Bollenback - Drawn: 11/5/2014



Project: Burrton Contamination Site

Site Location: The site is located in western Harvey County and eastern Reno County approximately 18 miles west of the city of Newton and 12 miles east of the city of Hutchinson. The site includes acreage in Townships 23 and 24 South, Ranges 3 and 4 west.

Impact/Immediacy: Presently the contamination site is affecting local domestic and irrigation wells. Hydrogeologic computer modeling shows portions of the plume will intercept parts of the Wichita Well Field within 50 years. The Equus Beds aquifer is a major source of public water supply for much of the population of Sedgwick County. This case is ranked at a very high level of immediacy based on the resource impacted and the size of the site.

Site Description: Total maximum area affected by the contamination covers approximately 25 to 30 square miles. In general, the contaminate plume is aligned in a northeast to southwest configuration parallel with the associated producing areas. A water quality-sampling network maintained by the local groundwater management district indicates oil field brine contamination of all three major zones within the Equus Beds Aquifer. Depth to groundwater ranges from 10 to 35 feet with saturated thickness in the order of 150 to 250 feet.

Unusual Problems: The need of suitable disposal facilities and the large area extent of the plume make the clean up of this site very costly. The physical day-to-day maintenance and monitoring of a withdrawal and disposal system of this size would require a large commitment of labor and resources. In addition, over pumping the aquifer as part of a remediation plan for oilfield brine could cause natural chlorides to migrate from the Arkansas River into the Equus Beds, thus impacting parts of the aquifer that are not contaminated.

Status of the Project: GMD #2 sampled the monitoring wells in the summer of 2014. This site is currently in monitoring status in the KCC but other entities are actively attempting to remediate the contamination problem. District #2 continues to investigate private groundwater wells in the area. The USGS put out a Scientific Investigations report regarding the Plume and the city of Wichita's ASR project in 2014. The A zone showed very little change with some chloride flux along the known higher level fronts. The B Zone shows slight increases to the SE at EB14 and EB15, which is expected as they are along the down gradient path. The lower C zone shows no major changes and could be described as relatively stable over the last year.

Level of Remediation Sought:


Ideal: 250 mg/l Chloride

Target: Considering the variable conditions within the aquifer different areas within the contaminate plume would need to be evaluated separately during cleanup to insure that fresh and usable water is not being disposed of needlessly.

Recommendations for Future Work: Continue funding of annual water well sampling and analysis of this critical data. KCC will continue to review data for locations for possible additional wells to help delineate the plume. Open communication with the USGS, City of Wichita, and GMD #2 regarding data exchange and future cooperation is essential for the study and remediation of this problem. KCC will concentrate research into high level A Zone plumes to investigate the possibly of remedial action in smaller areas of contamination.


Estimated Total Cost: Cost associated with funding the sampling done by GMD #2, along with KCC staff research and report preparation. KCC Staff attends many meetings and conferences regarding the work being done regarding this site and will continue to do so.

Control No.	Staff Hours/Expenditures	Fund Expenditures	
		FY 2014/15	Total
970003-00	33.5 Hrs. / \$862.26	\$4,229.68	\$320,247.99
Current Contaminate Level: 2 mg/l EB22A to 1650 mg/l Cl- EB4C/4B			
Status:			
<input type="checkbox"/> 1. Site Assessment	<input type="checkbox"/> 2. Short Term Monitoring	<input type="checkbox"/> 3. Investigation	
<input checked="" type="checkbox"/> 4. Long Term Monitoring	<input checked="" type="checkbox"/> 5. Remediation Plan	<input type="checkbox"/> 6. Installation	
<input type="checkbox"/> 7. Remediation	<input type="checkbox"/> 8. Post Rem. Monitoring	<input type="checkbox"/> 9. Resolved	

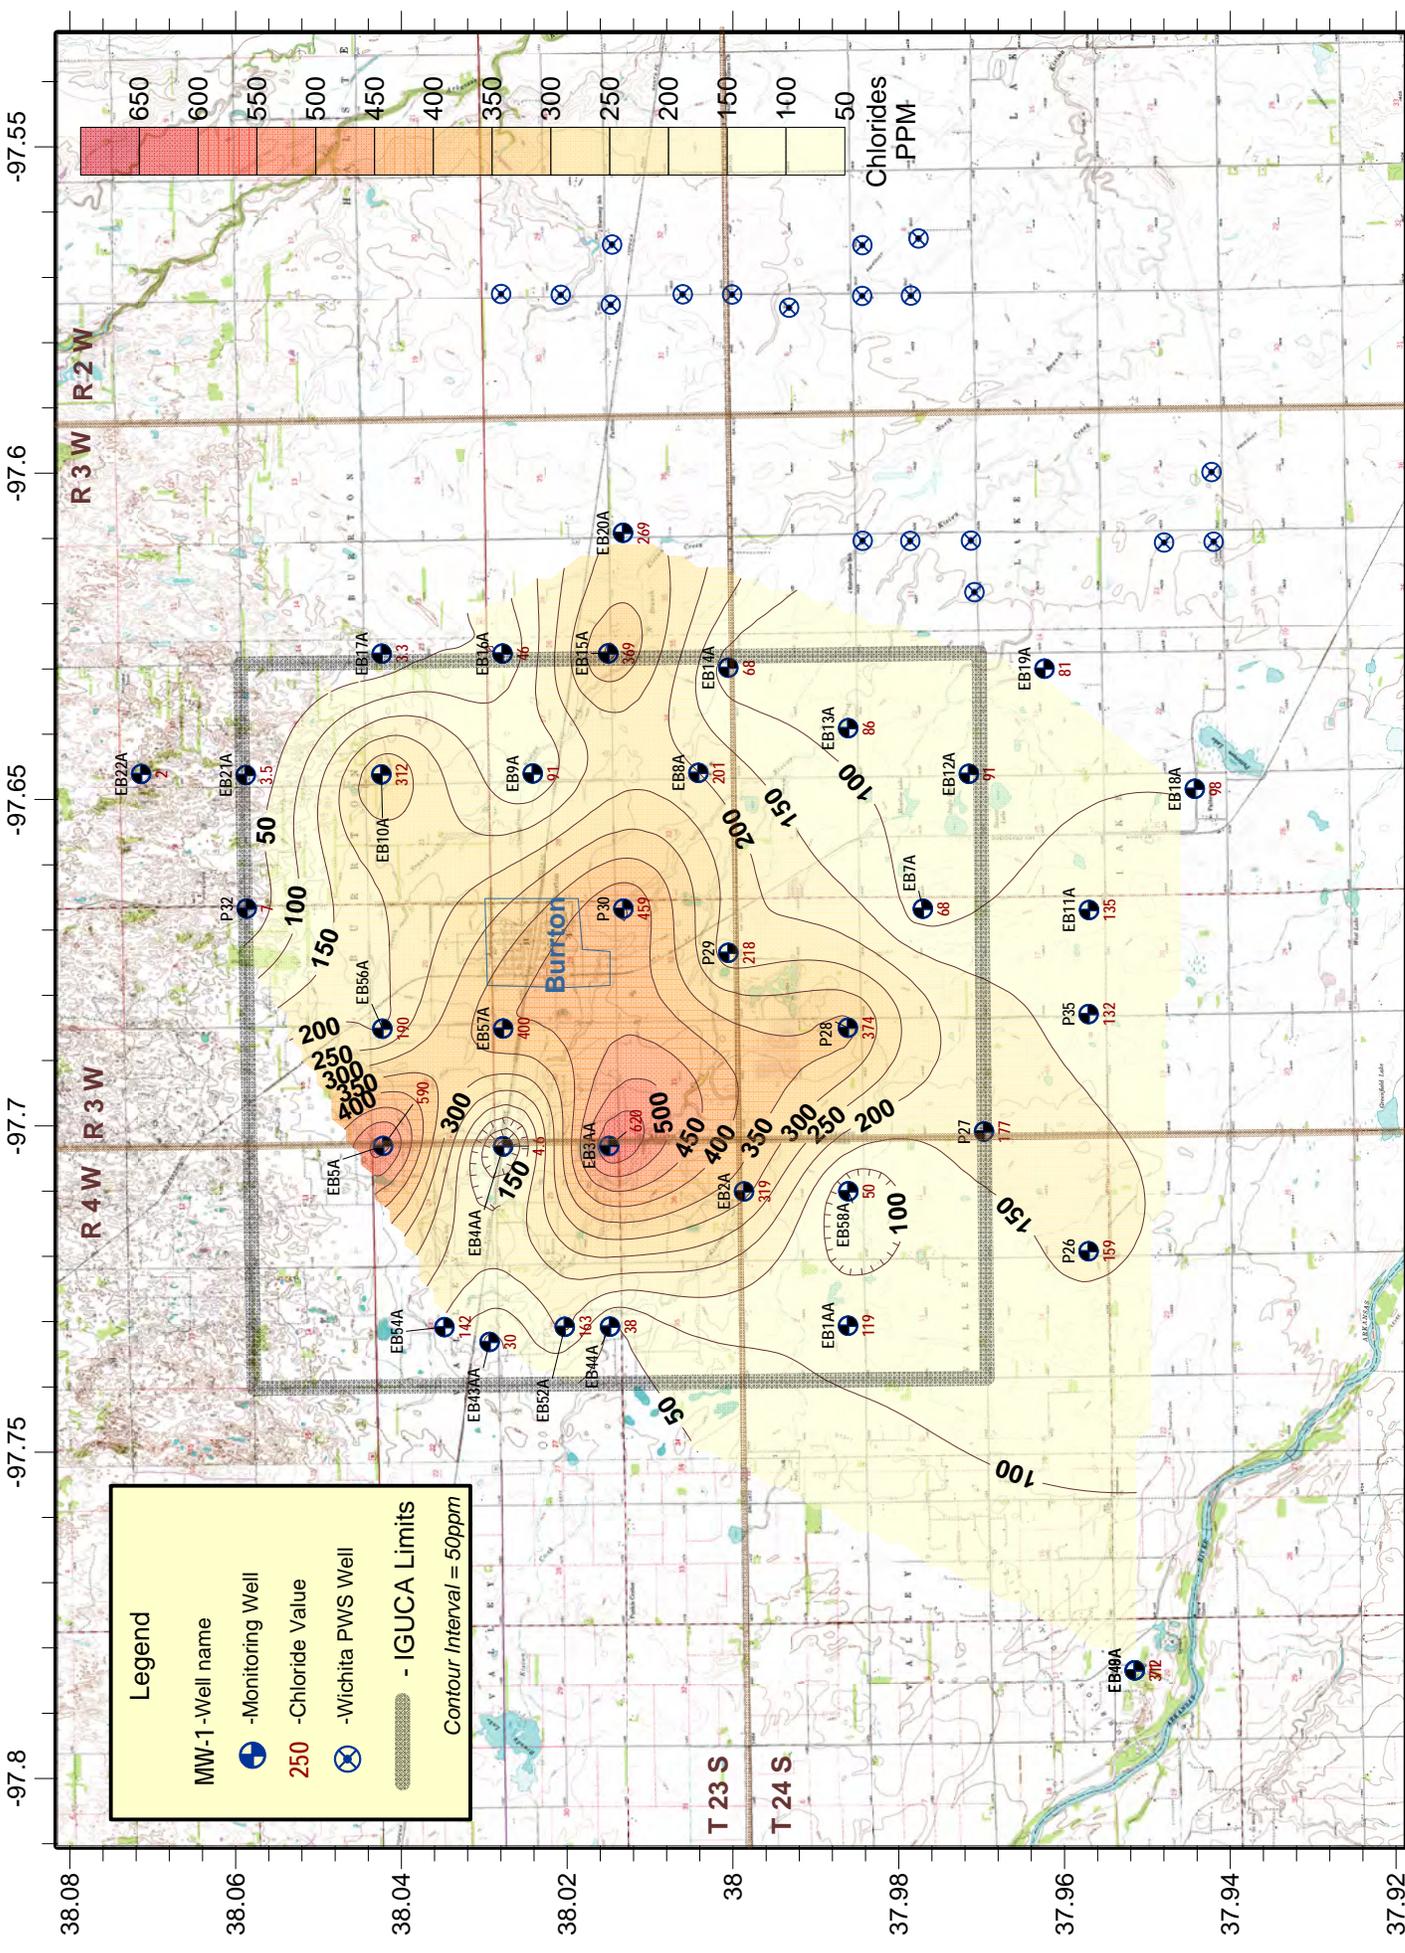


Legend


- MW-1 - Well name
- Monitoring Well
- 250 - Chloride Value
- Wichita PWS Well
- IGUCA Limits
- Contour Interval = 50ppm

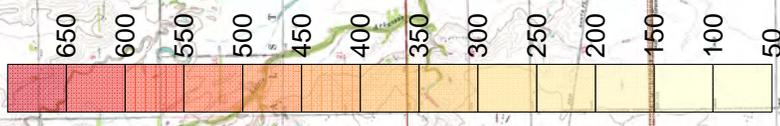

Burton IGUCA Brine Contamination Field
A Zone Chloride Map Showing GMD#2 Groundwater Well Data from 2014
 Reno and Harvey Counties, Kansas
 KCC Project Code #970042-00 - KCC District #2 Field office - Map drawn on 10/14/2014 by D. Bollenback



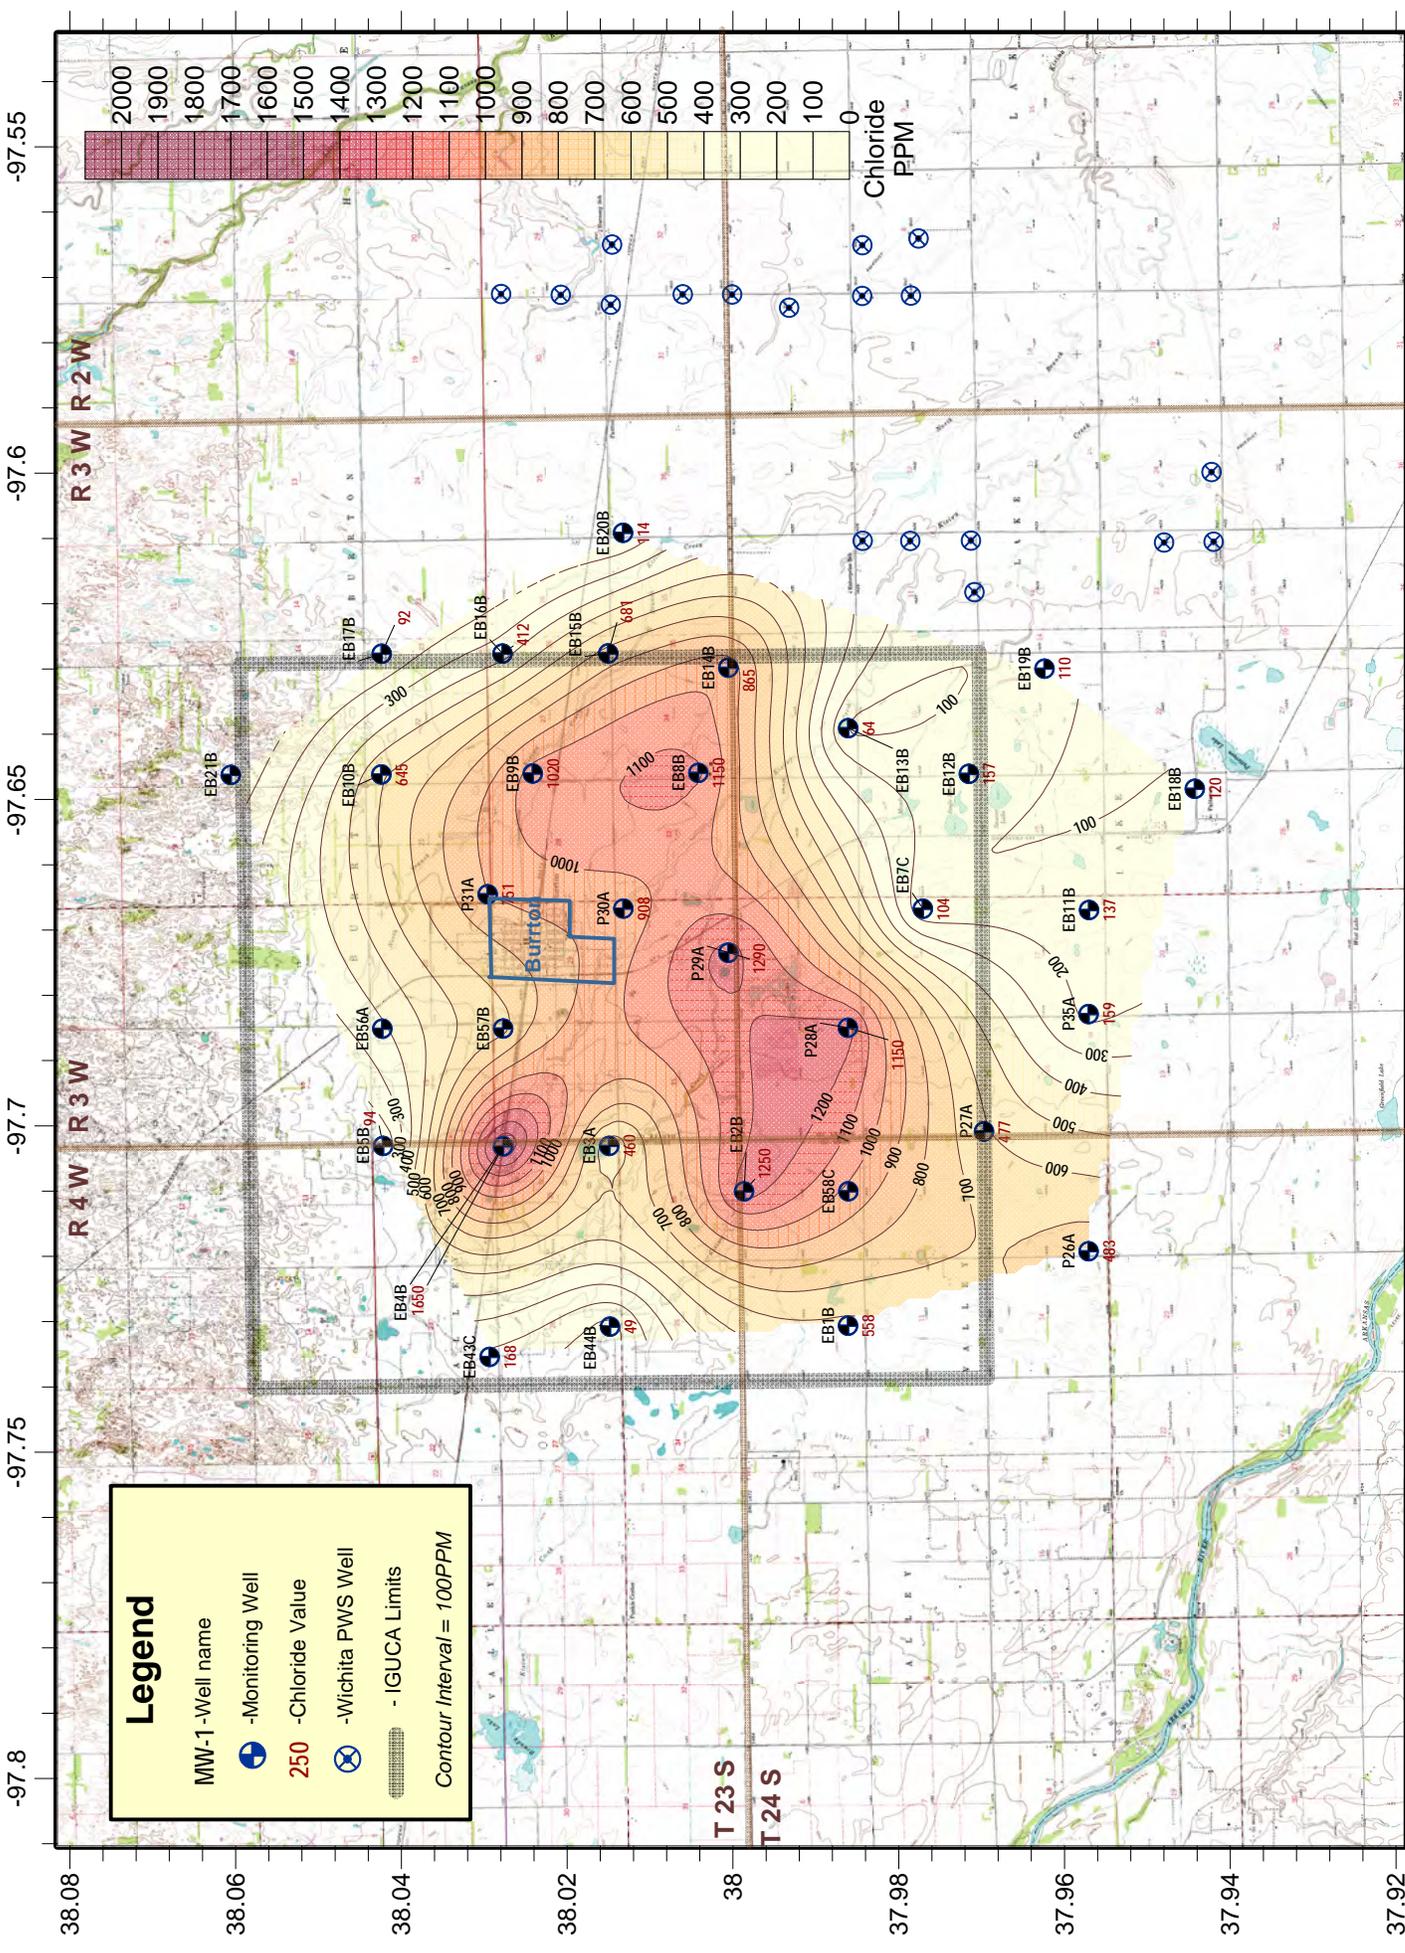

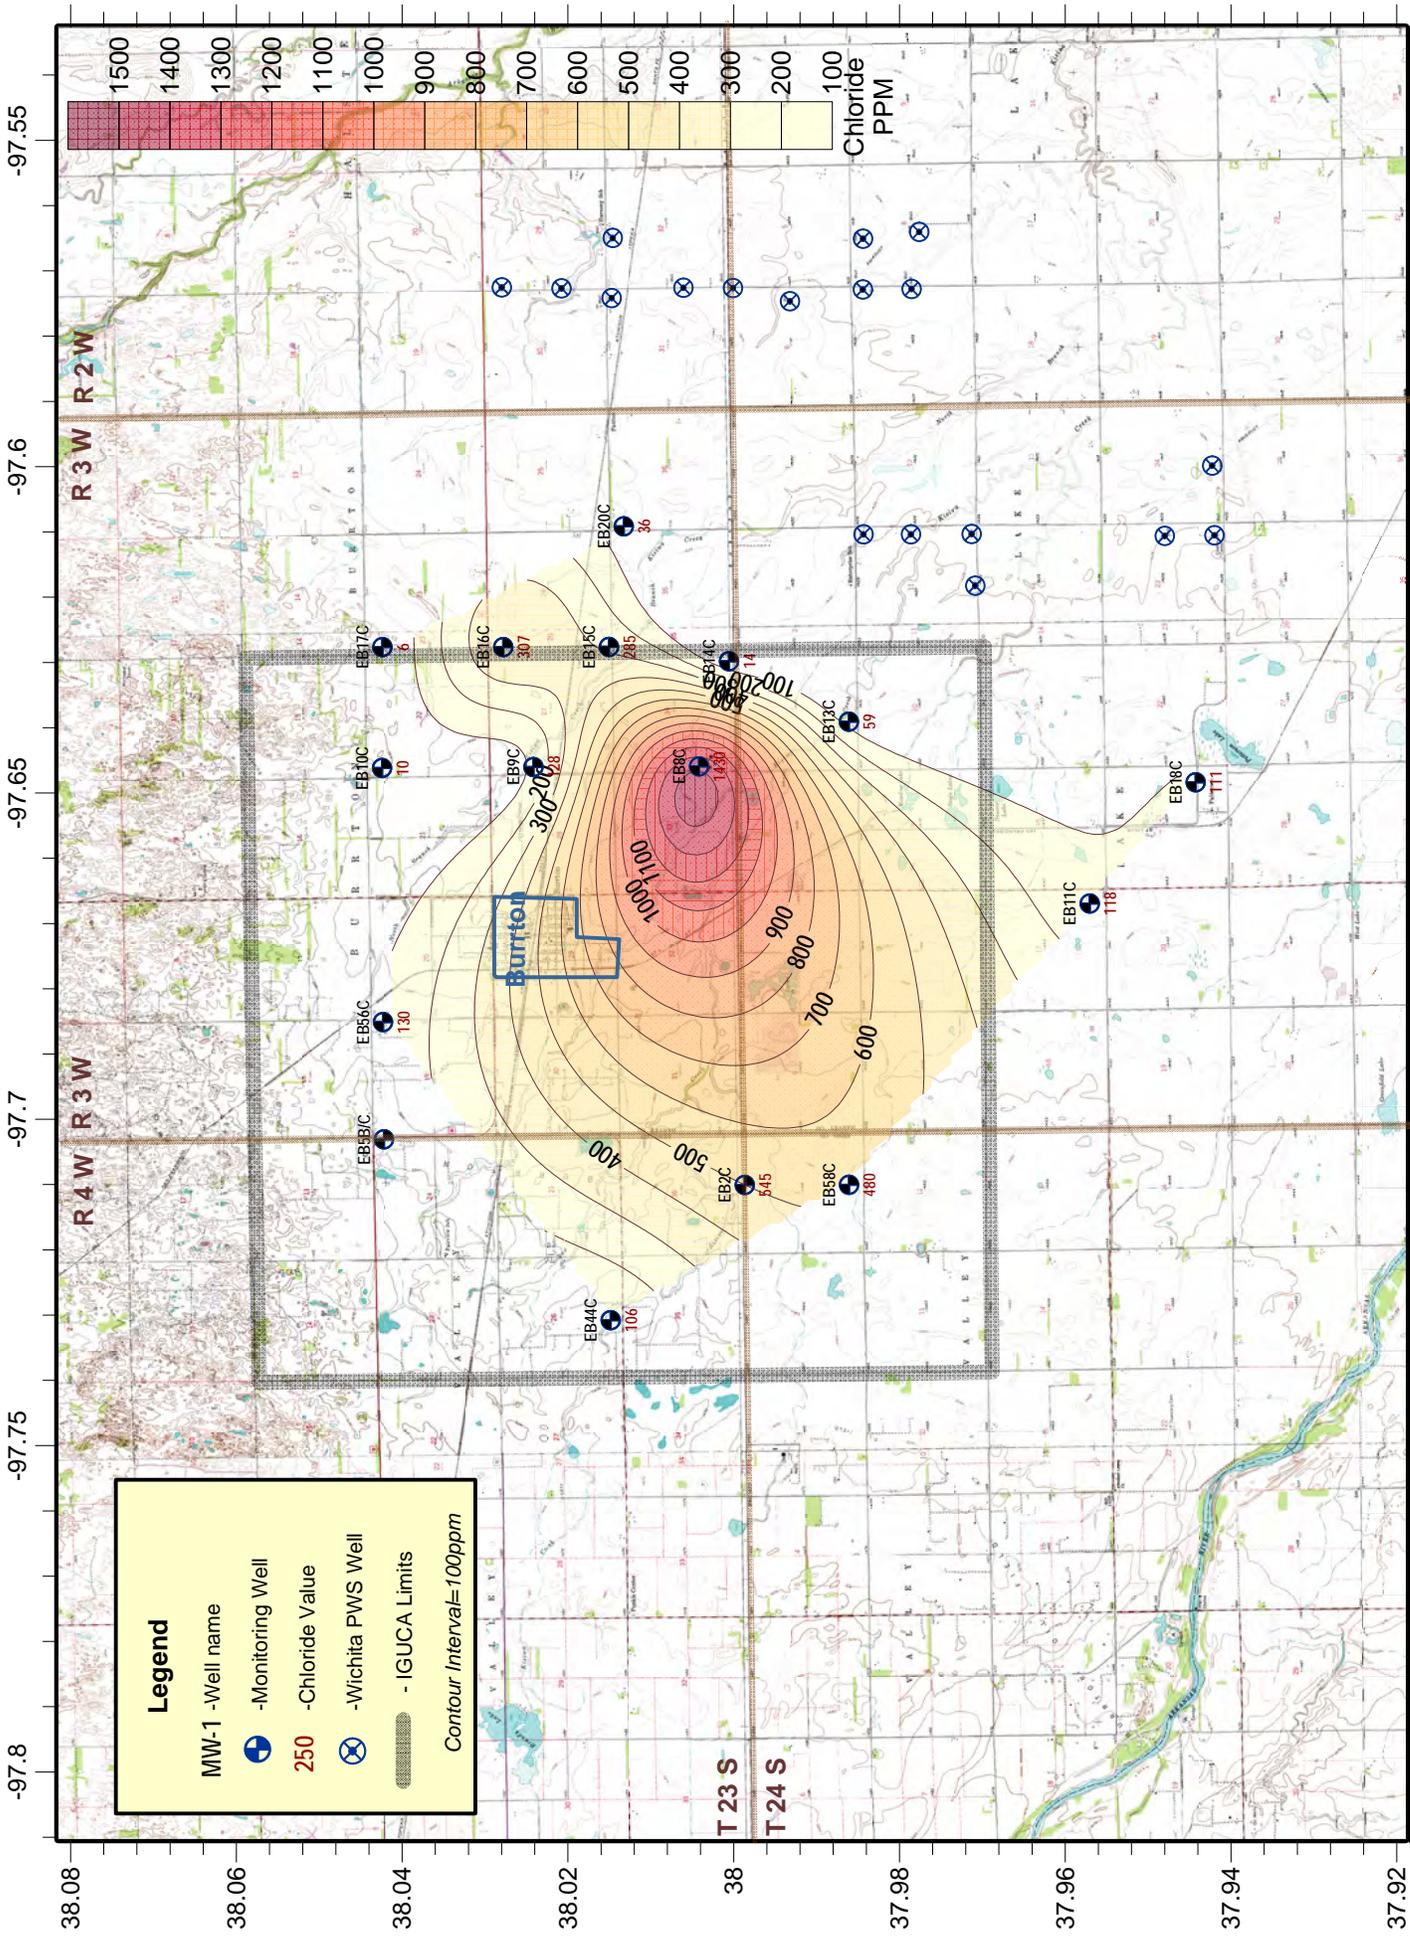

Project: Clawson Contamination Site

Site Location: Legal location is East half of Section 33 and all of Section 34, Township 29 South, Range 34 West, Haskell County.

Impact/Immediacy: Irrigation well is contaminated and a pollution threat to other irrigation wells if contaminate is not contained to site. Site immediacy is rated at moderate to high and is under remediation at the present time by the PRP.

Site Description: The site consists of a plume of brine-contaminated groundwater moving in an easterly direction. Area is blanketed by 500 feet of Ogallala sand and gravel. Bedrock underlying the Ogallala is the Dakota/Cheyenne formation. There is a total of 600 feet of freshwater bearing strata. Pollution occurs along a clay layer 360 feet below the surface (in the upper part of the freshwater aquifer). No domestic wells in the affected area. One irrigation well is currently polluted to the extent it cannot be used for irrigation purposes. Depth to groundwater is 300 feet. Depth to Cretaceous bedrock is 510 feet in the center of the SW/4 of Section 34. The Red Beds underlie the three aquifers at a depth of 635 feet.

Unusual Problems: High yield rates of the Ogallala formation and ongoing severe drought.

Status of Project: The Clawson remediation project conducted a six month rebound test where all recovery efforts were shut down for a six month period. Annual sampling was conducted on August 4-5 2014 by DBS&A Inc. The results showed a continuing decline or leveling off of chloride concentrations. One monitoring well and four recovery wells continue to have levels above the usable water level of 500 ppm. Chlorides continue to decrease in all six recovery wells. It was decided that recovery effort cease and 17 recovery and monitoring wells would be plugged and abandoned while 7 wells would be used in as monitoring wells for annual sampling.

Level of Remediation Sought:

Ideal: 250 ppm Chloride

Target: 500 ppm Chloride

Recommendations for Future Work: The 17 recovery and monitoring wells be plugged by a licensed water well drilling company at the recommendation of the KCC. The 7 wells continue to be monitored until target concentrations are met. All of these expenses will be covered by the PRP and will only happen with the consent of the KCC.

Estimated Total Costs: KCC - \$450 a year. PRP – in excess of \$2 million.

Control No.	Staff Hours/Expenditures	Fund Expenditures	
		FY 2014/15	Total
970005-00	8 Hrs. / \$213.58		
Current Contaminate Level: 42.1 ppm Cl- to 1,480 ppm Cl-			
Status:			
<input type="checkbox"/> 1. Site Assessment	<input type="checkbox"/> 2. Short Term Monitoring	<input type="checkbox"/> 3. Investigation	
<input checked="" type="checkbox"/> 4. Long Term Monitoring	<input type="checkbox"/> 5. Remediation Plan	<input type="checkbox"/> 6. Installation	
<input type="checkbox"/> 7. Remediation	<input type="checkbox"/> 8. Post Rem. Monitoring	<input type="checkbox"/> 9. Resolved	

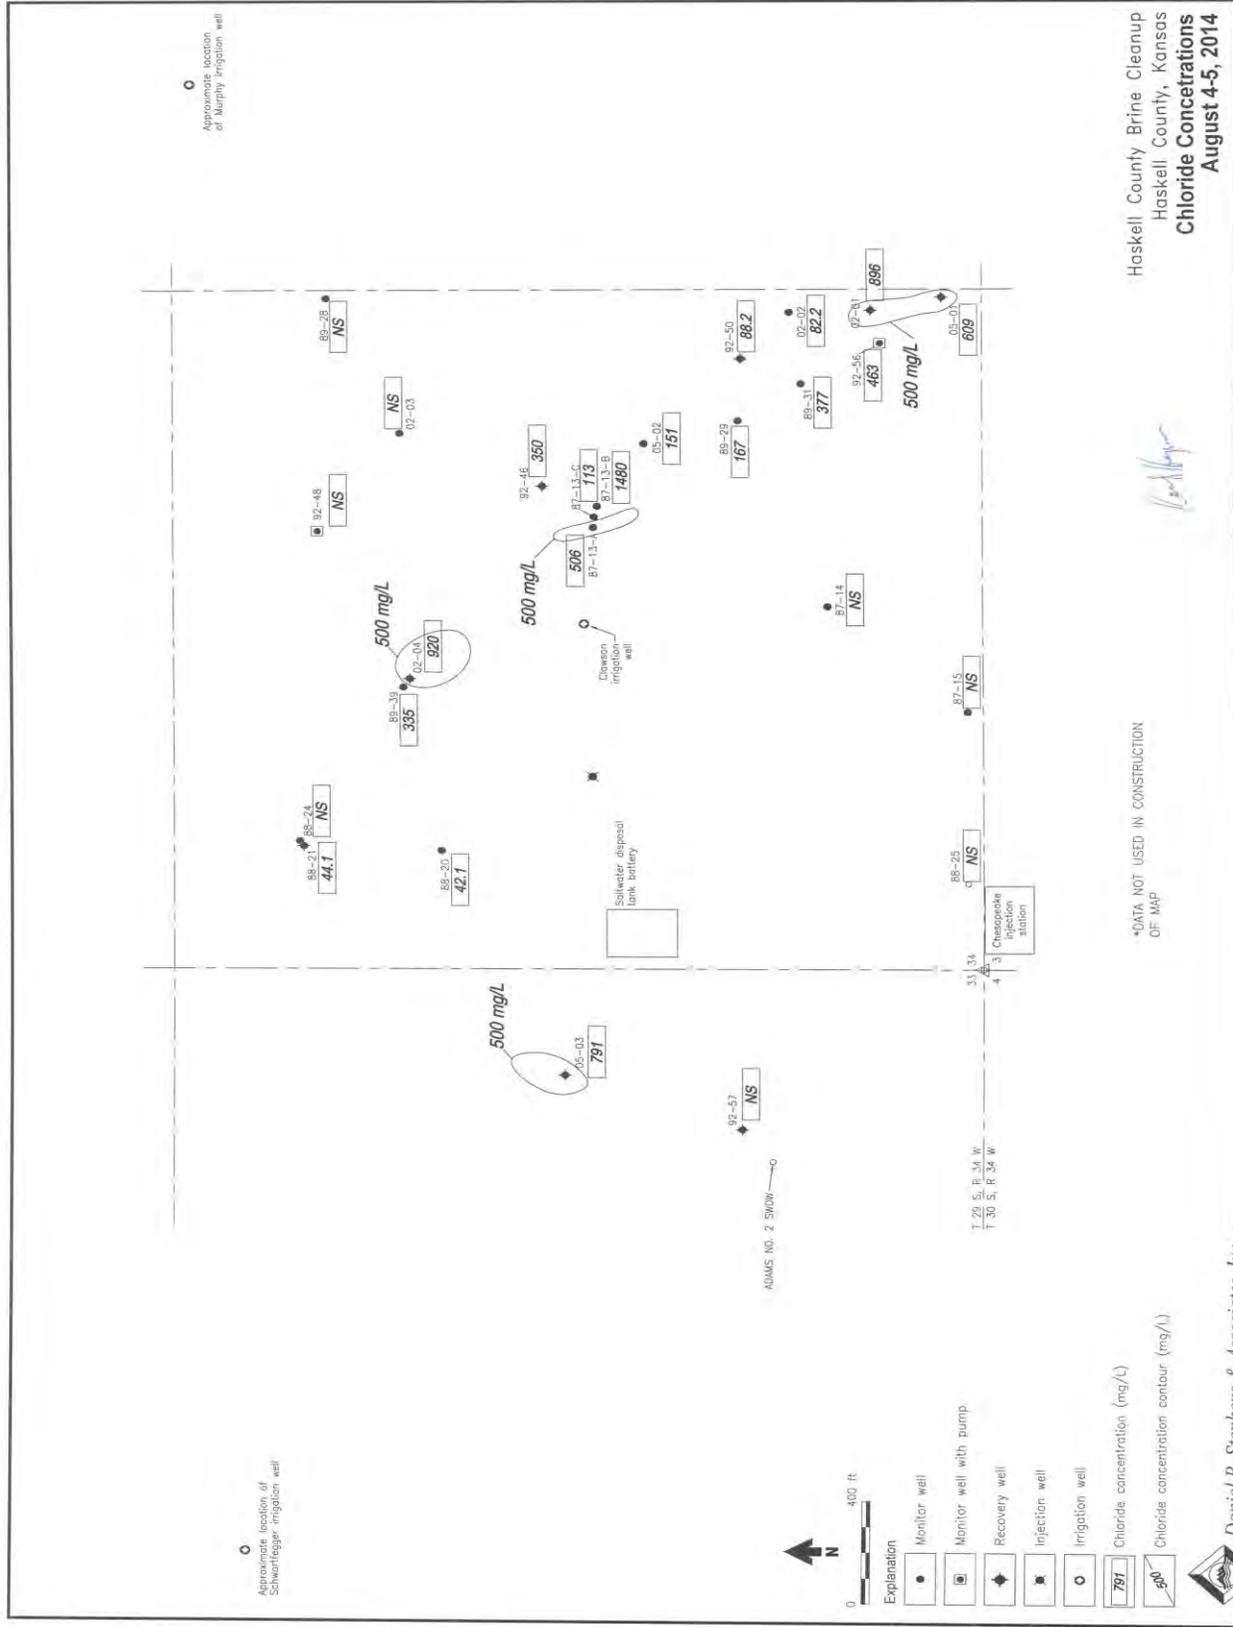


Figure 3

Daniel B. Stephens & Associates, Inc.
08/20/14



Project: Curtis Contamination Site

Site Location: The legal location is Sections 23, 24, 25 & 26 of Township 24 South, Range 14 West, Stafford County.

Impact/Immediacy: The impact is to groundwater resources that have been contaminated by the flow of salt water from an old core drill hole. The core hole thought to be the source of contamination was plugged in 1988. This site has a low to moderate immediacy rating.

Site Description: This site was investigated after the Curtis irrigation well was reported salty. The aquifer in this area consists of unconsolidated material consisting mostly of sand and gravel, and is in general ninety feet thick. Several thin aquitards were encountered in the unconsolidated material. Bedrock consists of clay shale of various colors and was encountered at approximately 90 to 100 feet. The Curtis irrigation well tested salty upon completion and it was reportedly never used. It was also reported that no preliminary test boreholes were made before drilling the irrigation well. The irrigation well was probably drilled into the top of the bedrock and may have pumped chloride contaminated water from this zone.

Unusual Problems: The old core hole may have allowed cross flow of brine into the groundwater aquifer of the Rattlesnake Creek for more than forty years. The plume from this massive intrusion of brine extends to the northeast approximately two miles from the original source area.

Status of Project: Samples were taken from six monitoring wells in 2014. The chlorides have remained steady in the area. The two irrigation wells in section 19 were not sampled this year because they were not running at the time of sampling.

Level of Remediation Sought:


Ideal: 250 ppm

Target: 500-1000 ppm

Recommendation for Future Work: MW-11 will need to be cleaned out in order to get a sample for next year. The two irrigation wells in section 19 will need to be sampled to see if the chlorides have begun to impact the water quality. An apparent monitoring well was drilled next to one of the irrigation wells were sampled. Mapping of the confining layer below the aquifer might reveal if there is a channel the brine is following, or electromagnetic induction profiling (EM), could be run to determine where the chlorides are, and pinpoint the highest impacted areas. This would give a better representation of the chlorides than the thin network of monitoring wells, and would help to pinpoint where future work would need to be focused. An EM survey would also help to identify if there is a current source of chloride intrusion.

Estimated Total Costs: \$27,000

Control No.	Staff Hours/Expenditures	Fund Expenditures	
		FY 2014/15	Total
970034-00	10 Hrs. / \$269.78		\$4,199.17
Current Contaminate Level: 70 ppm Cl- to 4100 ppm Cl-			
Status:			
<input type="checkbox"/> 1. Site Assessment	<input type="checkbox"/> 2. Short Term Monitoring	<input checked="" type="checkbox"/> 3. Investigation	
<input checked="" type="checkbox"/> 4. Long Term Monitoring	<input type="checkbox"/> 5. Remediation Plan	<input type="checkbox"/> 6. Installation	
<input type="checkbox"/> 7. Remediation	<input type="checkbox"/> 8. Post Rem. Monitoring	<input type="checkbox"/> 9. Resolved	

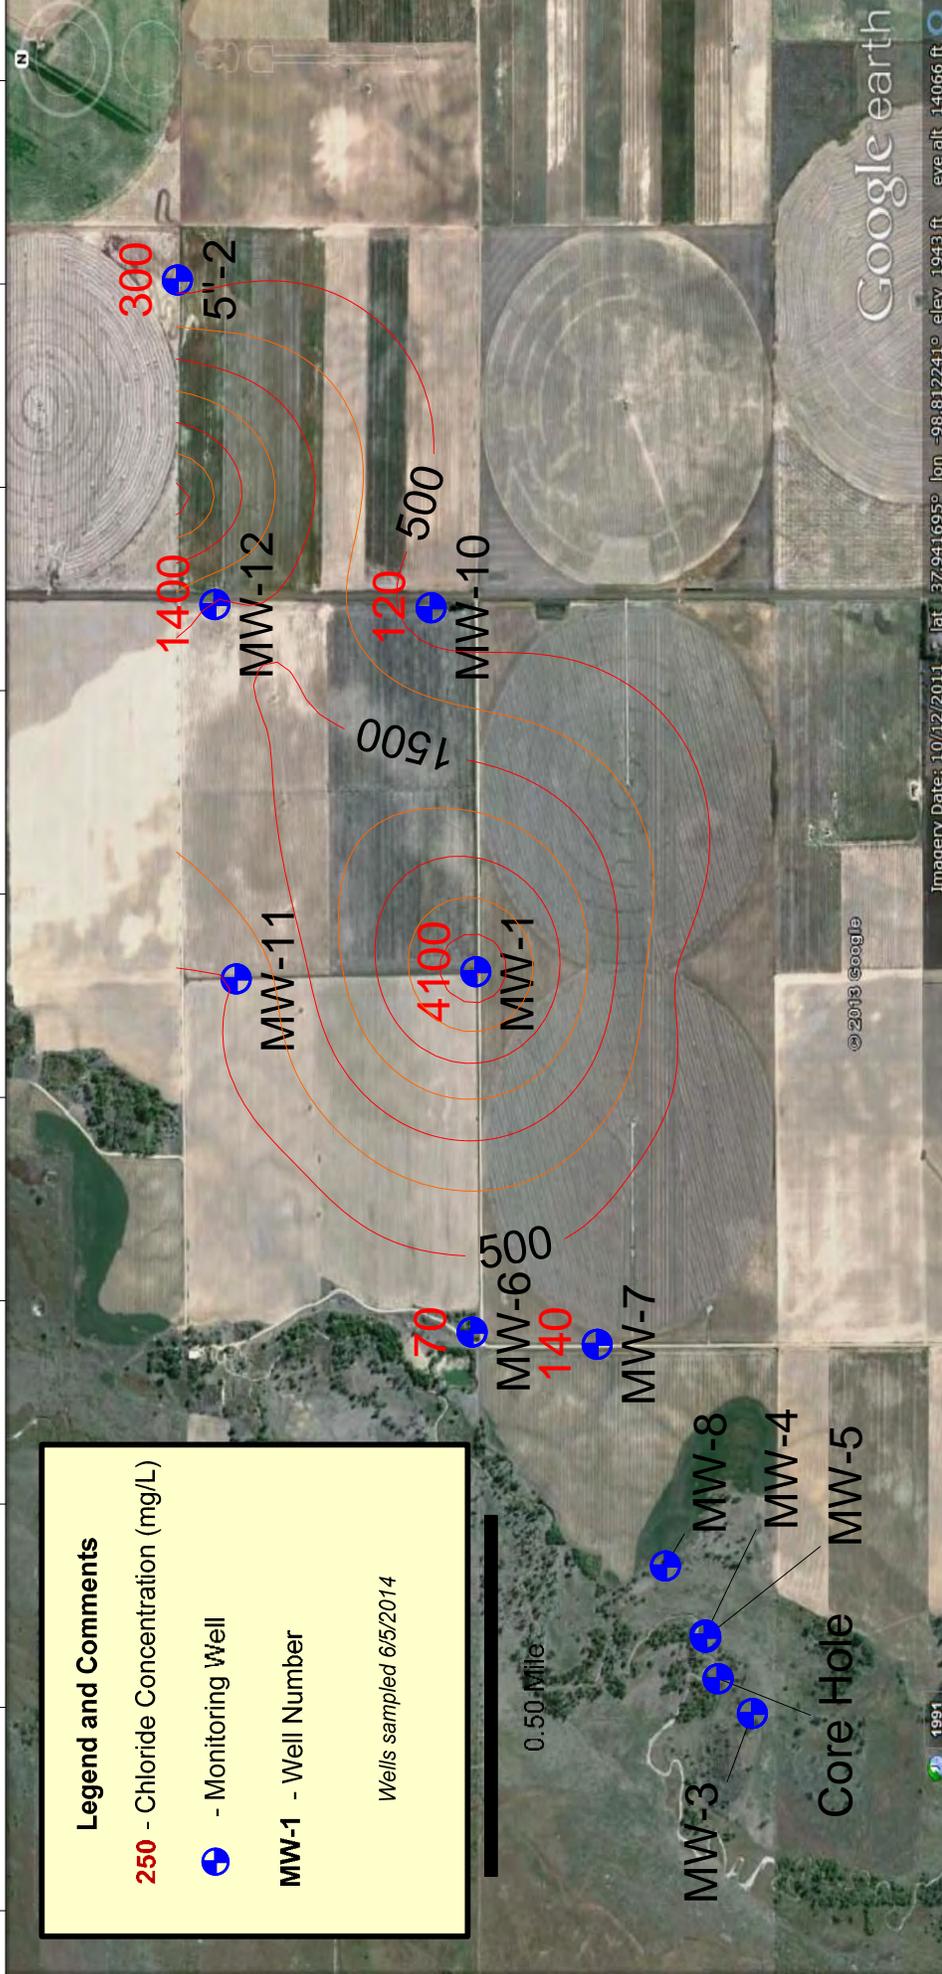

Legend and Comments

- 250 - Chloride Concentration (mg/L)
- - Monitoring Well
- MW-1** - Well Number


Wells sampled 6/5/2014

Curtis Site

Sections 23/24/25/26-T21S-R20W
Stafford County, Kansas

2013-2014 Area Map with Chlorides

KCC Control # 970034-00 District 1
D. Sellers 6/13/14

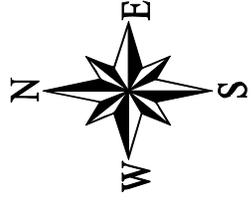

Project: Jim Dinkle Contamination Site

Site Location: SE/4 of Section 32, Township 13 South, Range 17 West, Ellis County.

Impact/Immediacy: Brine from oil field operations has impacted a shallow aquifer within the Big Creek drainage. The affected water was originally the sole source of domestic water for the farmstead, which is now on rural water. The immediacy level for this site is rated as low.

Site Description: This site is bounded on the north by I-70, positioned within the Younger oil field, and has active oil wells, enhanced recovery wells, and disposal wells in the vicinity. Possible contaminant sources include an old brine water evaporation pit (permit revoked July 1, 1958), a shallow injection well (injection authorization revoked September 3, 1969), or drilling pits associated with a nearby well.

Unusual Problems: Unknown contribution of chloride ions from deicing operations on I-70.

Status of Project: A total of 16 holes were drilled on the site in August and September of 2000, and three were completed as monitor wells. The household is on rural water, and the well water is now utilized for cattle. A pumping event may be utilized to remove contaminated water; however the aquifer may not have the capacity to allow for appreciable gains when compared to the amount of water pumped. Because the house has a source of drinking water, and the chloride concentrations in the aquifer are not unsuitable for beef cattle, remediation is not warranted at this time.

Well ID	2010 Chlorides	2011 Chlorides	2012 Chlorides	2013 Chlorides	2014 Chlorides
5	1500 ppm	1140 ppm	1060 ppm	1300 ppm	1300 ppm
7	1200 ppm	760 ppm	880 ppm	1000 ppm	900 ppm
9	1300 ppm	1060 ppm	1020 ppm	1200 ppm	1200 ppm

Level of Remediation Sought:


Ideal: 100 ppm Chloride

Target: 250 ppm Chloride

Recommendations for Future Work: Annual sampling will continue at this site.

Estimated Total Costs: \$28,000 to \$30,000

Control No.	Staff Hours/Expenditures	Fund Expenditures	
		FY 2014/15	Total
970035-00	14 Hrs. / \$347.56		
Current Contaminate Level: 900 ppm to 1,300 ppm Cl⁻			
Status:			
<input type="checkbox"/> 1. Site Assessment	<input type="checkbox"/> 2. Short Term Monitoring	<input type="checkbox"/> 3. Investigation	
<input checked="" type="checkbox"/> 4. Long Term Monitoring	<input type="checkbox"/> 5. Remediation Plan	<input type="checkbox"/> 6. Installation	
<input type="checkbox"/> 7. Remediation	<input type="checkbox"/> 8. Post Rem. Monitoring	<input type="checkbox"/> 9. Resolved	

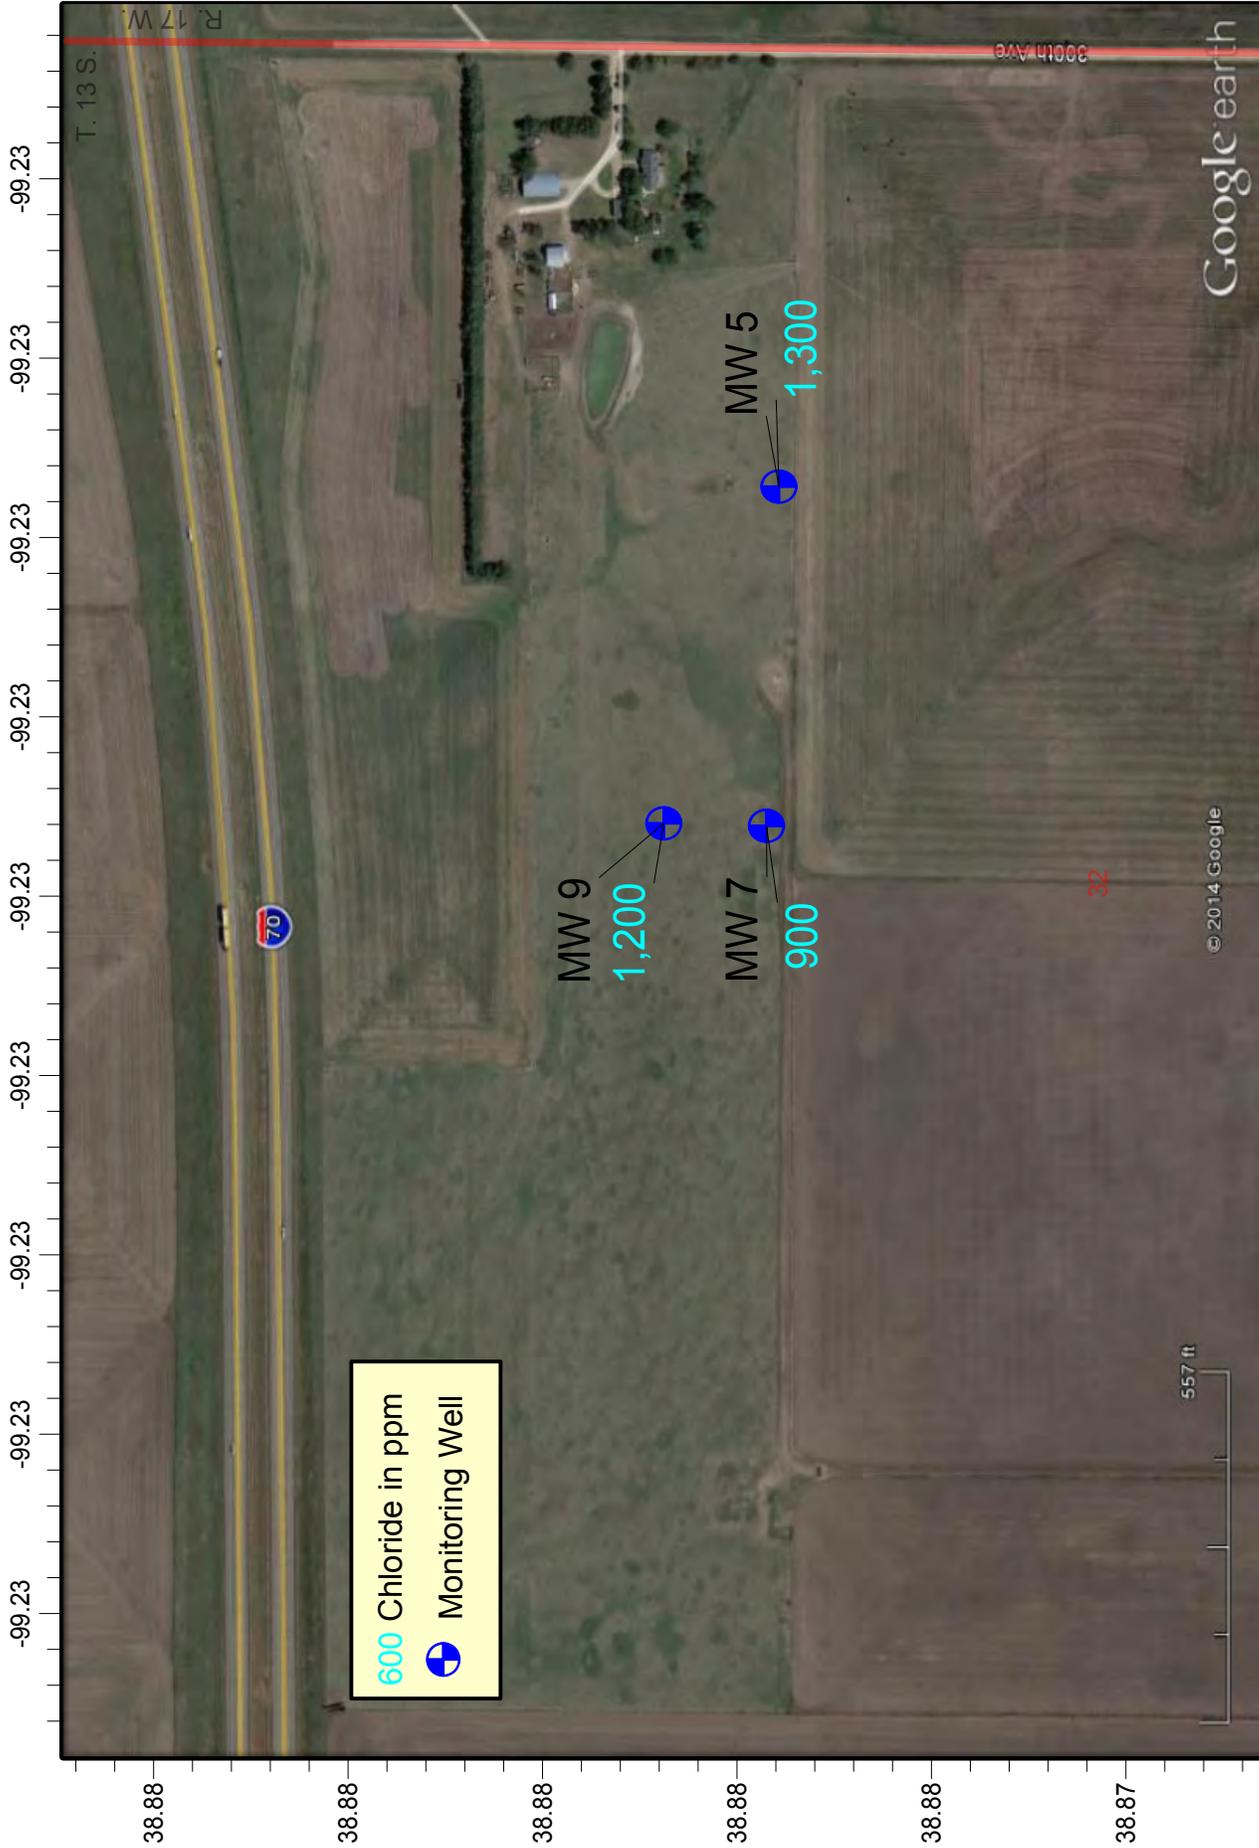

Google earth



Jim Dinkle Groundwater Monitoring Site
 Section 32 of Township 13 South, Range 17 West, Ellis County, Kansas
 2014 Groundwater Chloride Levels
 District #4 - Sampled 6/16/2014 - Map Drawn on 8/26/2014 by C. Neeley



557 ft

© 2014 Google

32

R. 17 W.

T. 13 S.



Project: Dinkler Site

Site Location: The Dinkler site is located within the area of the Four Mile Creek oilfield. The legal description for the site is the west half of section 4 and the north half of section 5, T 28 S- R 3 E in Butler County. Part of the site lies in the north end of the Flint Hills National development.

Impact/ Immediacy: Impact is to the ground water for domestic home sites with water being used for irrigation of lawns and for watering livestock. The site is classified at a low immediacy level.

Site Description: The site is located in grassland underlain by shallow bedrock. The small creeks have down cut into the bedrock producing fingering drainage to the north into the Four Mile Creek, which drains to the east. Four Mile Creek is spring fed and runs through out the year. The aquifer for the water wells in the area is the bedrock limestone with water wells generally being approximately 100 feet deep. The area now has home sites at the Flint Hills National development. This site started with a complaint of a salty domestic yard well in Section 4, Township 28 South, and Range 3 East and was traced to the west-northwest.

Unusual Problems: During the construction of a house on golf course property the surface casing for Graham No. 4 was encountered and oil was found in the casing. A rig was moved in and the well was replugged. Due to the problem encountered with well Graham No.4, Graham No.1 and No. 5 were located with a metal detector on the golf course (2006). Due to the exclusiveness of the golf course and real estate, plugging the unplugged oil wells and adding additional Monitoring wells would be difficult.

Status of Project: In the winter of 2005-2006 unplugged wells identified as the Graham #4 and the Dinkler #2 were plugged by the KCC. Three monitoring wells were installed down gradient to the plugged wells to evaluate water quality. Annual sampling has historically been done on these very low yielding wells. MW #1 was found to have an obstruction approximately 60' down and a decay odor. It appears that a small animal has fallen down the well and become stuck rendering this well unusable. 2014 The shallow zone well was found to be heaved and broken. Wells were not sampled during the 2014 summer.

Level of Remediation Sought:

Ideal: 250 mg/l

Target: 500 mg/l

Recommendation for Future Work: Two out of the three KCC monitoring wells have been rendered unusable. The wells are at the same location so very little data can be gained from them as far as the extent of any brine contamination. Over the last two to three years many houses have installed geothermal and other water wells to the west of the monitoring well battery. There have been no complaints registered with the KCC regarding brine impaction on these wells to date. Due to the exclusive nature of this site, requests for access to perform investigative borings may prove problematic. KCC recommends placing this site in the closed site list. KCC should plug out the three monitoring wells and restore the area to its original condition.

Total Costs: \$21,792

Control No.	Staff Hours/Expenditures	Fund Expenditures	
		FY 2014/15	Total
20050047-001	5 Hrs. / \$142.50		\$9,642.50
Current Contaminate Level: N/A			
Status:			
<input type="checkbox"/> 1. Site Assessment	<input type="checkbox"/> 2. Short Term Monitoring	<input type="checkbox"/> 3. Investigation	
<input type="checkbox"/> 4. Long Term Monitoring	<input type="checkbox"/> 5. Remediation Plan	<input type="checkbox"/> 6. Installation	
<input type="checkbox"/> 7. Remediation	<input type="checkbox"/> 8. Post Rem. Monitoring	<input checked="" type="checkbox"/> 9. Resolved	



Dinkler/Flint Hills National Contamination Site
 Sections 4 & 5 of T 28 S & R 3 E of Butler County, Kansas
Site Map 2014
 KCC Code# 200050047-001 - District #2 - D. Bollenback - 11/20/2014





Project: Burrton Crude Oil EB-3C

Site Location: The EB-3C contamination site is located at a crossroads located at the convergence of Sections 25 and 36, Township 23 South, Range 4 West and Sections 30 and 31 of Township 23 South and Range 3 West, Harvey and Reno County. The site is one mile west and one mile south of Burrton, Kansas.

Impact/Immediacy: Low immediacy level. The spill affects a shallow groundwater aquifer with no residences within a half mile. The area extent of contamination is believed to be less than one acre. No domestic water wells or irrigation wells are immediately down gradient of the site.

Site Description: The site is located in rural Harvey and Reno County. The land use is agricultural. The depth to groundwater is less than ten feet. The affected groundwater is the Equus Beds. The A layer of the Equus Beds is very permeable, is very productive and contains good water quality.

Unusual Problems: This site is a hydrocarbon impacted site with problems different than brine impaction. The clay above the Equus Sands deepens down gradient and is acting as a trap for the crude oil. Historical static water levels have intersected this clay layer to the south and east.

Status of Project: KCC has evaluated multiple remedial techniques from natural attenuation, new well installation and hydro-carbon absorbing aqua-socks, and oxygenating chemical injection into the aquifer. KCC district #2 feels that injection of an oxygenating chemical would help speed-up natural break-down of the hydrocarbons by increasing micro-bioremediation.

Level of Remediation Sought:


Ideal: Non –detect of TPH (Aqueous-Phase)

Target: No Free Liquid-Phase Hydrocarbon

Recommendations for Future Work: KCC will look into the use of an emulsifier to work in hand with the oxygenating treatment. KCC will install a 4” observation well in the southeast corner to observe the change of product level. The oxygenating compounds will continue to help breakdown any contaminates in aqueous form. After sufficient improvement is found KCC will close the site.

Estimated Total Costs: Approximately \$5,000 to install shallow well/s and inject the remedial compounds.

Control No.	Staff Hours/Expenditures	Fund Expenditures	
		FY 2014/15	Total
970042-00	8 Hrs. / \$217.20		\$2,350
Current Contaminate Level: NDA			
Status:			
<input type="checkbox"/> 1. Site Assessment	<input type="checkbox"/> 2. Short Term Monitoring	<input checked="" type="checkbox"/> 3. Investigation	
<input type="checkbox"/> 4. Long Term Monitoring	<input checked="" type="checkbox"/> 5. Remediation Plan	<input type="checkbox"/> 6. Installation	
<input type="checkbox"/> 7. Remediation	<input type="checkbox"/> 8. Post Rem. Monitoring	<input type="checkbox"/> 9. Resolved	

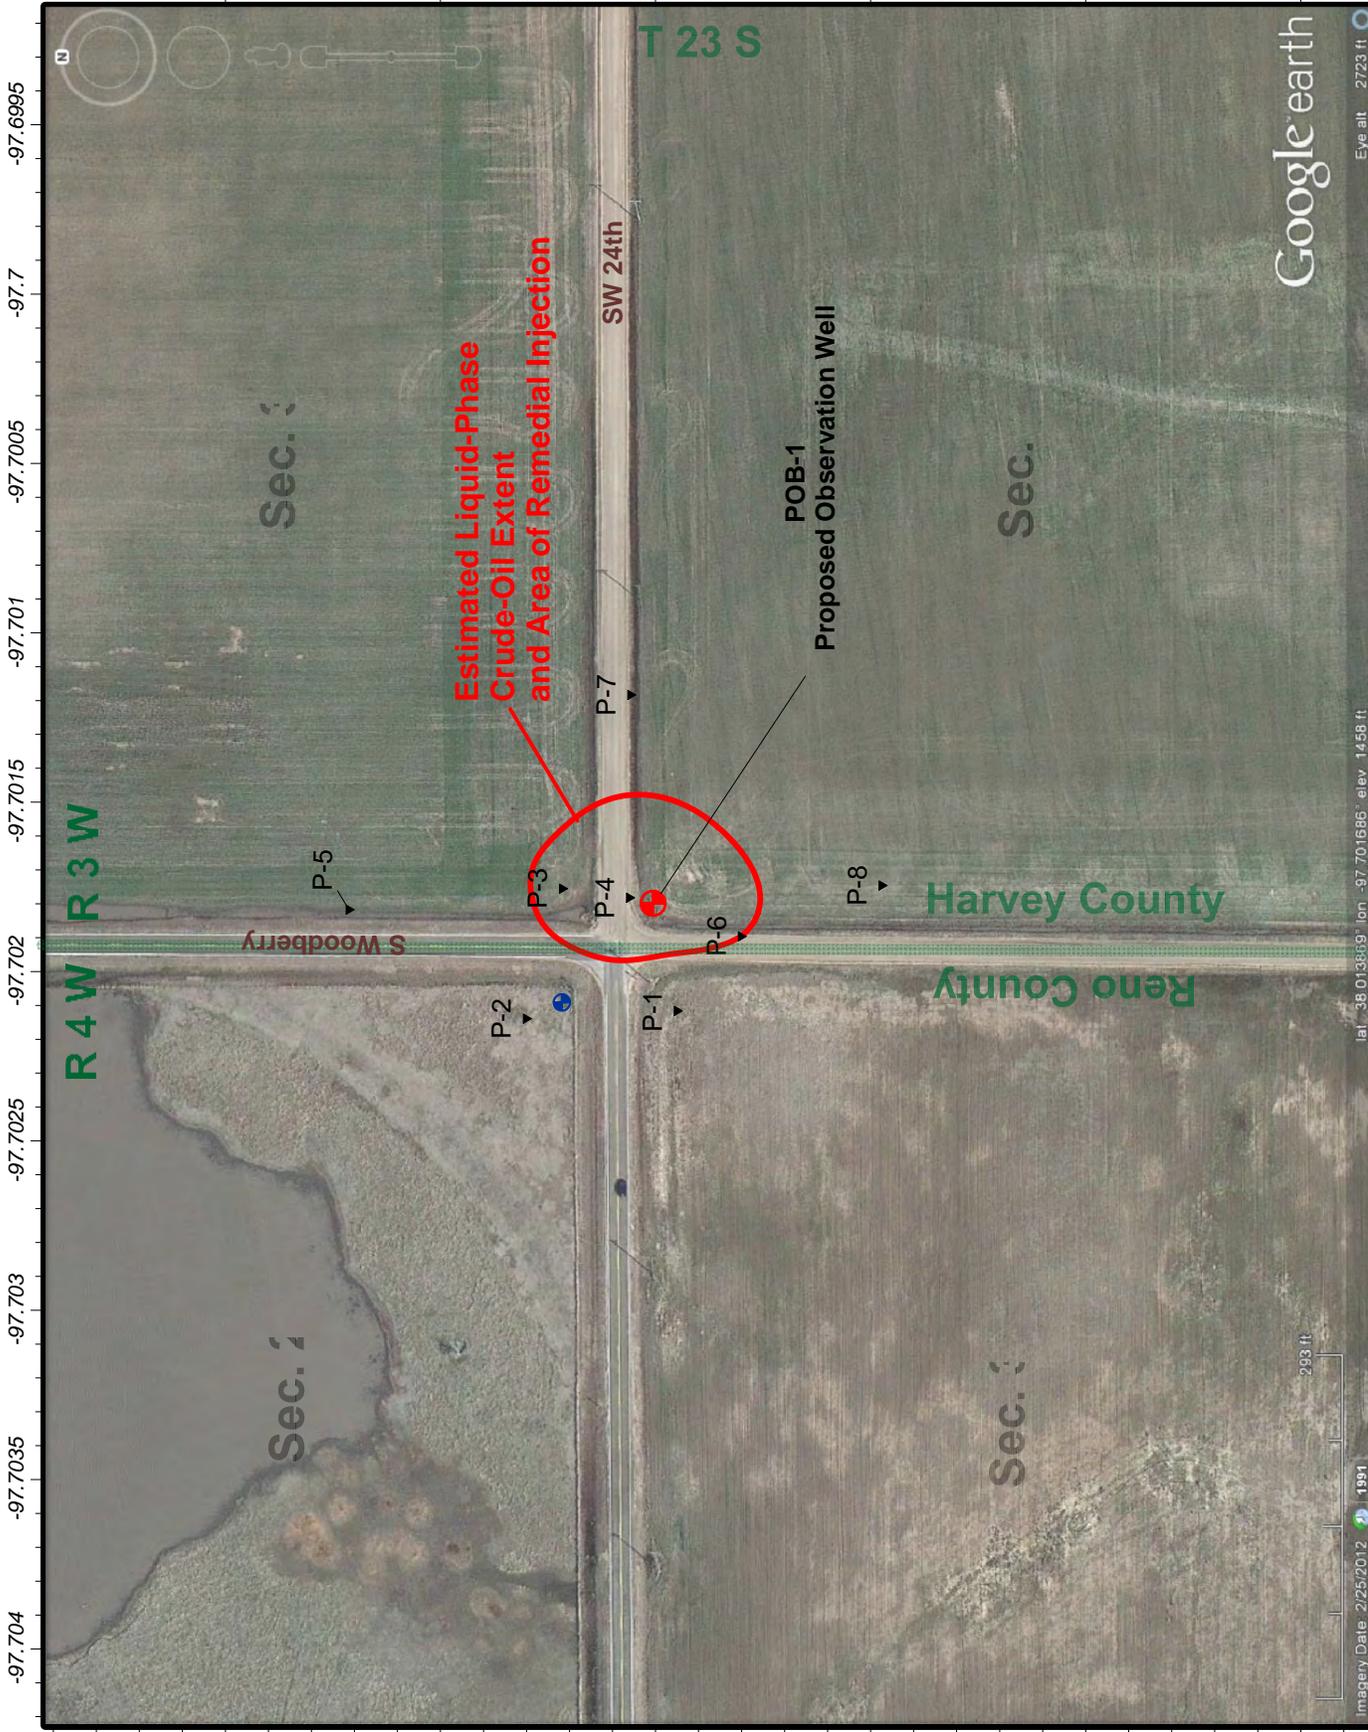

Google earth

Eye alt 2723 ft

lat: 38.013868 lon: -97.701686 elev: 14.58 ft

293 ft

Imagery Date: 2/25/2012 1391



Burton EB-3C - Crude Oil Spill - Control # 970042-00
 Section 25, Township 23 South & Range 4 West, Harvey and Reno Counties, Kansas
Annual Site Update Map 2014
 District #2 - Drawn on: 10/4/2014 by D. Bollenback

Project: Elm Creek Contamination Site

Site Location: Sections 19, 20, 29, 30, 31, and 32 of Township 7 South, Range 17 West
Sections 5, 6, 7, 8, 17, 18, 19, 20, 29, 30, 31, and 32 of Township 8 South, Range 17 West
Sections 5 and 6 of Township 9 South, Range 17 West, Rooks County

Impact/Immediacy: The Elm Creek alluvial aquifer has been contaminated by past oil field activity. Both domestic and stock wells are affected, and the area is serviced by Rooks County Rural Water District #3. The immediacy level for this site should be rated as moderate to high.

Site Description: Elm Creek is a tributary to the South Fork Solomon River, which it enters just downstream of Stockton, Kansas. Numerous complaints beginning in the mid 1900's led to wide-spread sampling, and the designation of approximately 40 square miles as the site. A series of monitoring wells were completed in the bottom of the drainage near the confluences of other streams with Elm Creek in an attempt to constrict the size of the contamination site by identifying the direction from which chloride ions were originating. The installation of the monitor well net was completed in May of 1998, and sampled for 5 years under contract. Following the sunset of the sampling contract, the well net was sampled quarterly for three years, and biannually for two years. Sampling is now performed annually by KCC staff.

Unusual Problems: The history of contamination in the Elm Creek area is extensive, and many of the possible sources of pollution were insufficiently documented. Additionally, the large areal extent of the site poses challenges for investigation and remediation.

Status of Project: Long-term monitoring has revealed that the chloride concentrations in the monitoring wells have remained the highest near the south end of the site. Presently, the chloride level in even the most severely impacted areas of the site do not preclude use of the water for stock use, irrigation of certain plants, or general non-potable use. Four monitoring wells contain chloride ions in concentrations which are above what is considered to be fresh water (500 ppm), three wells are below the freshwater threshold, but above drinking water standards (250 ppm), and seven wells are below the chloride concentration threshold for water suitable for human consumption.



Level of Remediation Sought:

Ideal: 250 ppm Chloride
Target: 500 ppm Chloride

Recommendations for Future Work: While the trend in contamination distribution has remained relatively stable, long-term monitoring should continue until the target level is reached, or the site parameters change in such a way as to warrant further investigation and remedial efforts.

Estimated Total Cost: If warranted, remediation costs could reach a total of \$250,000.

Control No.	Staff Hours/Expenditures	Fund Expenditures	
		FY 2014/15	Total
970043-00	44 Hrs. / \$1,064.98		\$29,212.25
Current Contaminate Level: 150 ppm to 980 ppm Cl			
Status:			
<input type="checkbox"/> 1. Site Assessment	<input type="checkbox"/> 2. Short Term Monitoring	<input type="checkbox"/> 3. Investigation	
<input checked="" type="checkbox"/> 4. Long Term Monitoring	<input type="checkbox"/> 5. Remediation Plan	<input type="checkbox"/> 6. Installation	
<input type="checkbox"/> 7. Remediation	<input type="checkbox"/> 8. Post Rem. Monitoring	<input type="checkbox"/> 9. Resolved	

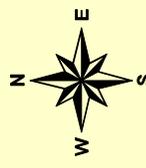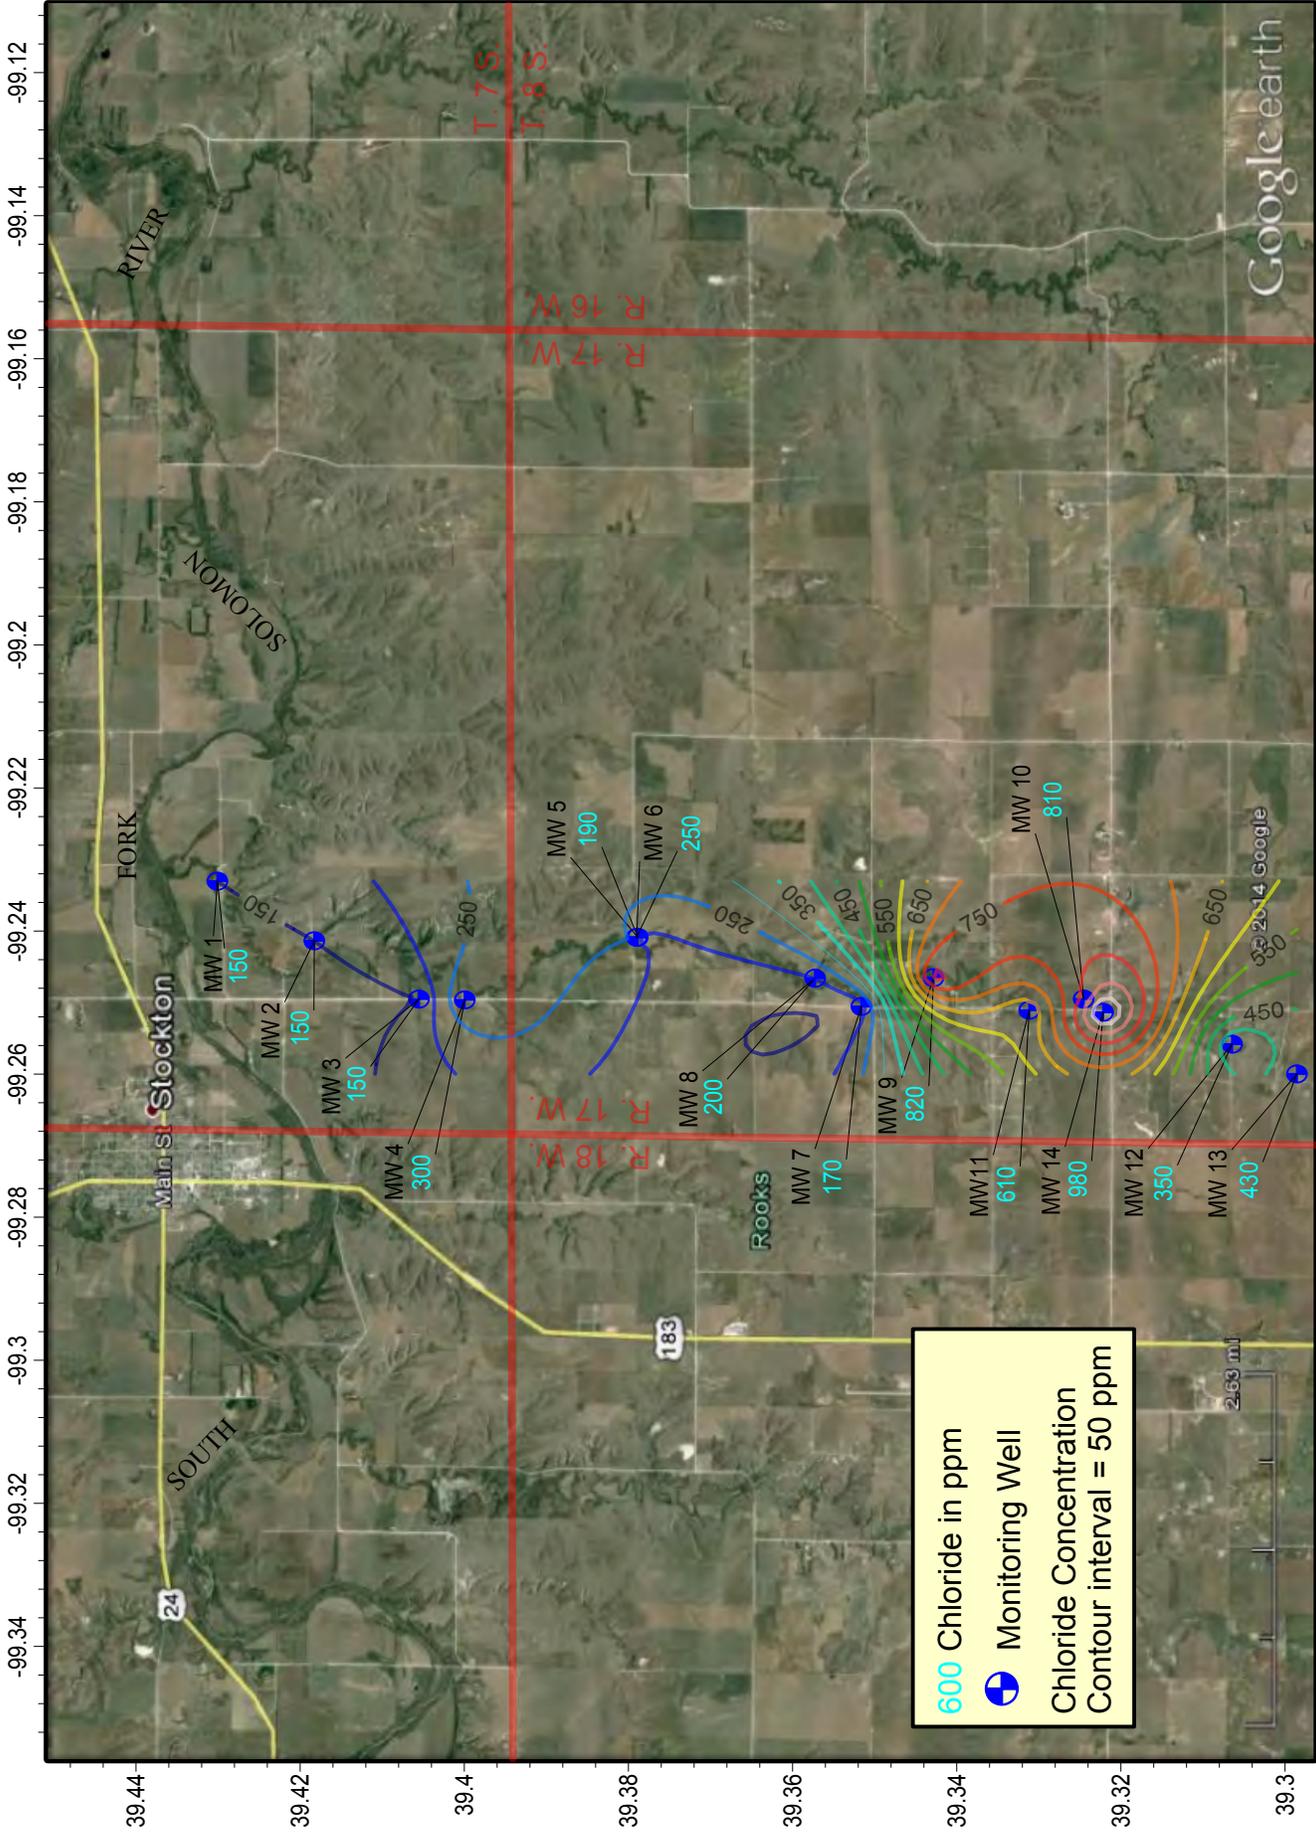

Elm Creek Groundwater Monitoring Site
 Multiple Sections of Townships 7 and 8 South, Range 17 West, Rooks County, Kansas
 2014 Groundwater Chloride Levels
 District #4 - Sampled 7/14/2014 through 7/18/2014 - Map Drawn on 9/5/2014 by C. Neeley



Google earth

Project: *Enoch Thompson Contamination Site*

Site Location: Legal location is NW/4 Section 17, Township 21 South, Range 20 West, Pawnee County.

Impact/Immediacy: Stock well was damaged by chlorides from a line leak found near the SWDW. An irrigation well is located to the southwest of the site in the direction of the plume flow. Potential responsible parties drilled one recovery well and a replacement stock well in October 1988, thereafter the chlorides of which dropped through the years. The site is rated moderate to low in immediacy.

Site Description: The contamination is confined to a narrow alluvial scour channel filled with sandy gravel and silty clay. The high concentrate of brine water moved from the source area in the north to the south and contaminated Mr. Thompson's stock well.

Unusual Problems: None

Status of Project: Three groundwater samples were collected in 2014. Chloride levels across the board have seen a decrease. The recovery system has been down since 2003 following P&A of the disposal well due to wellbore problems. KDHE-1, which has historically been the highest in terms of chlorides, was destroyed December 2003. The chloride plume continues to be localized in a relatively small area of alluvial scour between the recovery well and the plugged disposal well. It is unlikely that without the recovery well operational, the site will see any significant change in chlorides.

Level of Remediation Sought:


Ideal: 250 ppm Chloride

Target: 1000 ppm Chloride

Recommendation for Future Work: Continue groundwater sampling on an annual basis to monitor movement of chloride plume through the area. Should a disposal well be drilled nearby, the feasibility of restarting the recovery well should be evaluated.

Estimated Total Cost: \$500 for yearly sampling.

Control No.	Staff Hours/Expenditures	Fund Expenditures	
		FY 2014/15	Total
970044-00	5 Hrs. / \$138.33		
Current Contaminate Level: 60 ppm Cl- to 1300 ppm Cl-			
Status:			
<input type="checkbox"/> 1. Site Assessment	<input type="checkbox"/> 2. Short Term Monitoring	<input type="checkbox"/> 3. Investigation	
<input checked="" type="checkbox"/> 4. Long Term Monitoring	<input type="checkbox"/> 5. Remediation Plan	<input type="checkbox"/> 6. Installation	
<input type="checkbox"/> 7. Remediation	<input type="checkbox"/> 8. Post Rem. Monitoring	<input type="checkbox"/> 9. Resolved	

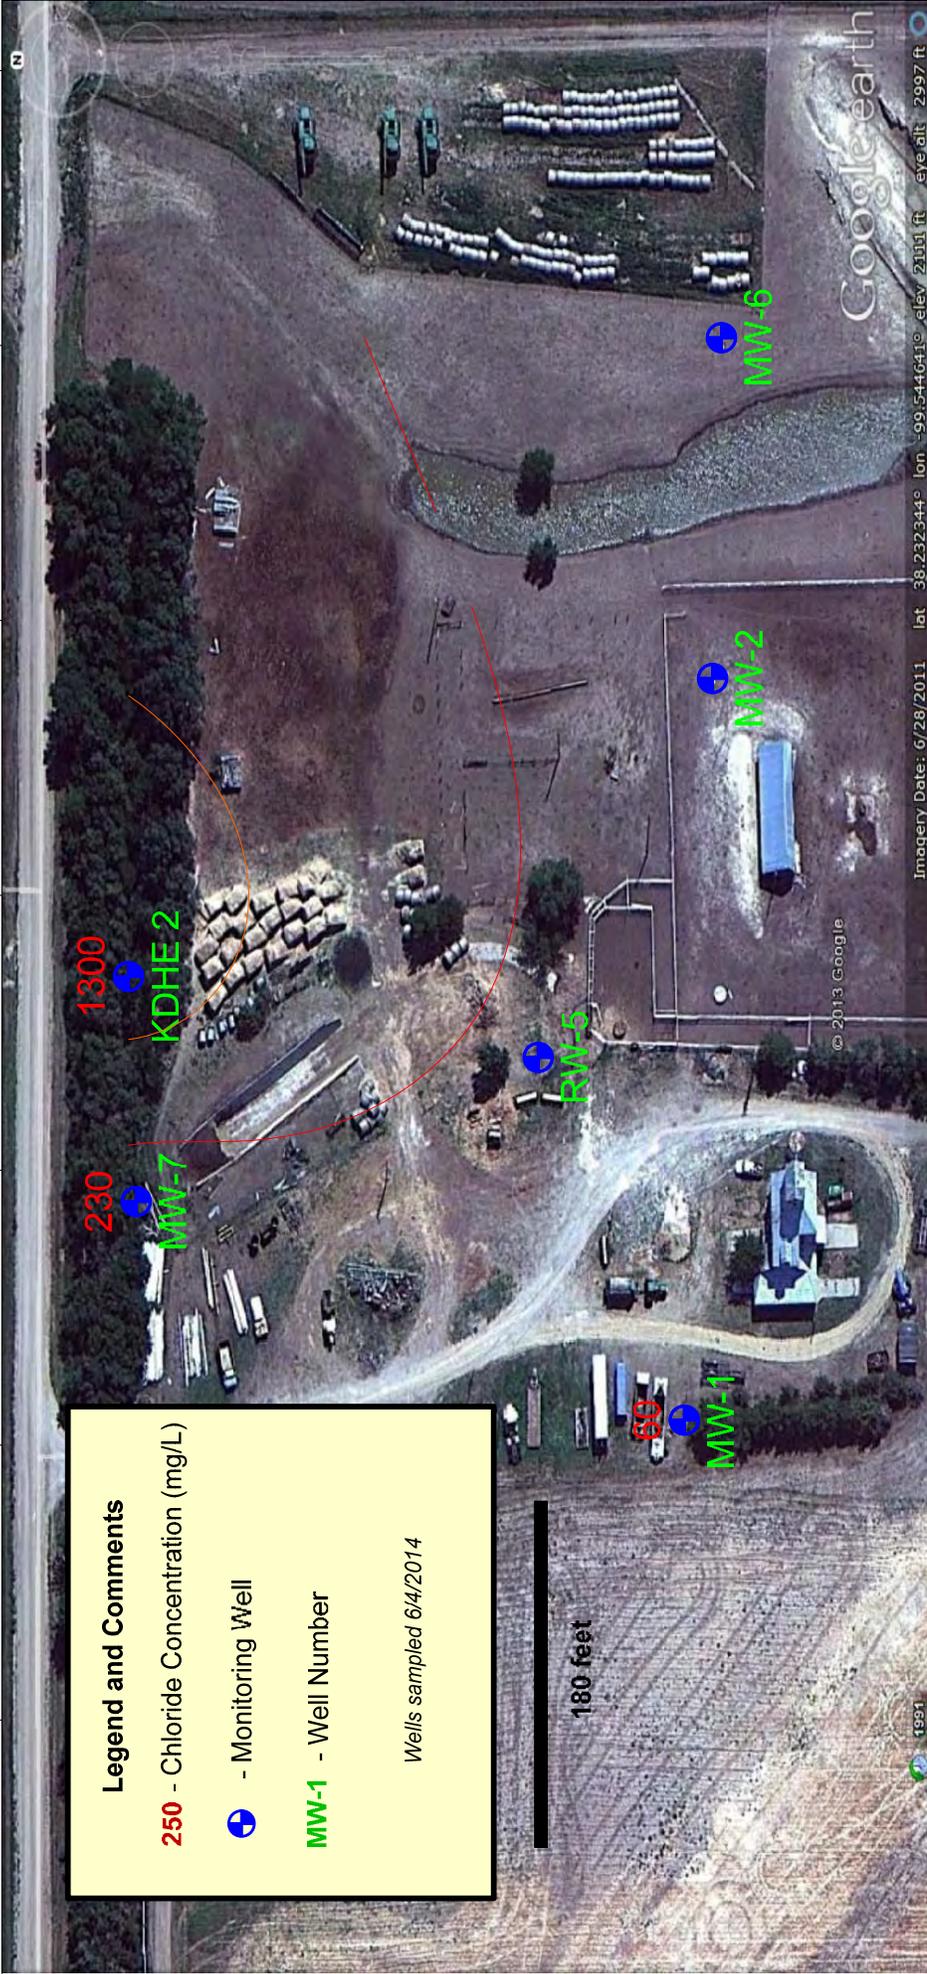

Legend and Comments

250 - Chloride Concentration (mg/L)

- Monitoring Well

MW-1 - Well Number

Wells sampled 6/4/2014


180 feet

Enoch Thompson Site

Section 17-T21S-R20W
 Pawnee County, Kansas

2013-2014 Area Map with Chlorides

KCC Control # 970044-00 District 1
 D. Sellers 6/13/14

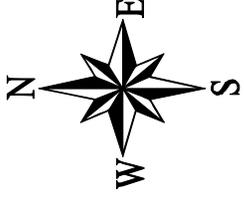

Kansas
 Corporation Commission

Project: *Fink Contamination Site*

Site Location: NE/4 of Section 27 and SE/4 of Section 22, Township 8 South, Range 22 West, Graham County.

Impact/Immediacy: Stock well in the Codell Formation testing high in chlorides. Immediacy level is rated as low.

Site Description: The site encompasses a stock well and a now abandoned domestic well. Both were drilled into the Codell sandstone which is a marginal aquifer in Graham County. The chloride was initially very low, but rose sharply in the stock well during the 1970's. Surface sources were considered, but due to the nature of the bedrock and the depth to the Codell aquifer, it is more likely that the pollution originated from a below-ground source. The Fink #2 saltwater disposal well (SWD) was originally completed as an oil well in 1954, and subsequently converted to an enhanced oil recovery well before ultimately being converted to a SWD. This well was long the subject of interest, but before the implementation of the federal Underground Injection Control, there was little statutory authority to rigorously check the integrity of the well bore. For this reason, it was never proved or disproved that the well was the source. However, the construction of the well is highly suspect, and may or may not continue to be a conduit for saline water from brackish zones to enter the Codell despite the fact that the well was plugged in 1984.

Unusual Problems: The depth to the contaminated zone is approximately 250 to 300 feet, making investigation and remediation difficult.

Status of Project: The domestic well has been abandoned due to a water level that is inadequate for use by the owner. The last sample taken from this source, in 2004 contained a chloride concentration of 200 ppm. Samples from the stock well continue to be tested, and the well is presently being utilized for livestock which will contribute to a reduction in chloride concentrations if the source has been eliminated. An overall downward trend has been observed over the history of the site, and the current contamination concentration is at 760 ppm.

Level of Remediation Sought:



Ideal: 250 ppm Chloride

Target: 500 ppm Chloride

Recommendations for Future Work: This site should be monitored long-term to ascertain if the source of chloride ions has been isolated from the useable water in the Codell Sandstone aquifer.

Estimated Total Costs: \$2000

Control No.	Staff Hours/Expenditures	Fund Expenditures	
		FY 2014/15	Total
970007-00	23 Hrs. / \$565.05		
Current Contaminate Level: 760 ppm Cl⁻			
Status:			
<input type="checkbox"/> 1. Site Assessment	<input type="checkbox"/> 2. Short Term Monitoring	<input type="checkbox"/> 3. Investigation	
<input checked="" type="checkbox"/> 4. Long Term Monitoring	<input type="checkbox"/> 5. Remediation Plan	<input type="checkbox"/> 6. Installation	
<input type="checkbox"/> 7. Remediation	<input type="checkbox"/> 8. Post Rem. Monitoring	<input type="checkbox"/> 9. Resolved	

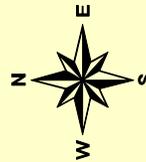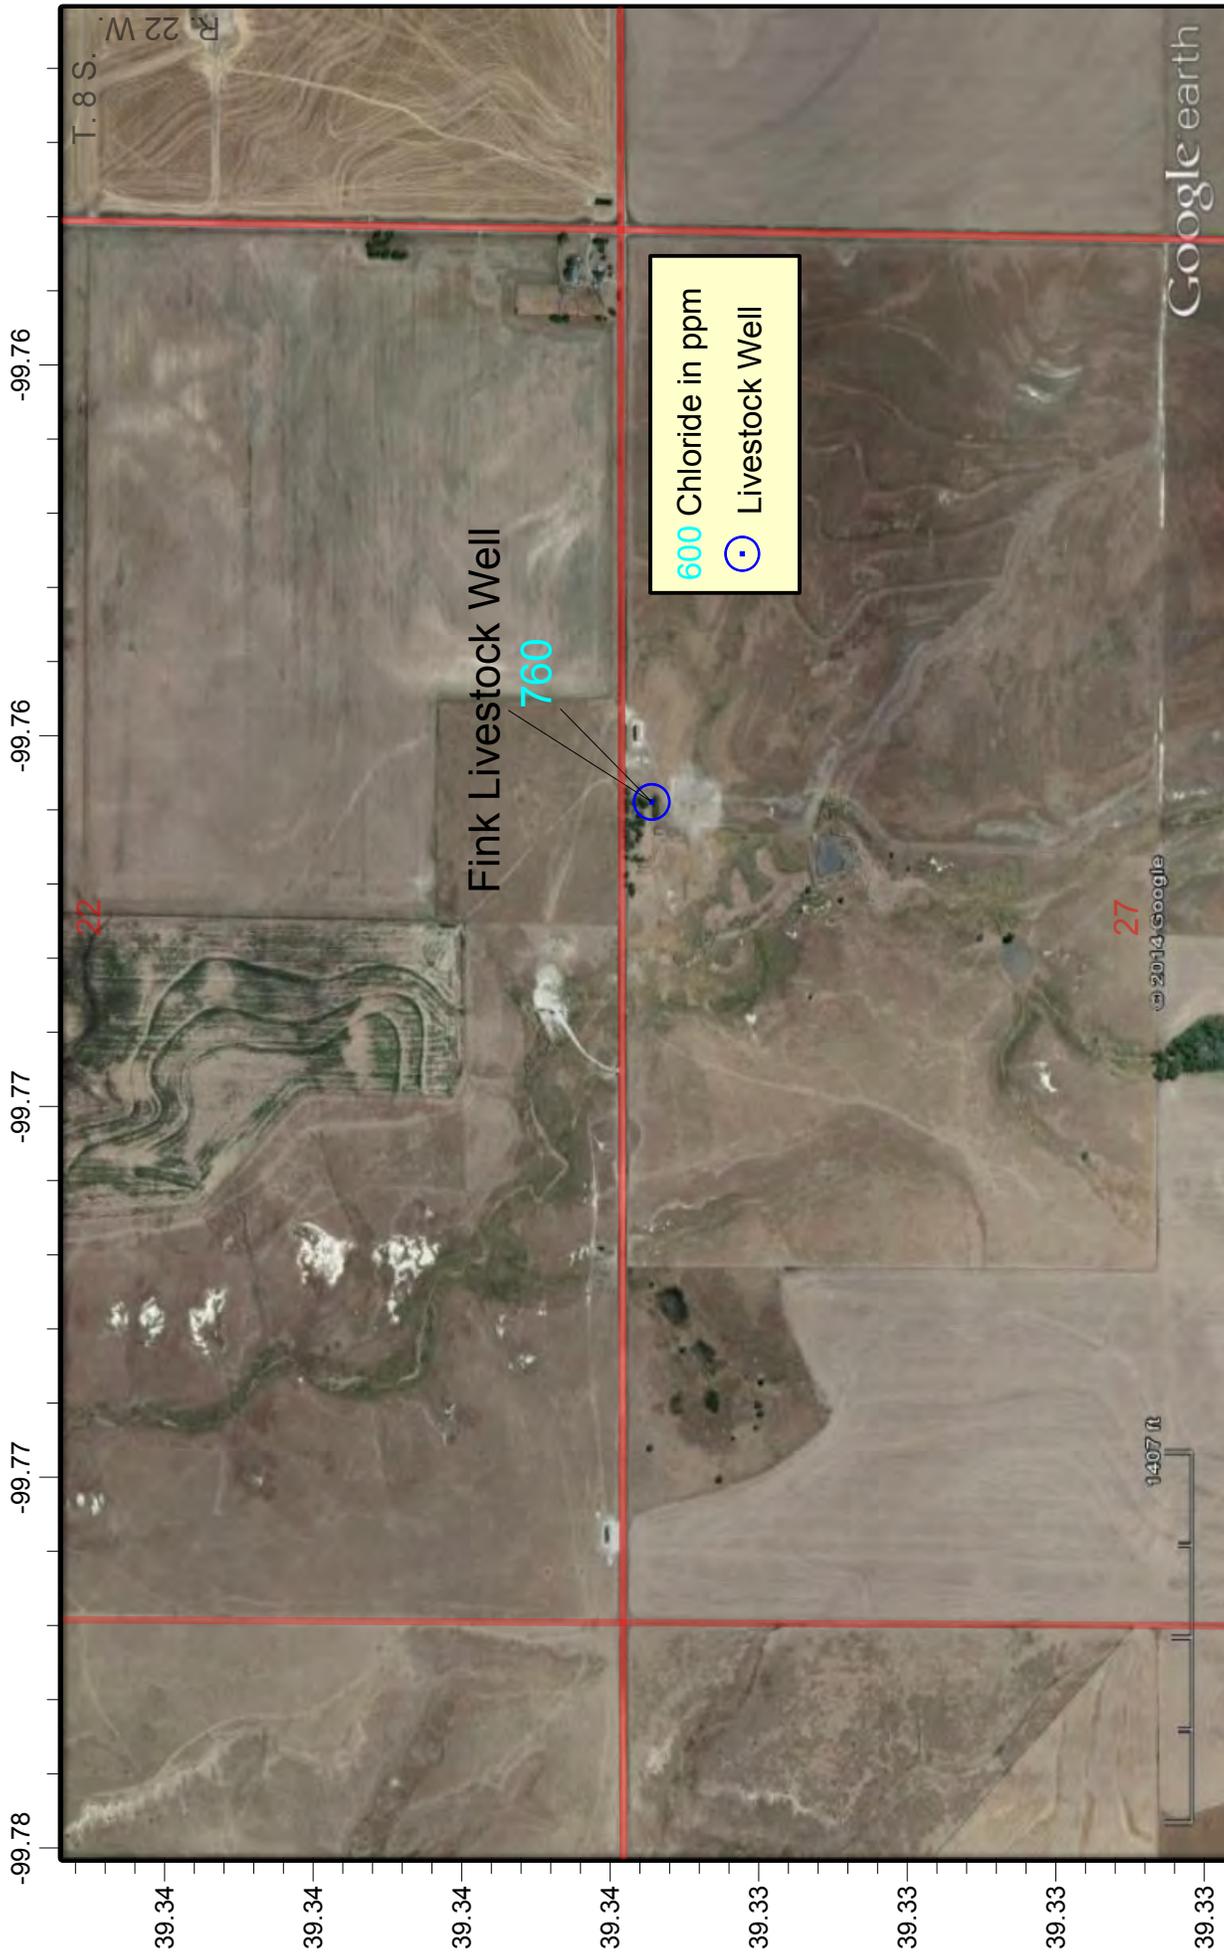

Fink Groundwater Monitoring Site

Section 27 of Township 8 South, Range 22 West, Graham County, Kansas
 2014 Groundwater Chloride Levels
 District #4 - Sampled 4/25/2014 - Map Drawn on 9/8/2014 by C. Neeley



Project: *Fowler Contamination Site*

Site Location: NE/4 of Section 19, Township 32 South, Range 14 East, Montgomery County.

Impact/Immediacy: Impact is to the soil. The immediacy is rated as low.

Site Description: Site is located below an old three-cell storage/settling pond.

Unusual Problems: Access to dependable sample locations and lack of monitoring wells.

Status of Project: Monitoring of small creek running through project area. The Fowler lease was approved for a Fee Fund Project in the fall of 2000. Approximately 112 wells were plugged in 2001. One sample was collected in 2014 on 10/07/2014. This sample tested 300 ppm Cl- from Sample Location #2. No surface fluids were present to sample from Sample Location #2. Brine impacted areas continue to show visual improvement of vegetative growth.

Level of Remediation Sought:

Ideal: 200 ppm Chloride

Target: 300 ppm Chloride

Recommendation for Future Work: Continued monitoring and treatment again with gypsum and re-seeding when appropriate. Implement soil sampling as well as fluid sampling to further document recovery of this site in order to possibly close site by 2016. Construction of approximately 3-4 monitoring wells to determine if saltwater is migrating into the physical boundary of lease from other sources.

Estimated Total Costs: Monitoring cost approximately \$1,500.00 per year

Control No.	Staff Hours/Expenditures	Fund Expenditures	
		FY 2014/15	Total
970046-00	24 Hrs. / \$637.84		
Current Contaminate Level: Cl- 300 ppm			
Status: Active			
<input type="checkbox"/> 1. Site Assessment	<input type="checkbox"/> 2. Short Term Monitoring	<input type="checkbox"/> 3. Investigation	
<input type="checkbox"/> 4. Long Term Monitoring	<input type="checkbox"/> 5. Remediation Plan	<input type="checkbox"/> 6. Installation	
<input type="checkbox"/> 7. Remediation	<input checked="" type="checkbox"/> 8. Post Rem. Monitoring	<input type="checkbox"/> 9. Resolved	

KANSAS CORPORATION COMMISSION

Fowler Remediation Site
NE 19 - T32S - R14E
Montgomery County Kansas
Project 970046-00

11/20/2014

District 3

 Active Gas Well


 Fee Fund Plugged Oil Well

 Fee Fund Plugged UIC Well

 Sample Location

 CI- Concentration
Contour = 10 ppm

1000 ft

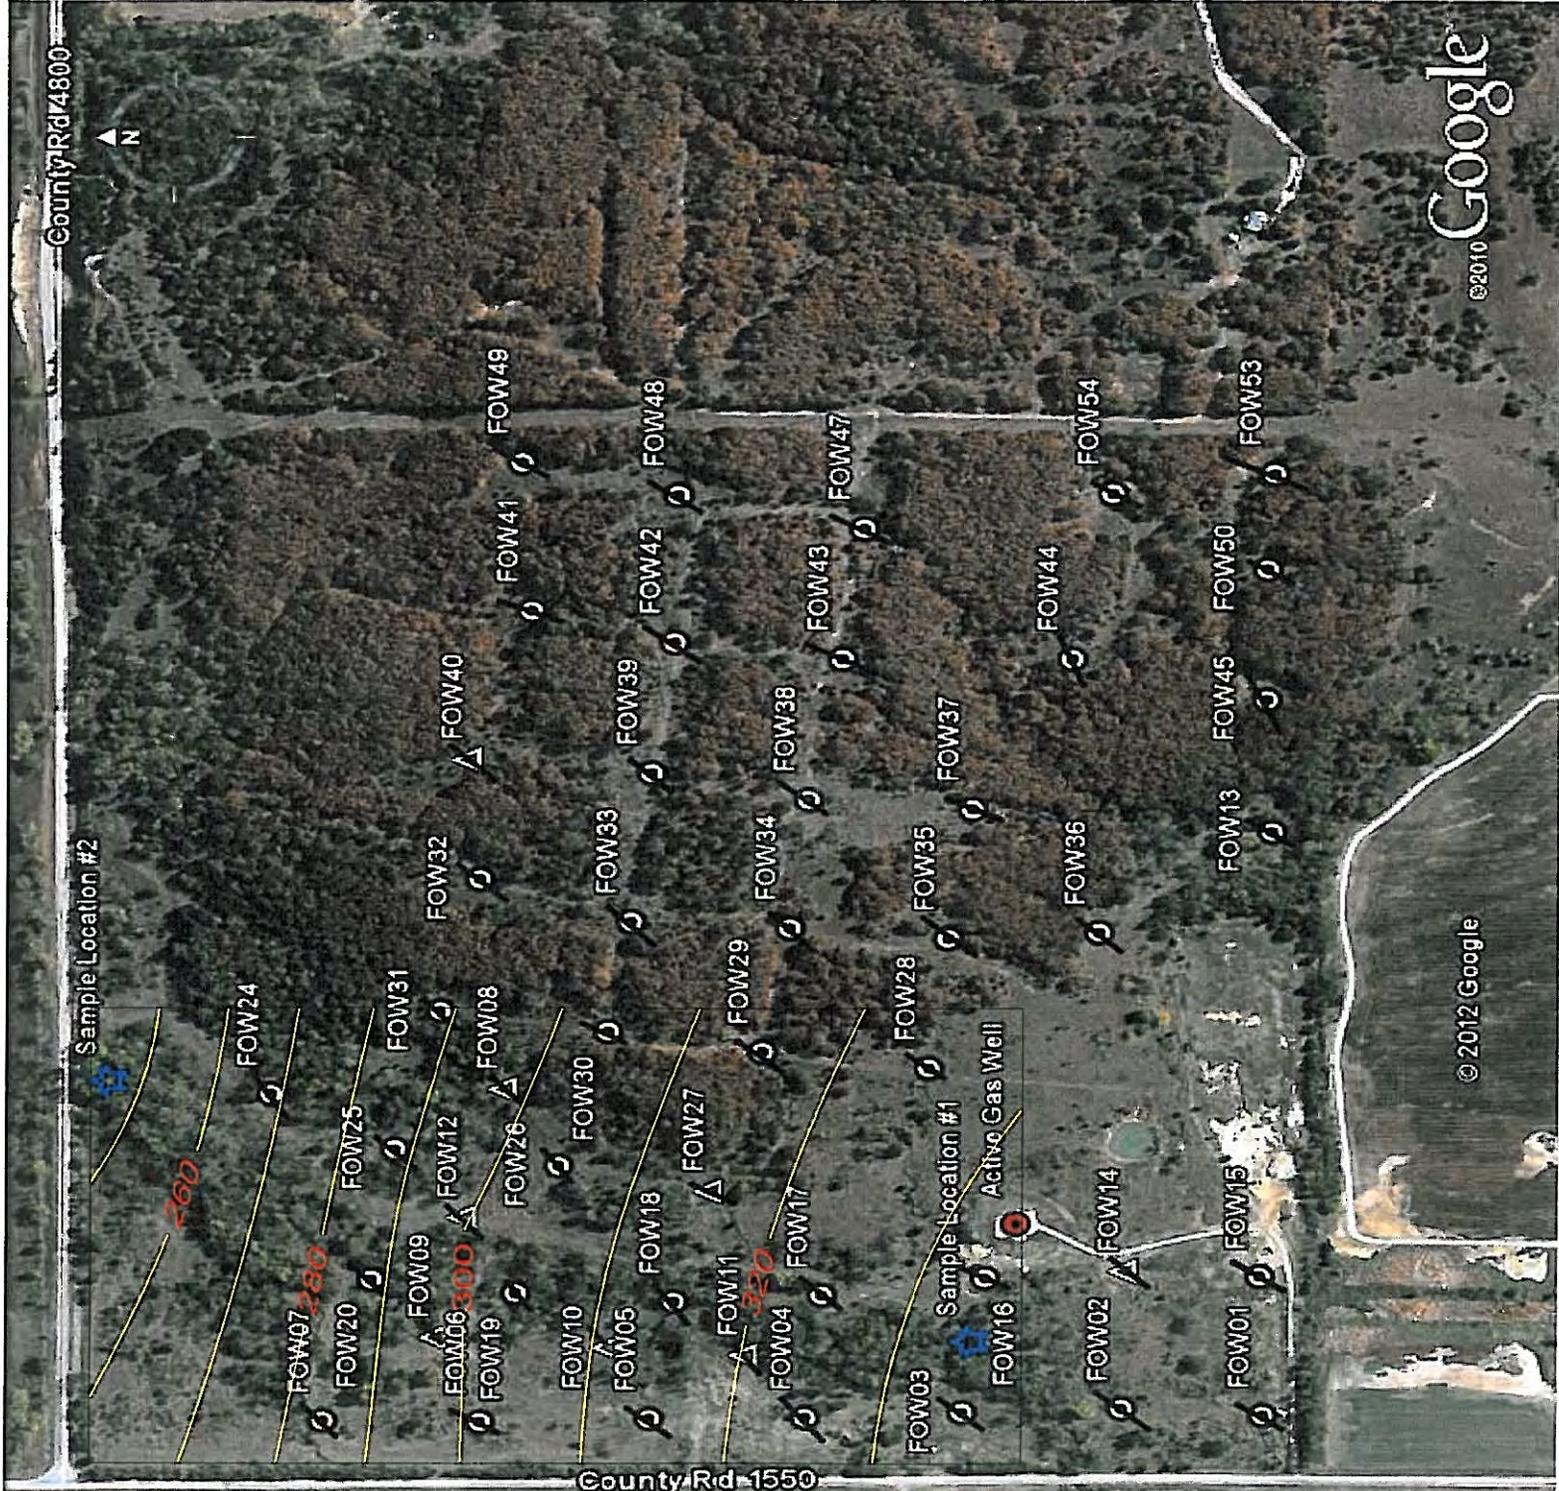

Project: French Contamination Site

Site Location: The site is located in Section 17, Township 23 South, Range 13 West, Stafford County.

Impact / Immediacy: Potential exists for impacts on stock and irrigation resources. Subsidence around the French "A" 1 has developed into a sinkhole. Worst-case scenario would be a catastrophic collapse taking part of an east-west county road and several acres of farm ground. Probable action is a gentle downward movement of the area until stable. The site has a moderate to high rating.

Site Description: The site consists of an unplugged saltwater disposal well whose operation led to the development of a solution cavity. The site is located in a rural setting 330' north of a county road. Land use is agricultural with oil activities in the area. The subsidence at the site now covers an area of approximately 600 x 1000' in size.

Unusual Problems: A solution cavity was determined to exist under the existing location by a seismic survey conducted by the KGS. The seismic survey indicates the cavity is approximately 60' thick.

Status of the Project: Elevations were shot on 9/30/2013. On average, the sinkhole dropped 1.13 feet this year. The majority of the drop is in the eastern part of the sinkhole, with the most dramatic drop to the northeast. The eastern part of the sinkhole is dropping quicker than in the recent past. The seismic that was shot over it would indicate that the sinkhole will continue to subside to the east. The western part of the sinkhole did not move any during the past year. No survey data was obtained in 2014. Updating survey data is planned for the spring of 2015.

Level of Remediation Sought:

Ideal: Stabilize cavity and plug well bore in accordance with KCC rules and regulations.

Target: Safely monitor site. Determine an acceptable plugging procedure, which will adequately address groundwater resources.

Recommendations for Future Work: Monitor stock wells and irrigation wells to the southeast of the depression. Resume the semi-annual survey of the site to establish a current rate of subsidence. Monitor possible second depression to the southeast of the original depression.

Estimated Total Costs: \$3000.00

Control No.	Staff Hours/Expenditures	Fund Expenditures	
		FY 2014/15	Total
990002-001	2 Hrs. / \$59.46		\$346.50
Current Contaminate Level: Unknown.			
Status:			
<input type="checkbox"/> 1. Site Assessment	<input type="checkbox"/> 2. Short Term Monitoring	<input checked="" type="checkbox"/> 3. Investigation	
<input checked="" type="checkbox"/> 4. Long Term Monitoring	<input type="checkbox"/> 5. Remediation Plan	<input type="checkbox"/> 6. Installation	
<input type="checkbox"/> 7. Remediation	<input type="checkbox"/> 8. Post Rem. Monitoring	<input type="checkbox"/> 9. Resolved	




French Sinkhole

SW/4 Section 17-T23S-R13W
Stafford County, Kansas

Change in Elevation Map-Shot 9/30/2013

KCC Control # 970002-001 District 1
D. Sellers 10/01/2013

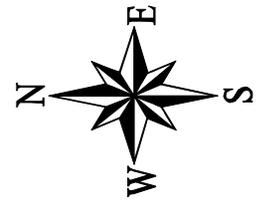

Project: Galva City Area Contamination Site

Site Location: This contamination site is located in Section 15 and 22 of Township 19 South, Range 2 West, which is half mile north and quarter mile east of Galva City in McPherson County.

Impact/Immediacy: This site has been up graded to a high level of immediacy. Groundwater has been impacted and the potential for contamination to domestic and the **public water supply** at Galva City is very high. A water sample was taken from Galva City Well #3 in July 2006 and the chlorides tested 460 mg/l, 2007 tested 1170 mg/l and in July of 2008 tested 1200 mg/l. A Sample of the same public supply well was taken in 2011 and tested to be 670 mg/l. A sample was not available for 2014.

Site Description: The site is located in a rural area with topography of gentle sloping fields with a small drainage stream located east and west of site with the flow from the north to the southwest. This site is in the Ritz-Canton oil field, which has a past history of utilizing brine pits for the disposal of brine from the wells. The depth to the ground water is 17 +/- feet and the bedrock or aquitard should be encountered at a depth of 60 feet. There are buried paleo-channels in the area where the bedrock is encountered at approximately 90 feet which usually hold the highest chloride levels close to the top of the Wellington Shale. KCC has operated a recovery system at this site since 2005.

Unusual Problems: The disposal well will not take the amount of fluid necessary run all four recovery wells at the same time. High Chloride water deteriorates metal pumps, fittings, etc. Recovery pumps have short life spans and the local groundwater has high levels of iron which clog up lines and equipment.


Status of Project: During the first week of August 2014 KCC performed the start of a Phase III package which included the installation of 5 monitoring wells and 1 recovery well. This was done to further investigate possible source locations, delineate the known plume, and improve the remedial efforts close to the city of Galva. Data obtained from these additional wells shows a strong chloride source to the east/northeast of the remedial site in section 14. There are multiple suspected pits in that section, including the prior location of a distillation refinery and associated pits that were operational in the forties. Chloride distribution north and northeast of the city of Galva is found to be widespread and monitoring wells installed attempting to delineate the plume on the west side of section 15 were unsuccessful. Chlorides weaken substantially to the west but were still in the 4000 mg/L range along the north-south road that intersects the main town. It appears that chlorides are following the paleo-valley slope (top of the Wellington Formation) that is located northeast of Galva and pooling. There is a paleo high directly below the City and its PWS wells. This suggests being the only reason that the public water supply is still viable, as brine water is settling in the lower zones of the aquifer. The extremely high chlorides across the site showed stability during 2014 except for the monitoring wells within the radius of influence of the recovery system which have decreased. Recovery well sampling have shown a drop in chlorides in all the recovery wells over the lifetime of the system. A total of 18,357,000 gallons (437,071 barrels) of brine impacted water was recovered by the system from January 2014 to November 2014.


Level of Remediation Sought:
Ideal: 250 mg/l chlorides
Target 500 mg/l chlorides

Recommendations for Future Work: KCC will be putting together a follow up scope of work to continue with the Phase III started in 2014. Main focus of future work will be to the direction of the old refinery site and to the east of the remedial system. Evidence has shown a strong possibility that the refinery and its associate pits are large sources of the brine contamination that is encroaching on the City of Galva. Bedrock orientation as well as chloride levels in MW-114 support this idea. KCC will be looking into the possibility of multiple monitoring well and possible recovery well installations during the next phase. If more supporting evidence is found regarding the source potential of the refinery, KCC will contact KDHE as the refinery is listed as a no further action KDHE site. KCC will continue to look for new ways to expand the disposal capacity of the recovery system to further increase the effectiveness of it on the plume.

Estimated Total Costs: Regular annual costs are approximately \$3500-5000. This includes Field work addressing, modifying, or repairing the remediation system, system inspection, groundwater sampling, research, and report writing. The continued Phase III work would cost in the \$20,000-30,000 range.

Control No.	Staff Hours/Expenditures	Fund Expenditures	
		FY 2014/15	Total
980033-001	449 Hrs. / \$11,908.87	\$29,949.35	\$266,736.01
Current Contaminate Level: 32,500 mg/l (MW 401) to 3,000 mg/l (MW 214) chlorides for 2014			
Status:			
<input type="checkbox"/> 1. Site Assessment	<input type="checkbox"/> 2. Short Term Monitoring	<input checked="" type="checkbox"/> 3. Investigation	
<input checked="" type="checkbox"/> 4. Long Term Monitoring	<input type="checkbox"/> 5. Remediation Plan	<input type="checkbox"/> 6. Installation	
<input checked="" type="checkbox"/> 7. Remediation	<input type="checkbox"/> 8. Post Rem. Monitoring	<input type="checkbox"/> 9. Resolved	

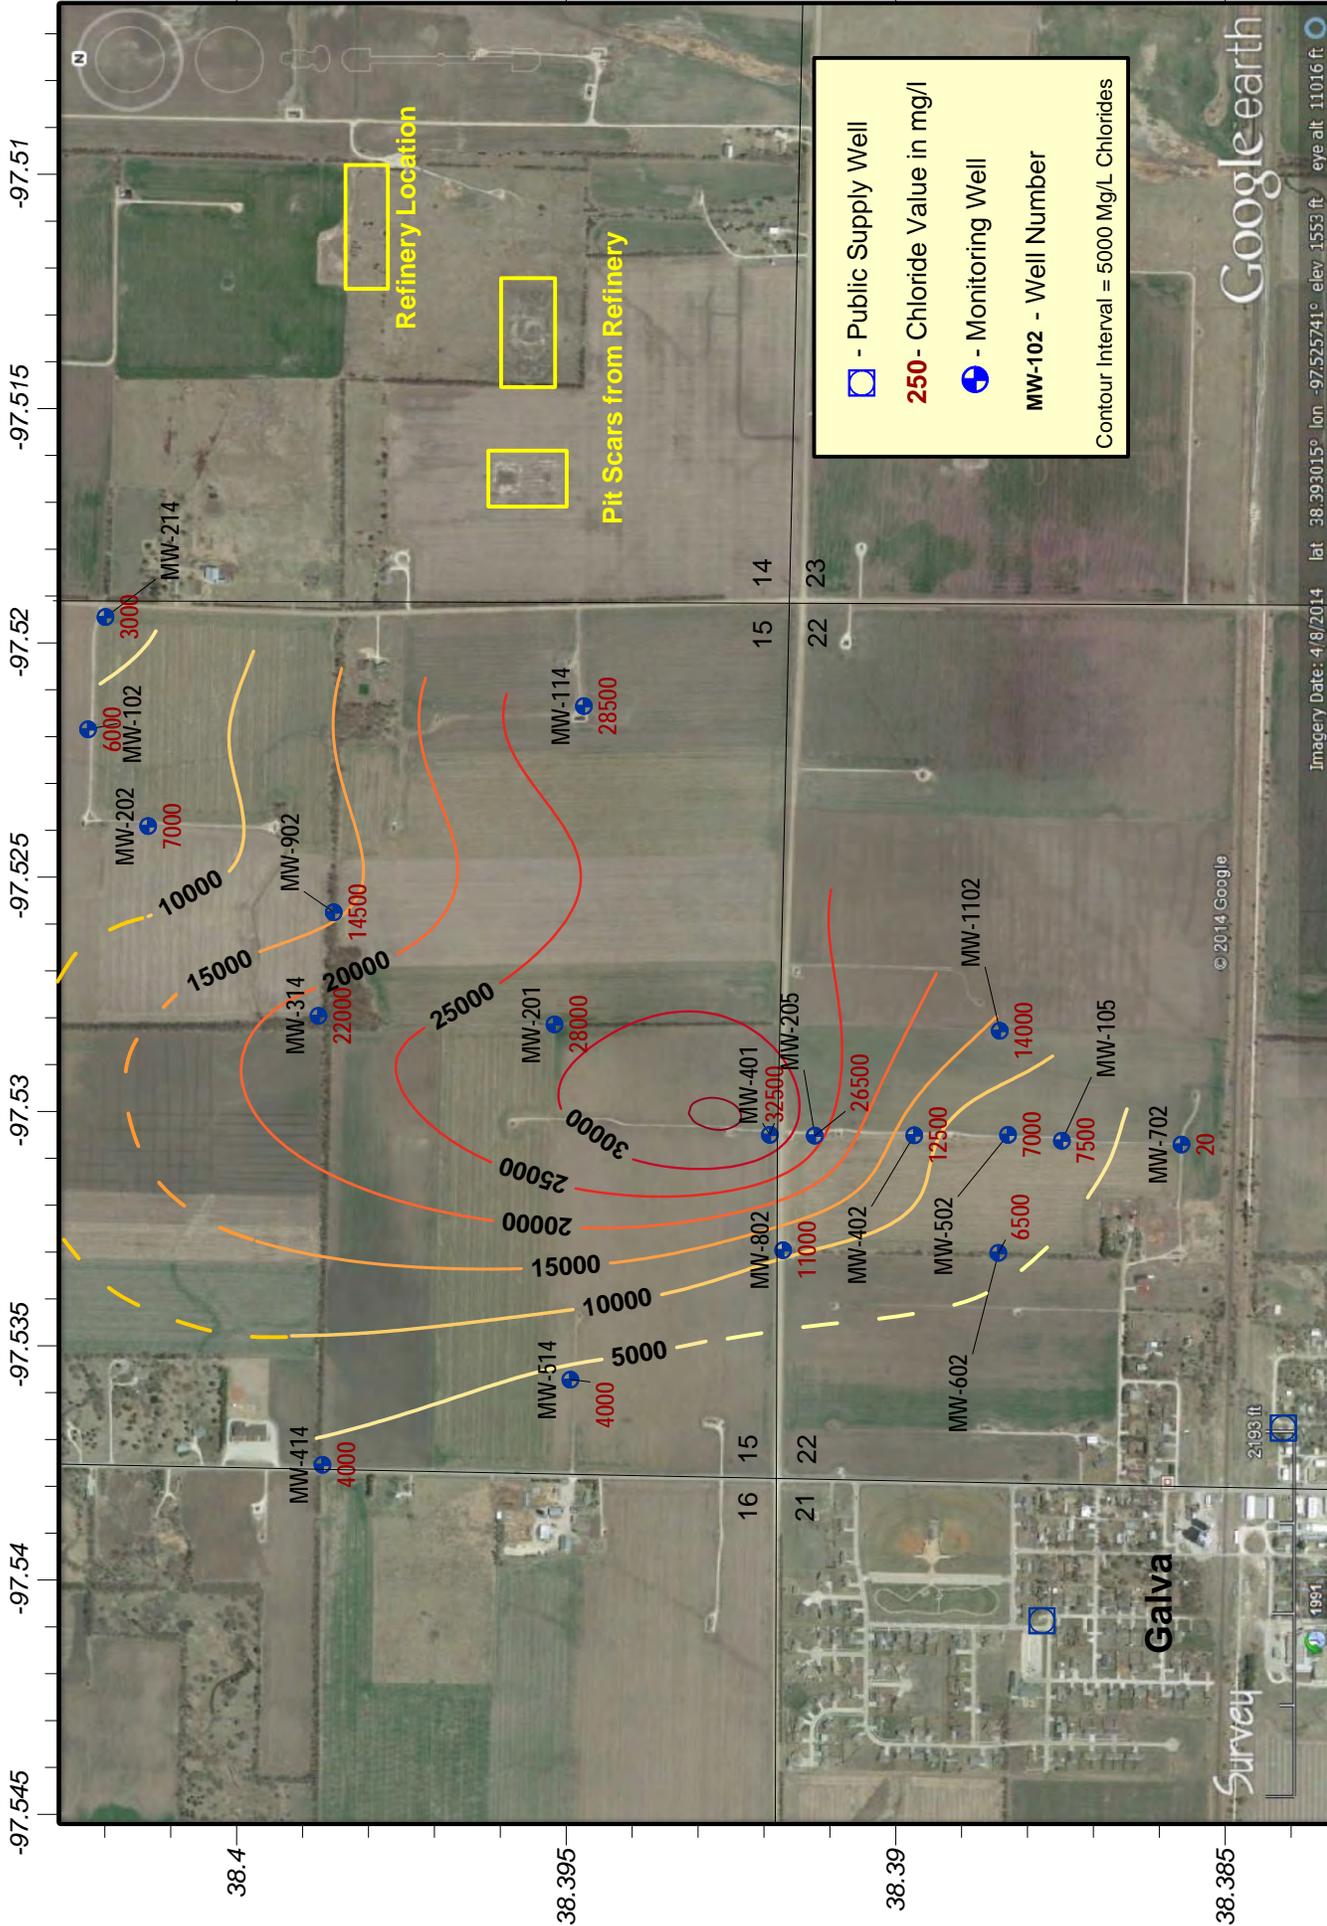


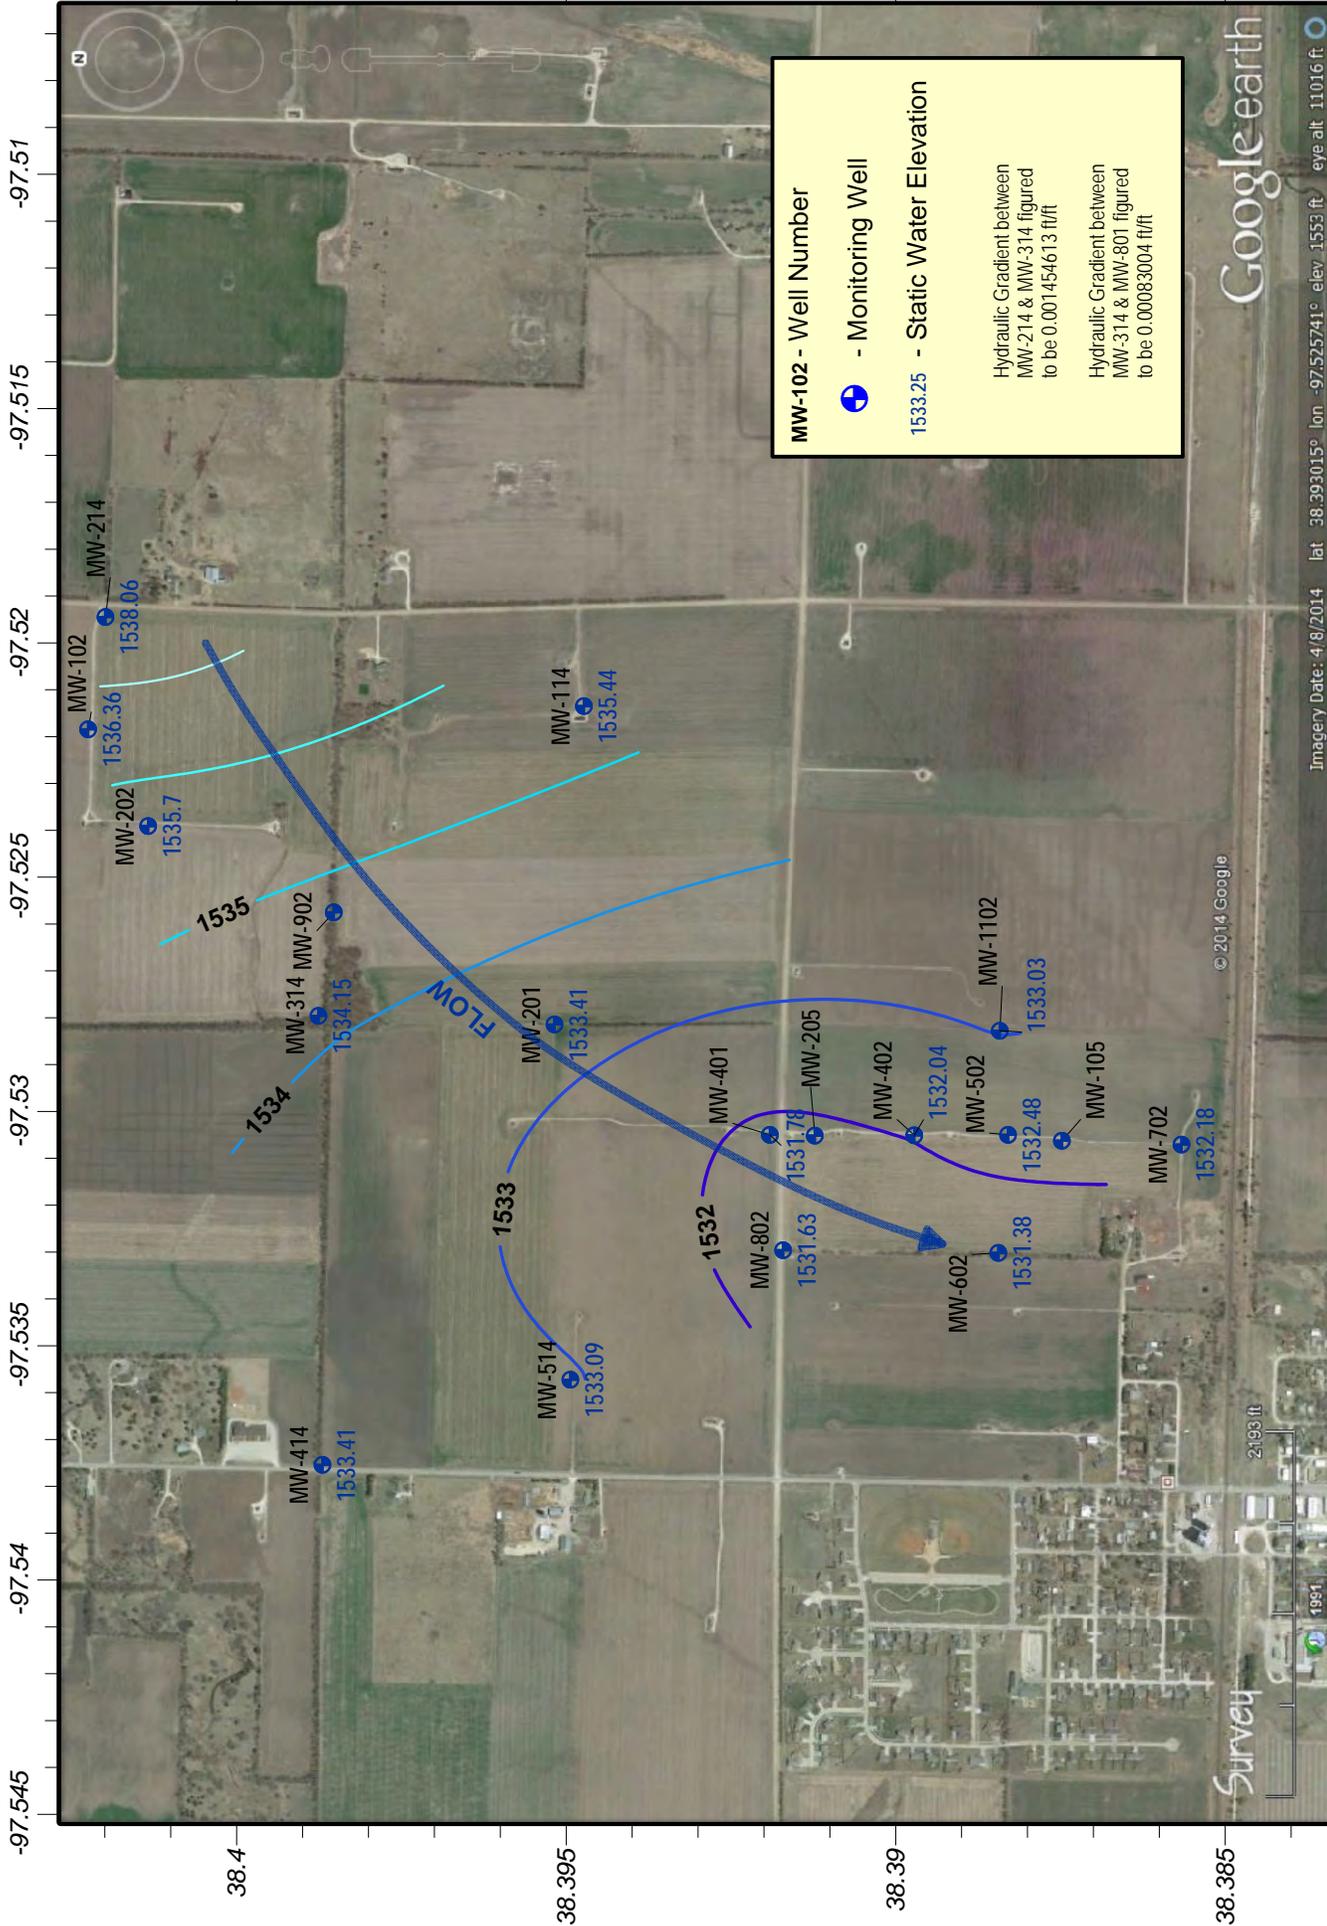

Google earth

Imagery Date: 4/8/2014 lat: 38.393015° lon: -97.525741° elev: 1553 ft eye alt: 11016 ft

Galva City Contamination Site
 Sec. 15, 16, 21, & 22 - T19S - R2W, McPherson County
2014-15 Groundwater Elevation Map
 KCC Control #990033-01 - District #2 - D.Bollenback - 11/17/2014

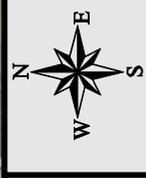

Survey

2193 ft

© 2014 Google




Imagery Date: 4/8/2014 lat: 38.388750° lon: -97.531471° elev: 1552 ft eye alt: 5196 ft

Galva Remediation Site
Recovery Well Locations and Site Map

Kansas Corporation Commission District #2 Field Office - Map drawn on 11/19/2014 by D. Bollenback



9/27/2014 11:16:39 am

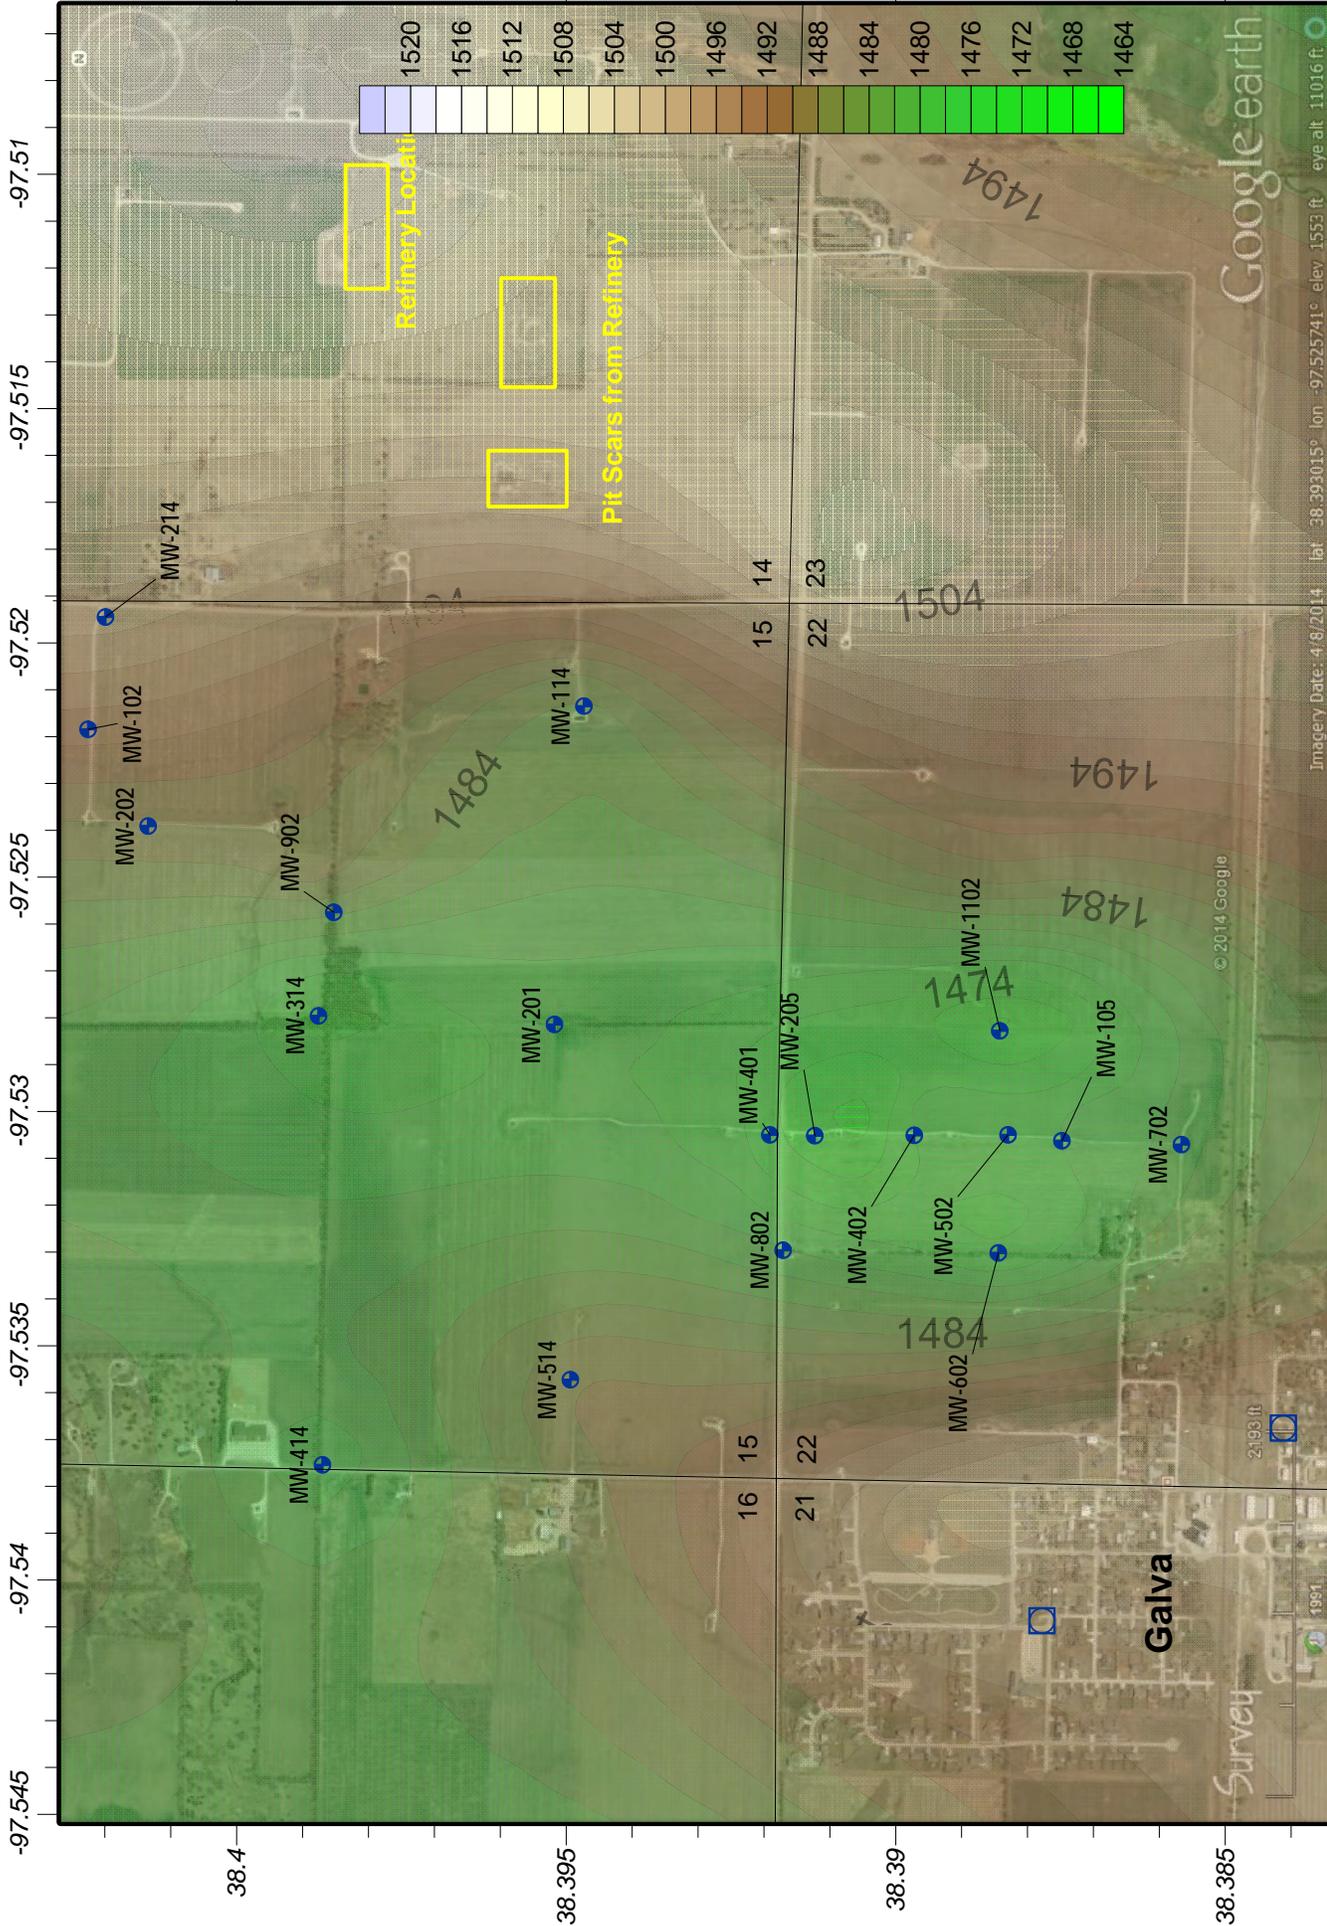

Imagery Date: 4/8/2014 lat: 38.393015° lon: -97.525741° elev: 1553 ft. eye alt: 11016 ft.


Galva City Contamination Site
 Sec. 15, 16, 21, & 22 - T19S - R2W, McPherson County
2014-15 Top of Wellington Formation
 KCC Control #980033-01 - District #2 - D.Bollenback - 9/22/2014



2014 Galva Remediation Site - KCC Control Number #980033-001 - Fluid Recovery Tables

Well No.	Start	Meter	Gallons /month	Totals														
	2013																	
RW-1	50816100	50816100	0	50816100	0	50816100	0	50816500	400	50816900	400	50816900	400	50816900	0	50816900	0	800
RW-2	74142400	74143200	800	76184000	2040800	76184000	0	77930600	1746600	77931000	400	78005700	400	78005700	74700	78005700	74700	3788600
RW-3	89527300	91270400	1743100	91453300	182900	93182200	1728900	93676000	493800	95375000	1699000	97002000	1627000	97002000	1627000	97002000	1627000	5847700
RW-4	15387900	15387900	0	15387900	0	15387900	0	15387900	0	15387900	0	15387900	0	15387900	0	15387900	0	0
Well No.	Start	Meter	Gallons /month	Totals														
	2nd half																	
RW-1	50816900	50816900	0	50817200	300	50817200	0	50817200	0	50817200	0	50817200	0	50817200	0	50817200	0	300
RW-2	78005700	78557100	551400	80098800	1541700	81177300	1078500	81177300	0	81177300	0	81177300	0	81177300	0	81177300	0	3171600
RW-3	97002000	97002000	0	98508100	1506100	99397000	888900	100729600	1332600	100729600	0	100729600	0	100729600	0	100729600	0	3727600
RW-4	15387900	15387900	0	15506600	118700	15506600	0	15506600	0	15506600	0	15506600	0	15506600	0	15506600	0	118700

	Jan	Feb	March	April	May	June	July	Aug	Sept	Oct	Nov	Dec	Totals
RW-1	0	0	0	400	400	0	0	300	0	0	0	0	1100
RW-2	800	2040800	0	1746600	400	74700	551400	1541700	1078500	0	0	0	7034900
RW-3	1743100	182900	1728900	493800	1699000	1627000	0	1506100	888900	1332600	0	0	11202300
RW-4	0	0	0	0	0	0	0	118700	0	0	0	0	118700
Total	1743900	2223700	1728900	2240800	1699800	1701700	551400	3166800	1967400	1332600	0	0	18357000

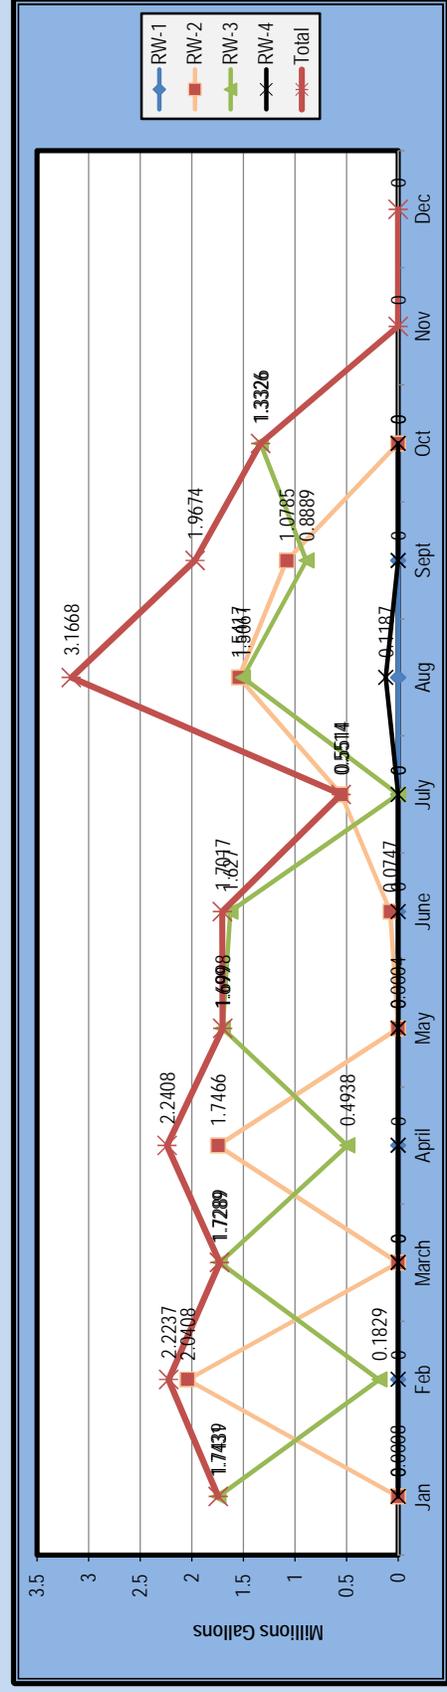

Project: Albert Harbaugh Contamination Site

Site Location: Legal location is the SE/4 Section 20 & NE/4 Section 29, Township 33 South, Range 11 West, Barber County.

Impact/Immediacy: The groundwater for domestic and stock wells has been contaminated from several sources on this project. This site is rated as high immediacy and remediation of the groundwater began on November 1, 1999.

Site Description: The site is located in the alluvial valley on the flood plain of the Medicine River, in the Rhodes Pool, approximately nine miles south of Medicine Lodge. This site covers an area of approximately 1000 feet wide and 3500 feet long. This location and others sites in the area are continually increasing the chlorides in the groundwater aquifer of the Medicine River valley.

Unusual Problems: It is probable that all source areas of natural halite pollution into the aquifer have not been identified. Areas of suspected sources have not continued to contribute to the contamination since the remediation of the ground water has been implemented. These areas are suspected to have achieved a natural closure at this time. Unless all the source areas are located and plugged, the contamination will continue until there is natural closure.

Status of Project: Project is shut-in waiting on repairs to the recovery well header systems and acid treatment stimulation on the disposal well. Thirty monitoring and recovery wells were sampled in 2014. One stock well has been sampled annually as well. Chloride values in the northwest corner of the site continue to be elevated at unacceptable levels, with values ranging from 6000 ppm in RW-1 to 1600 ppm and 1300 ppm respectively in monitoring wells 13 and 26. An unidentified flowing core hole near these wells is the probable source of these chlorides with other sources contributing additional contamination across the rest of the remediation site. Differences in chloride values of wells in close proximity to each other are attributed to different screening depths. MW 25, MW 27, and MW 32 need repairs. Documentation for a possible bid to restore the northwest corner of the remediation system was submitted to the main conservation office. No answer has been received as to if or when this might occur.

Level of Remediation Sought:


Ideal: 250 ppm Chloride

Target: 1000 ppm Chloride

Recommendation for Future Work: Obtain funds for well treatment and infrastructure repairs. Monitor the recovery well system for effectiveness of chloride plume containment. Continue annual sampling of monitor wells and bimonthly sampling of the recovery wells after they have been restarted.

Estimated Total Cost: Total costs have exceeded the original estimate of \$450,000. Costs for repairs are estimated at close to \$30,000.

Control No.	Staff Hours/Expenditures	Fund Expenditures	
		FY 2014/15	Total
970049-00	59.5 Hrs. / \$1,548.14	\$950.00	\$536,980.90
Current Contaminate Level: 210 ppm Cl- to 6,000 ppm Cl-			
Status:			
<input type="checkbox"/> 1. Site Assessment	<input type="checkbox"/> 2. Short Term Monitoring	<input checked="" type="checkbox"/> 3. Investigation	
<input checked="" type="checkbox"/> 4. Long Term Monitoring	<input type="checkbox"/> 5. Remediation Plan	<input type="checkbox"/> 6. Installation	
<input type="checkbox"/> 7. Remediation	<input type="checkbox"/> 8. Post Rem. Monitoring	<input type="checkbox"/> 9. Resolved	

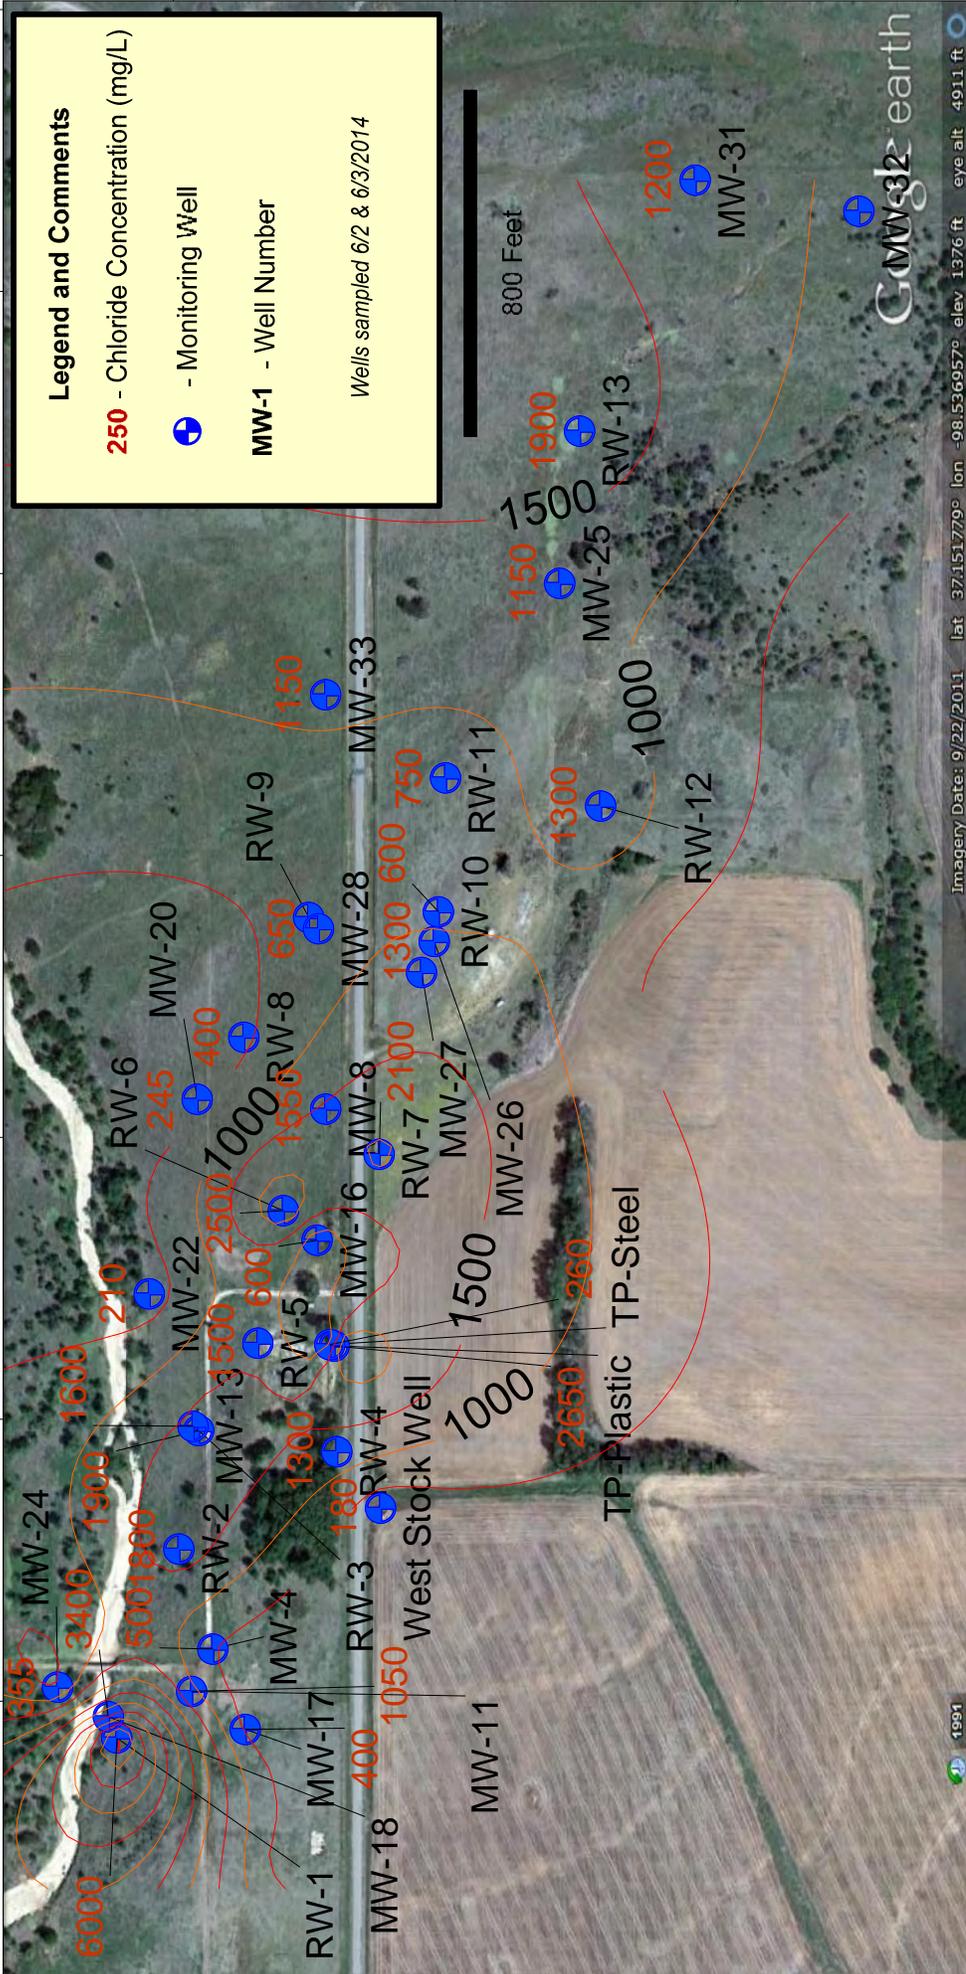


Legend and Comments

- 250** - Chloride Concentration (mg/L)
- Monitoring Well
- MW-1** - Well Number

Wells sampled 6/2 & 6/3/2014

Harbaugh Site
 Sections 20/29-T-33S-R11W
 Barber County, Kansas
2014-2015 Area Map with Chlorides
 KCC Control # 970049-00 District 1
 D. Sellers 6/12/14

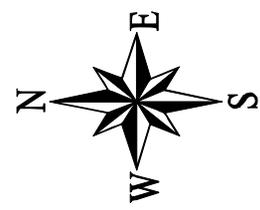

Project: *Hollow-Nikkel Contamination Site*

Site Location: The site is located in northwestern Harvey County approximately eighteen miles northwest of the city of Newton. The site includes parts of Sections 7, 8, 17, 18, 19, 20, 29, and 30 in Township 22 South, Range 3 West. This site is located within the Equus Beds Aquifer boundaries.

Impact: Potential impact is to irrigation and rural residential wells. Directly down gradient of the site there are nine domestic wells and irrigation well. This site should be rated at a moderate immediacy level.

Site Description: The project area covers approximately 700 acres with chloride values ranging from 5 to 6900 mg/l in the lower zone of the aquifer. The contaminate plume is aligned in a north to south configuration and is approximately .5 mile wide and 2 miles in length. Plume morphology appears to be controlled by a bedrock channel, which has an alignment similar to that of the plume. Contamination mapped to date is primarily confined to the lower zone of the Equus Beds aquifer, which consists of unconsolidated sand and gravel deposits and lies at a depth of 200 to 250 feet. The location near EB-34 is contaminated throughout all three zones of the aquifer.

Unusual Problems: In order to remediate this site, the planning, land access acquisition, and development of a good water disposal method would be very time and financially intensive.

Status of the Project: The Ground Water Management District #2 has been contracted to do annual water sampling with the KCC funding the analysis of the water samples. The plumes in the A, B, and C zones appear to be relatively stable. Research into the northeast chloride level increase near EB-27 was begun by the District #2 Office in 2014. The City of McPherson, GMD#2, and the Kansas Water Office approached the KCC during the 2014 year in regards to the possibility of utilizing the local aquifer to supplement the City of McPherson's public water supply. KCC promised support in this endeavor in terms of personnel resources and expertise. Depending on the results from modeling and further study a remedial system could be necessary to allow for water to be shipped out of the area for public use. KCC understands that funding for this project by the City of McPherson may have stalled and continued research and work regarding the city's plans is on hold unless McPherson moves forward with plans in the area.

Level of Remediation Sought:


Ideal: 250 mg/l

Target: 500 mg/l

Recommendations for Future Work: KCC will continue to collect data from GWD #2 on an annual basis for monitoring purposes. Continued research and investigation into the northeastern site area of chloride level increase should be maintained. If the City of McPherson resumes their water project, KCC will allocate their professional expertise and similar resources to aid McPherson's research and planning.

Estimated Total Costs: Time for district personnel to put together and analyze groundwater data obtained from GMD #2 plus research possible remediation avenues. Cost of staff time could increase substantially if the City of McPherson resumes their interest in obtaining a new source of water in the area.

Control No.	Staff Hours/Expenditures	Fund Expenditures	
		FY 2014/15	Total
970009-00	155.5 Hrs. / \$4,006.36	\$2,460.12	\$34,782.77
Current Contaminate Level: Varies; There are hot spots in each zone.			
Status:			
<input type="checkbox"/> 1. Site Assessment	<input type="checkbox"/> 2. Short Term Monitoring	<input type="checkbox"/> 3. Investigation	
<input checked="" type="checkbox"/> 4. Long Term Monitoring	<input type="checkbox"/> 5. Remediation Plan	<input type="checkbox"/> 6. Installation	
<input type="checkbox"/> 7. Remediation	<input type="checkbox"/> 8. Post Rem. Monitoring	<input type="checkbox"/> 9. Resolved	

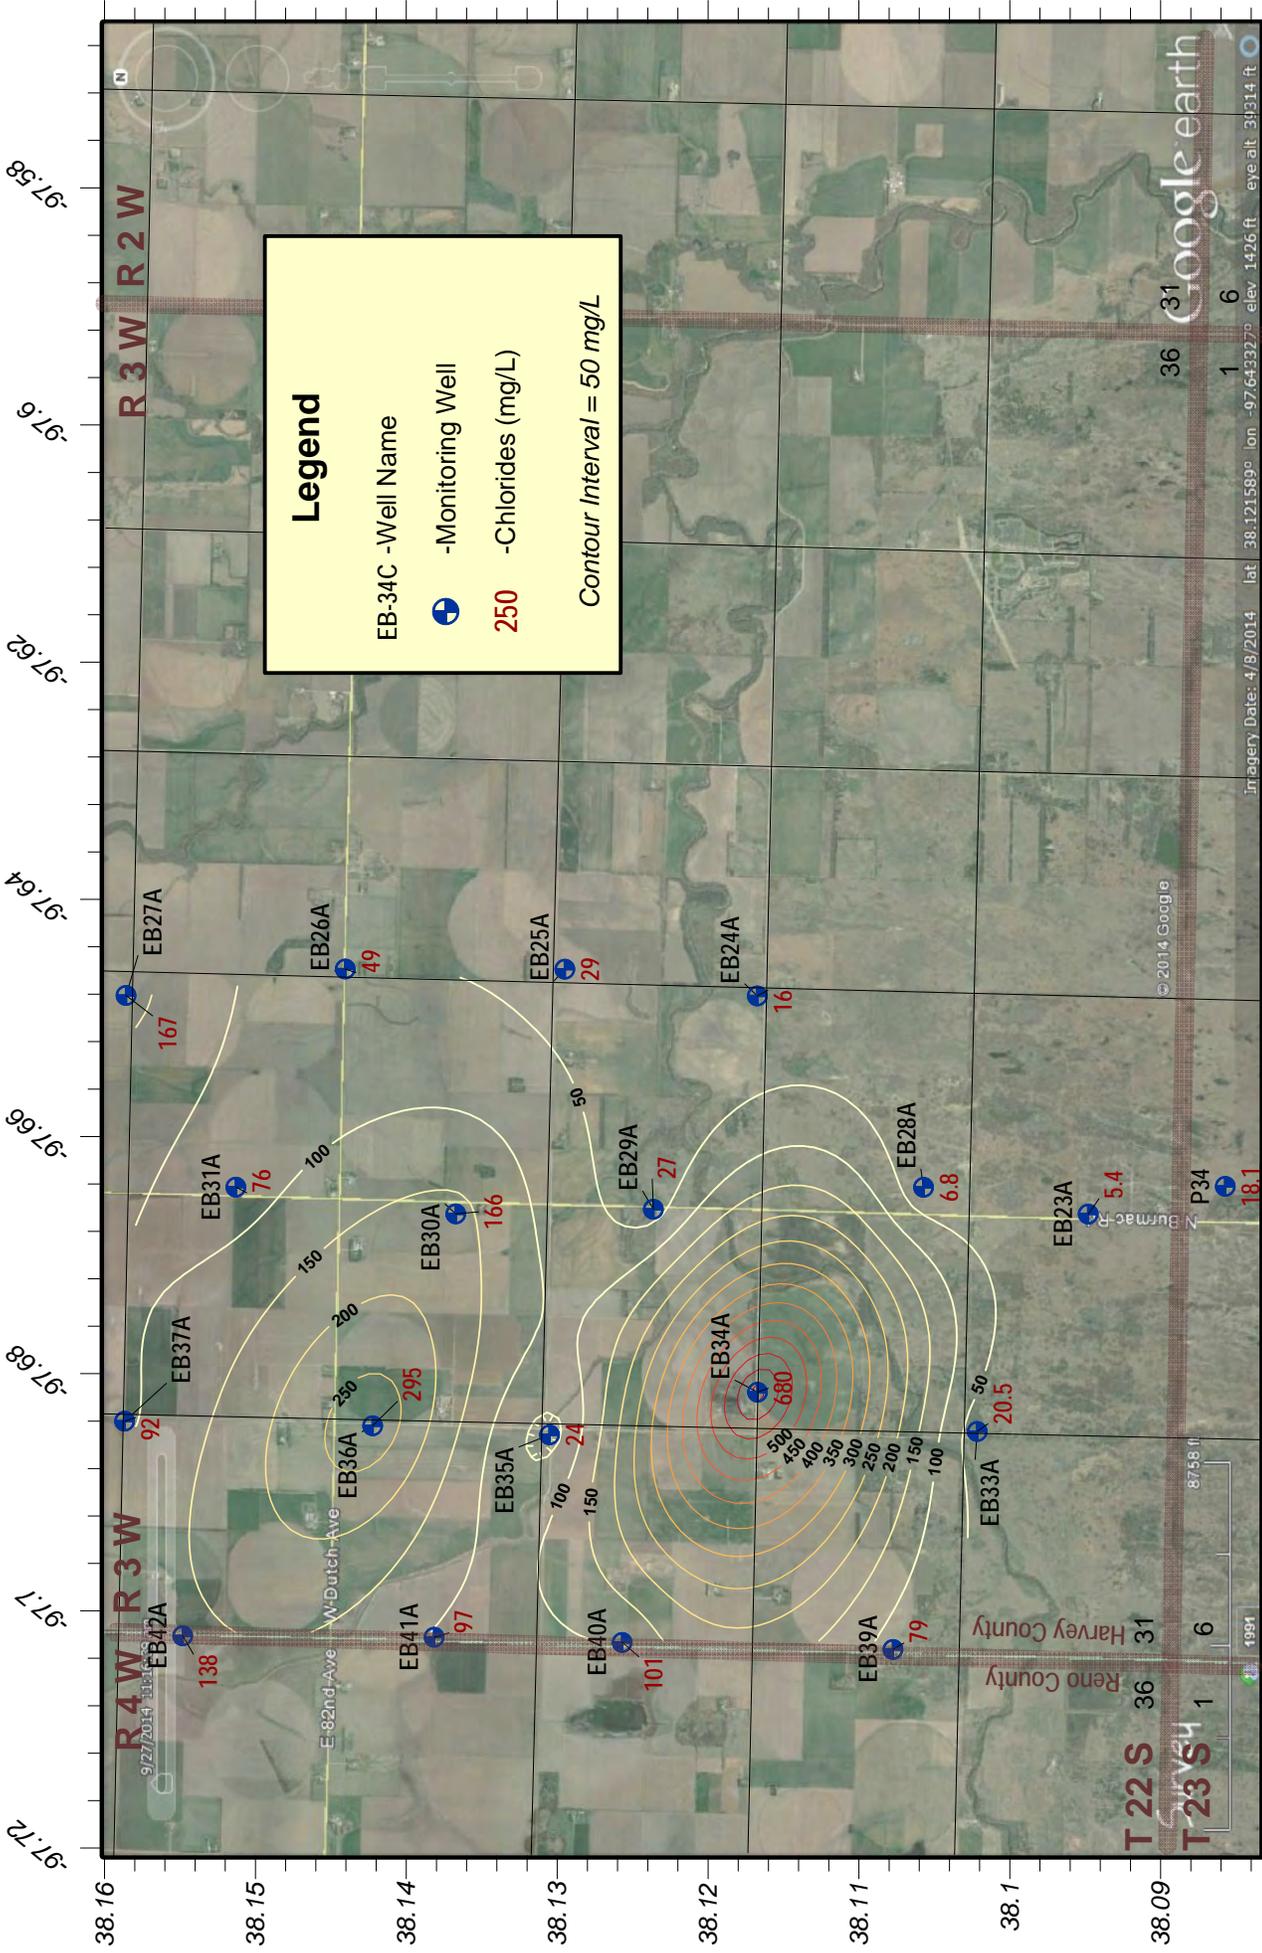

Hollow-Nikkel Brine Contamination Site - KCC Control #970009-00
 Multiple sections of Townships 22 & 23 South and Range 3 West, Harvey County, Kansas
2014-15 Chloride Levels in the Equus Beds A Zone
 KCC District #2 Field Office - Wells sampled Summer of 2014 by GMD #2 - Map Drawn on 11/13/2014 by D. Bollenback



38.16 38.15 38.14 38.13 38.12 38.11 38.1 38.09

97.72 97.71 97.68 97.66 97.64 97.62 97.58

R 4 W R 3 W R 3 W R 2 W

T 22 S T 23 S

36 31 6


1 6

8758 ft

1991

Harvey County

Reno County

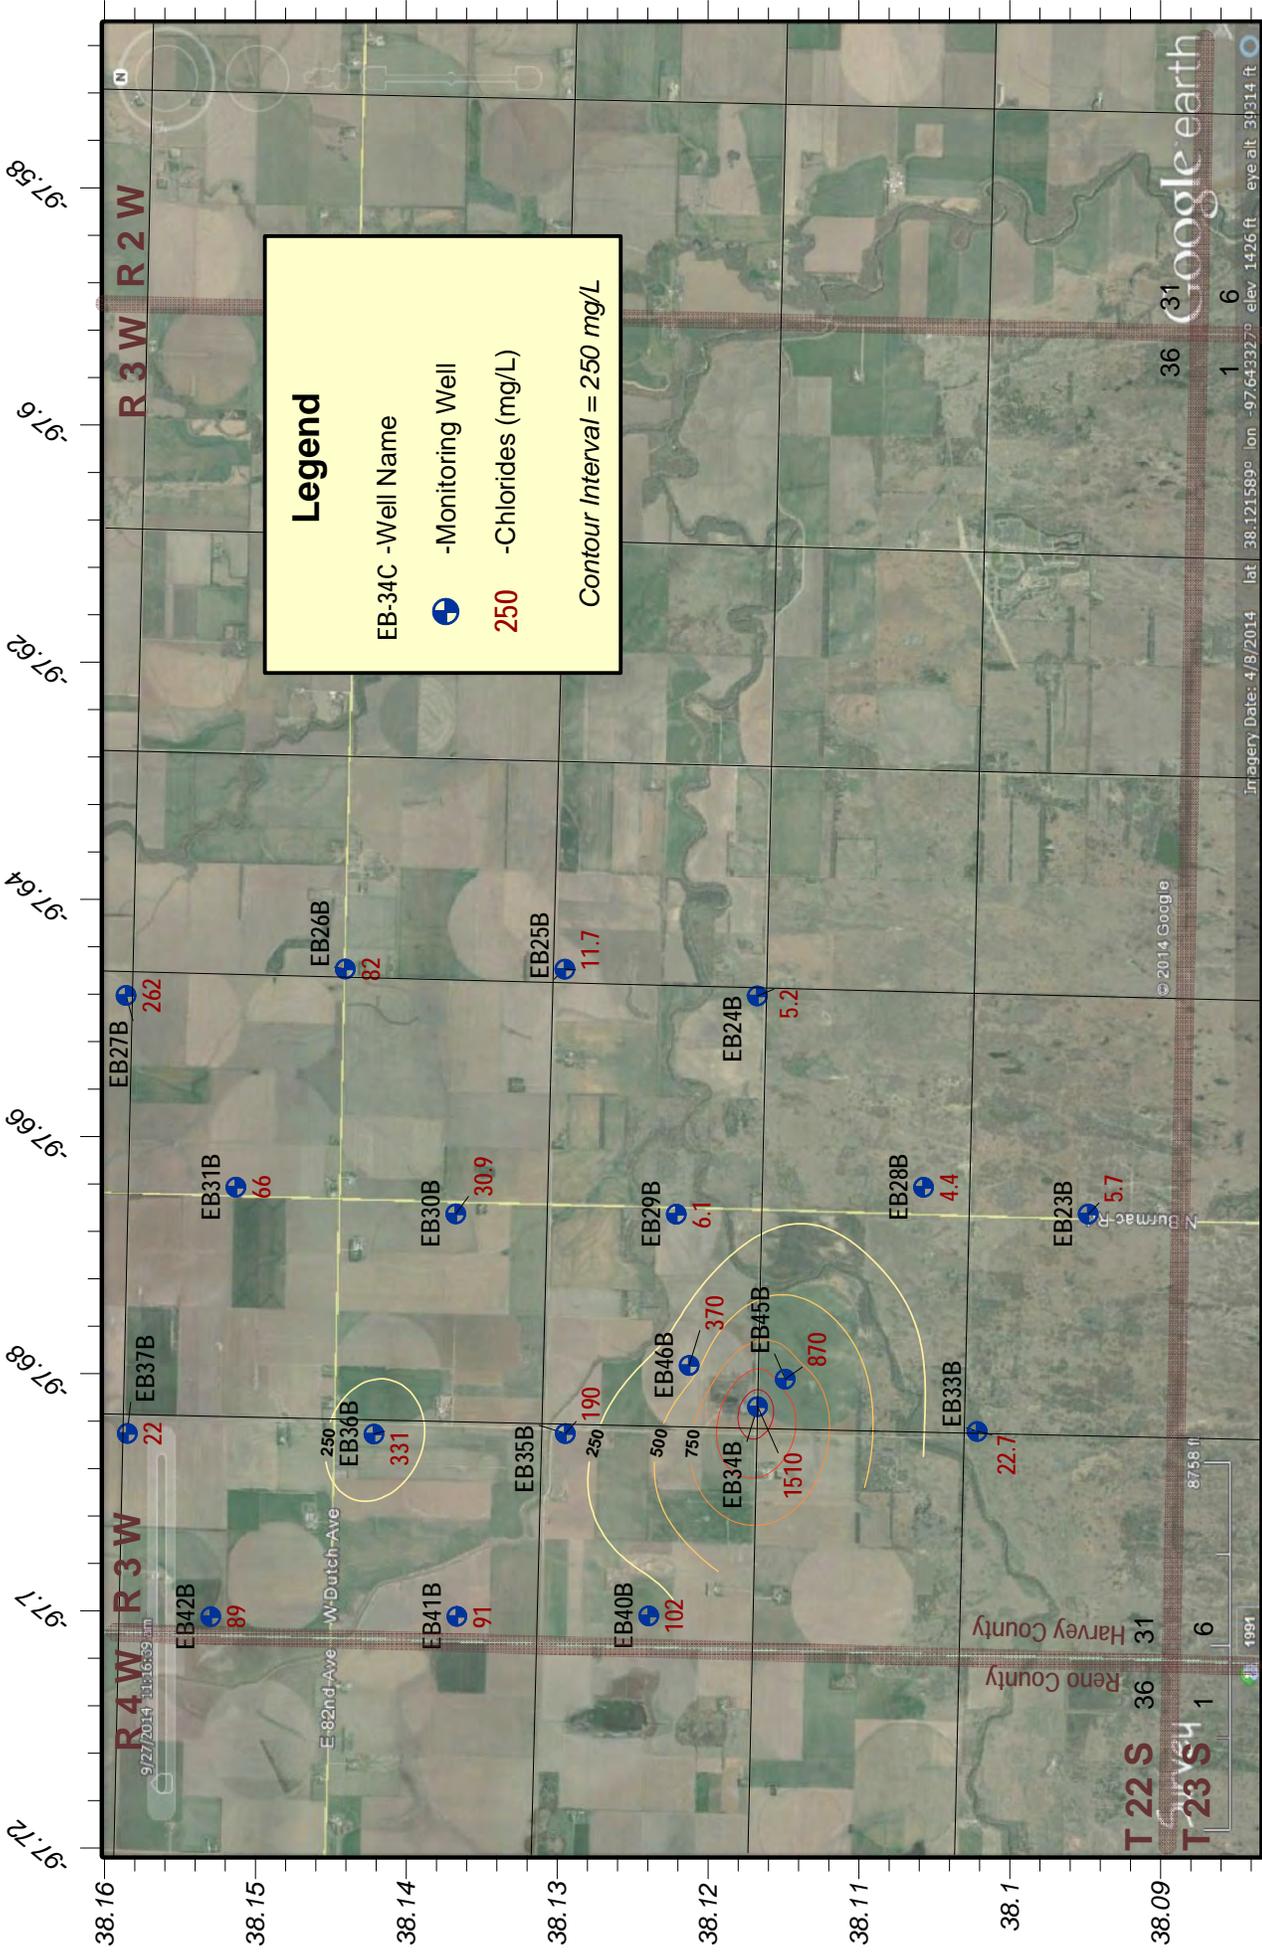

Legend

- EB-34C - Well Name
- Monitoring Well
- 250** - Chlorides (mg/L)

Contour Interval = 250 mg/L

Hollow-Nikkel Brine Contamination Site - KCC Control #970009-00
 Multiple sections of Townships 22 & 23 South and Range 3 West, Harvey County, Kansas
2014-15 Chloride Levels in the Equus Beds B Zone
 KCC District #2 Field Office - Wells sampled Summer of 2014 by GMD #2 - Map Drawn on 11/13/2014 by D. Bollenback



Imagery Date: 4/9/2014 lat 38.121589° lon -97.643327° elev 1426 ft eye alt 31314 ft



© 2014 Google

8758 ft
1991

T 22 S 36 31
T 23 S 4 1 6

Harvey County
Reno County

R 4 W R 3 W
9/27/2014 11:16:35 am

R 3 W R 2 W

E-82nd Ave W-Dutch Ave

250

8758 ft

1991

T 22 S 36 31
T 23 S 4 1 6

Harvey County
Reno County

E-82nd Ave W-Dutch Ave


250

8758 ft

1991

T 22 S 36 31
T 23 S 4 1 6

Harvey County
Reno County

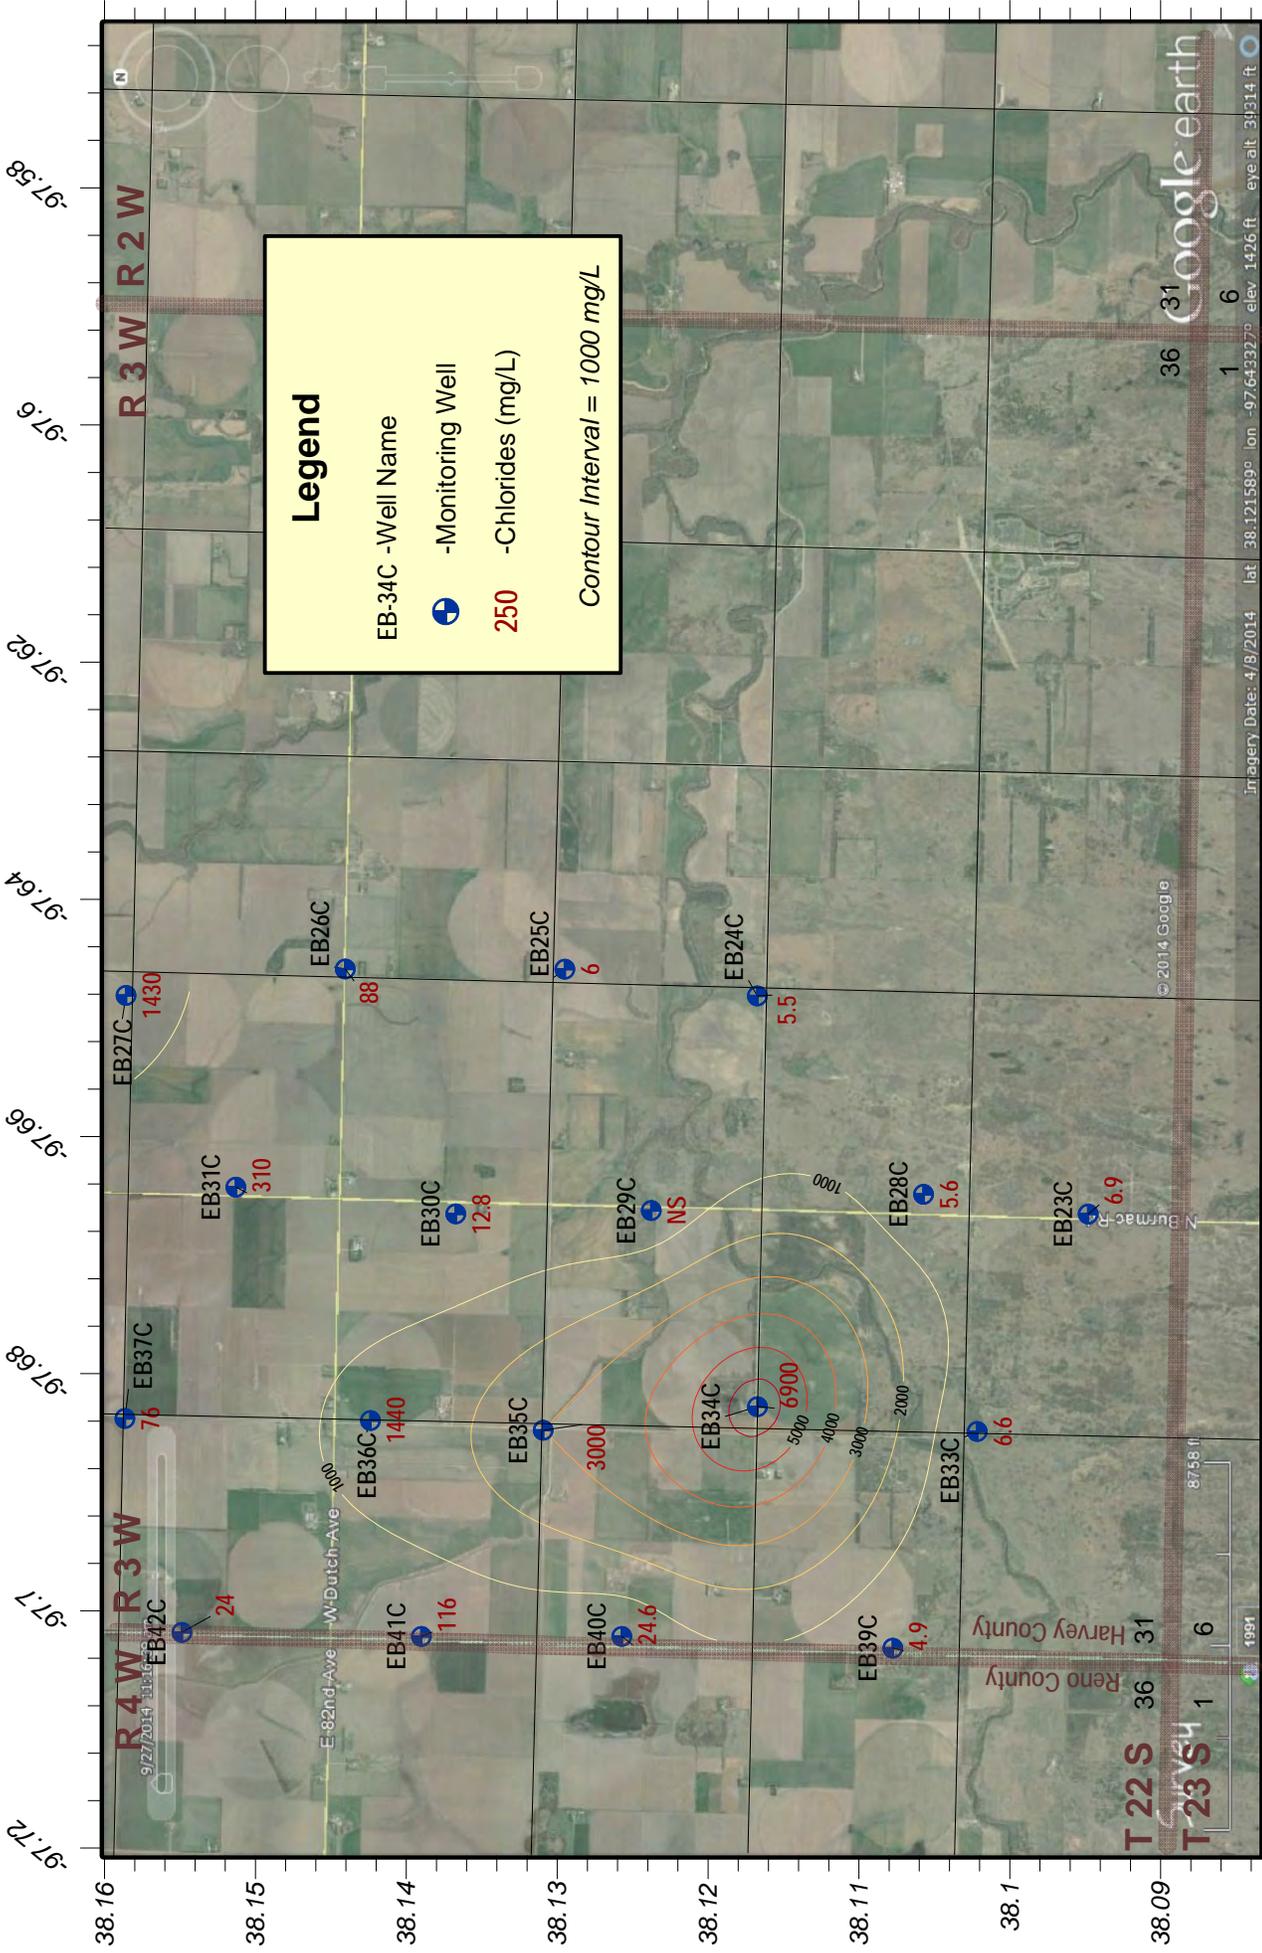


Legend

- EB-34C - Well Name
- Monitoring Well
- 250** - Chlorides (mg/L)

Contour Interval = 1000 mg/L

Hollow-Nikkel Brine Contamination Site - KCC Control #970009-00
 Multiple sections of Townships 22 & 23 South and Range 3 West, Harvey County, Kansas
2014-15 Chloride Levels in the Equus Beds C Zone
 KCC District #2 Field Office - Wells sampled Summer of 2014 by GMD #2 - Map Drawn on 11/7/2014 by D. Bollenback

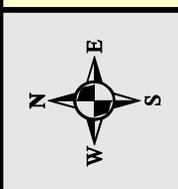

Imagery Date: 4/9/2014 lat 38.121589° lon -97.643327° elev 1426 ft eye alt 31314 ft

Google earth

© 2014 Google

8758 ft

97.72 97.76 97.80 97.84 97.88 97.92 97.96 97.99 97.58

38.16 38.15 38.14 38.13 38.12 38.11 38.10 38.09

R 4 W R 3 W R 3 W R 2 W

T 22 S T 23 S 36 31 6

Harvey County Reno County

Project: Hrencher Contamination Site

Site Location: Legal location is W/2 Section 36, Township 32 South, Range 12 West, Barber County.

Impact/Immediacy: The salt-water intrusion in the area affected the groundwater, small pond, stock wells and there is a salt scar near the pond. This site is classified as moderate to high for remediation.

Site Description: The surface area is predominately “red beds” of lower Permian age. The area is dissected by small drainage patterns and the alluvial channels filled with local parent material shale and gypsum. The area of high chlorides (1000 ppm +) is a narrow channel 300 feet wide and approximately 8000 feet long near the present stream. This small stream flows into the Medicine Lodge River within a half-mile.

Unusual Problems: None

Status of Project: Six groundwater samples were collected in 2014. Chloride levels in the project area have increased slightly from 2013. Current chloride values at the site range from 400 ppm in MW-6 in the northwest area of the site, to 10,000ppm in MW-13D. As the plume is followed down gradient, or to the southeast, it is suspected that the MW-12 chlorides would have jumped again compared to 2013. Comparing these values the historical data show a trend that plume is moving very slowly to the southeast. Since 2003 when the last full sampling event has taken place, MW-5, MW-7, and MW-11 have been destroyed. MW-5 was originally drilled to provide a profile of the chlorides in the main channel, whereas MW-7 was drilled to eliminate additional sources of contamination and has historically been fresh. MW-11 was drilled in order to evaluate the down gradient concentration of chlorides, but since it has been destroyed, the leading edge of the plume is left undefined. The MW-10 was found destroyed this year.

Level of Remediation Sought:


Ideal: 250 ppm Chloride

Target: 1000 ppm Chloride

Recommendation for Future Work: Continue sampling on an annual basis, sampling. As chloride levels have continued to increase down gradient, it may be necessary to design and install a remedial system for this site. Additional monitoring wells need to be drilled to define the toe of the plume. Further investigation and sampling will continue to determine if a remedial system is appropriate for this site.

Estimated Total Cost: \$150,000 if necessary to install a remediation system.

Control No.	Staff Hours/Expenditures	Fund Expenditures	
		FY 2014/15	Total
970051-00	8 Hrs. / \$217.20		\$189.94
Current Contaminate Level: 400 ppm Cl- to 10,000 ppm Cl-			
Status:			
<input type="checkbox"/> 1. Site Assessment	<input type="checkbox"/> 2. Short Term Monitoring	<input checked="" type="checkbox"/> 3. Investigation	
<input checked="" type="checkbox"/> 4. Long Term Monitoring	<input type="checkbox"/> 5. Remediation Plan	<input type="checkbox"/> 6. Installation	
<input type="checkbox"/> 7. Remediation	<input type="checkbox"/> 8. Post Rem. Monitoring	<input type="checkbox"/> 9. Resolved	

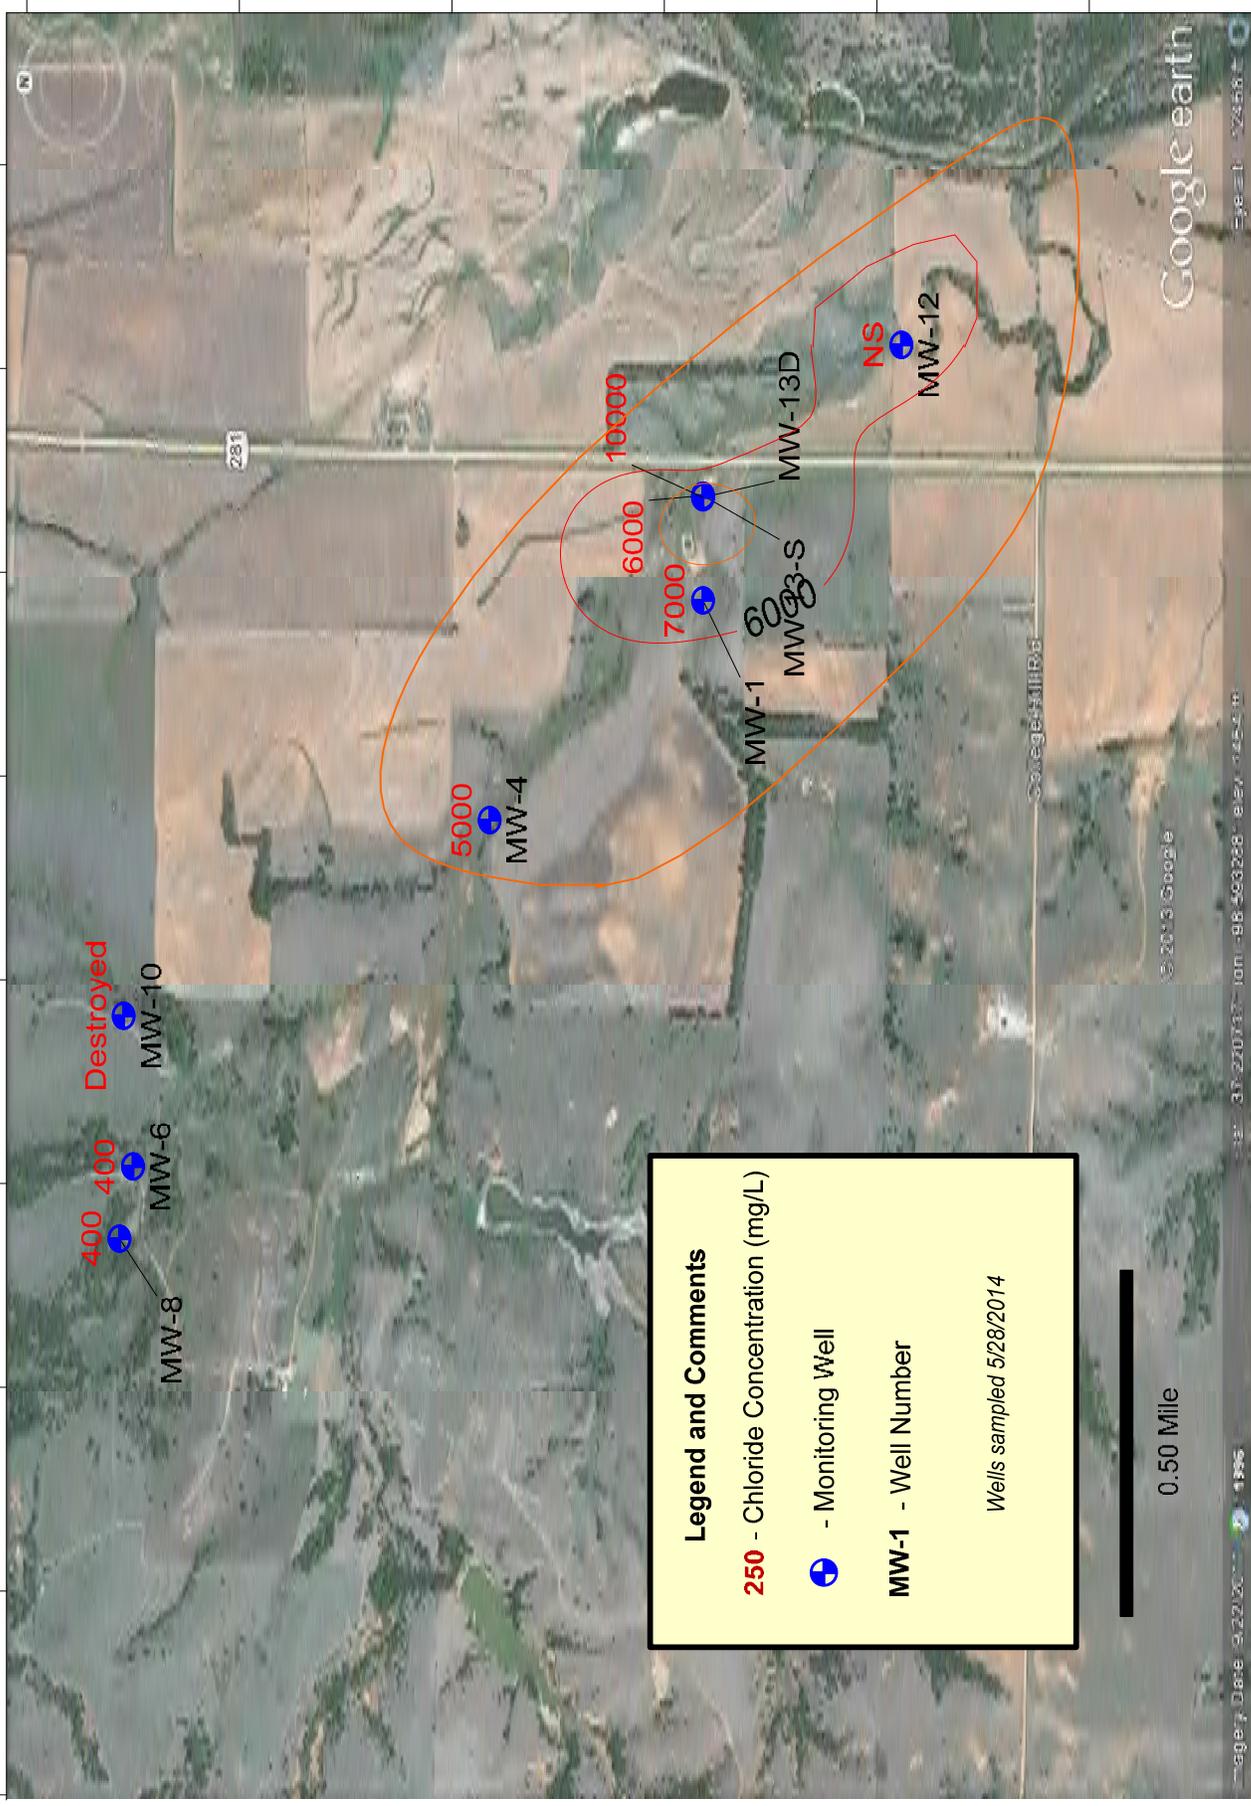

Legend and Comments


250 - Chloride Concentration (mg/L)

- Monitoring Well

MW-1 - Well Number

Wells sampled 5/28/2014

Hrencher Site
 Sections 26/35/36-T-32S-R12W
 Barber County, Kansas
2013-2014 Area Map with Chlorides
 KCC Control # 970051-00 District 1
 D. Sellers 6/13/14

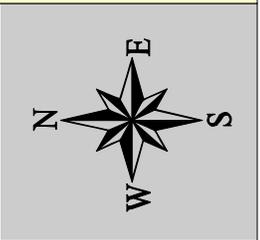

Project: Irey-Hrabe Contamination Site

Site Location: Section 1 and Section 12 of Township 9 South, Range 17 West, Rooks County.

Impact/Immediacy: The groundwater near a former homestead has been impacted by repeated releases of brine on the surface and in the subsurface. The immediacy for this site is rated as moderate.

Site Description: A subtle drainage runs through the site from south to north, and an old farmstead is situated near this draw. Up to six water wells were drilled into the Codell Sandstone and terminated in the Blue Hill Shale, and one had dug well is likely dug into alluvium overlying the competent Fort Hays Limestone. Contamination at the site can be attributed to numerous spills that have occurred over a period of 50 years, and surface pits associated with tank batteries or injection wells, which have been abused and allowed to retain produced water. Additionally, disposal wells on the site have been discovered to be contributing pollution through damaged casings, improper construction, and excessive injection pressures. At this time, it is believed that the sources of pollution have largely been removed.

Unusual Problems: None

Status of Project: The site assessment has been completed, and an investigatory phase will begin in earnest in 2015. Six water samples were collected from two ponds which had chloride concentrations of 250 ppm and 21,500 ppm, and three open water wells, which range from 2,500 ppm to 12,500 ppm and suggest a strong contaminant gradient decreasing from south to north. Because the wells are open to the surface, and a large over-land flow of brine has recently occurred, it is not known if the contamination is within the groundwater, or a result of the spill.

Level of Remediation Sought:


Ideal: 250 ppm Chloride

Target: 500 ppm Chloride

Recommendations for Future Work: While samples have been collected through existing wells, these do not meet quality control standards for groundwater sampling. A network of monitoring wells and exploratory test holes should be drilled at this site to delineate the extent of the pollution. Additionally, the existing wells should be pumped down to characterize the quality of the groundwater that is moving into them from the surrounding aquifer, and the polluted pond should be emptied.

Estimated Total Costs: \$15,000.00

Control No.	Staff Hours/Expenditures	Fund Expenditures	
		FY 2014/15	Total
970053-00	52 Hrs. / \$1,255.16		
Current Contaminate Level: Unknown			
Status:			
<input type="checkbox"/> 1. Site Assessment	<input type="checkbox"/> 2. Short Term Monitoring	<input checked="" type="checkbox"/> 3. Investigation	
<input checked="" type="checkbox"/> 4. Long Term Monitoring	<input type="checkbox"/> 5. Remediation Plan	<input type="checkbox"/> 6. Installation	
<input type="checkbox"/> 7. Remediation	<input type="checkbox"/> 8. Post Rem. Monitoring	<input type="checkbox"/> 9. Resolved	

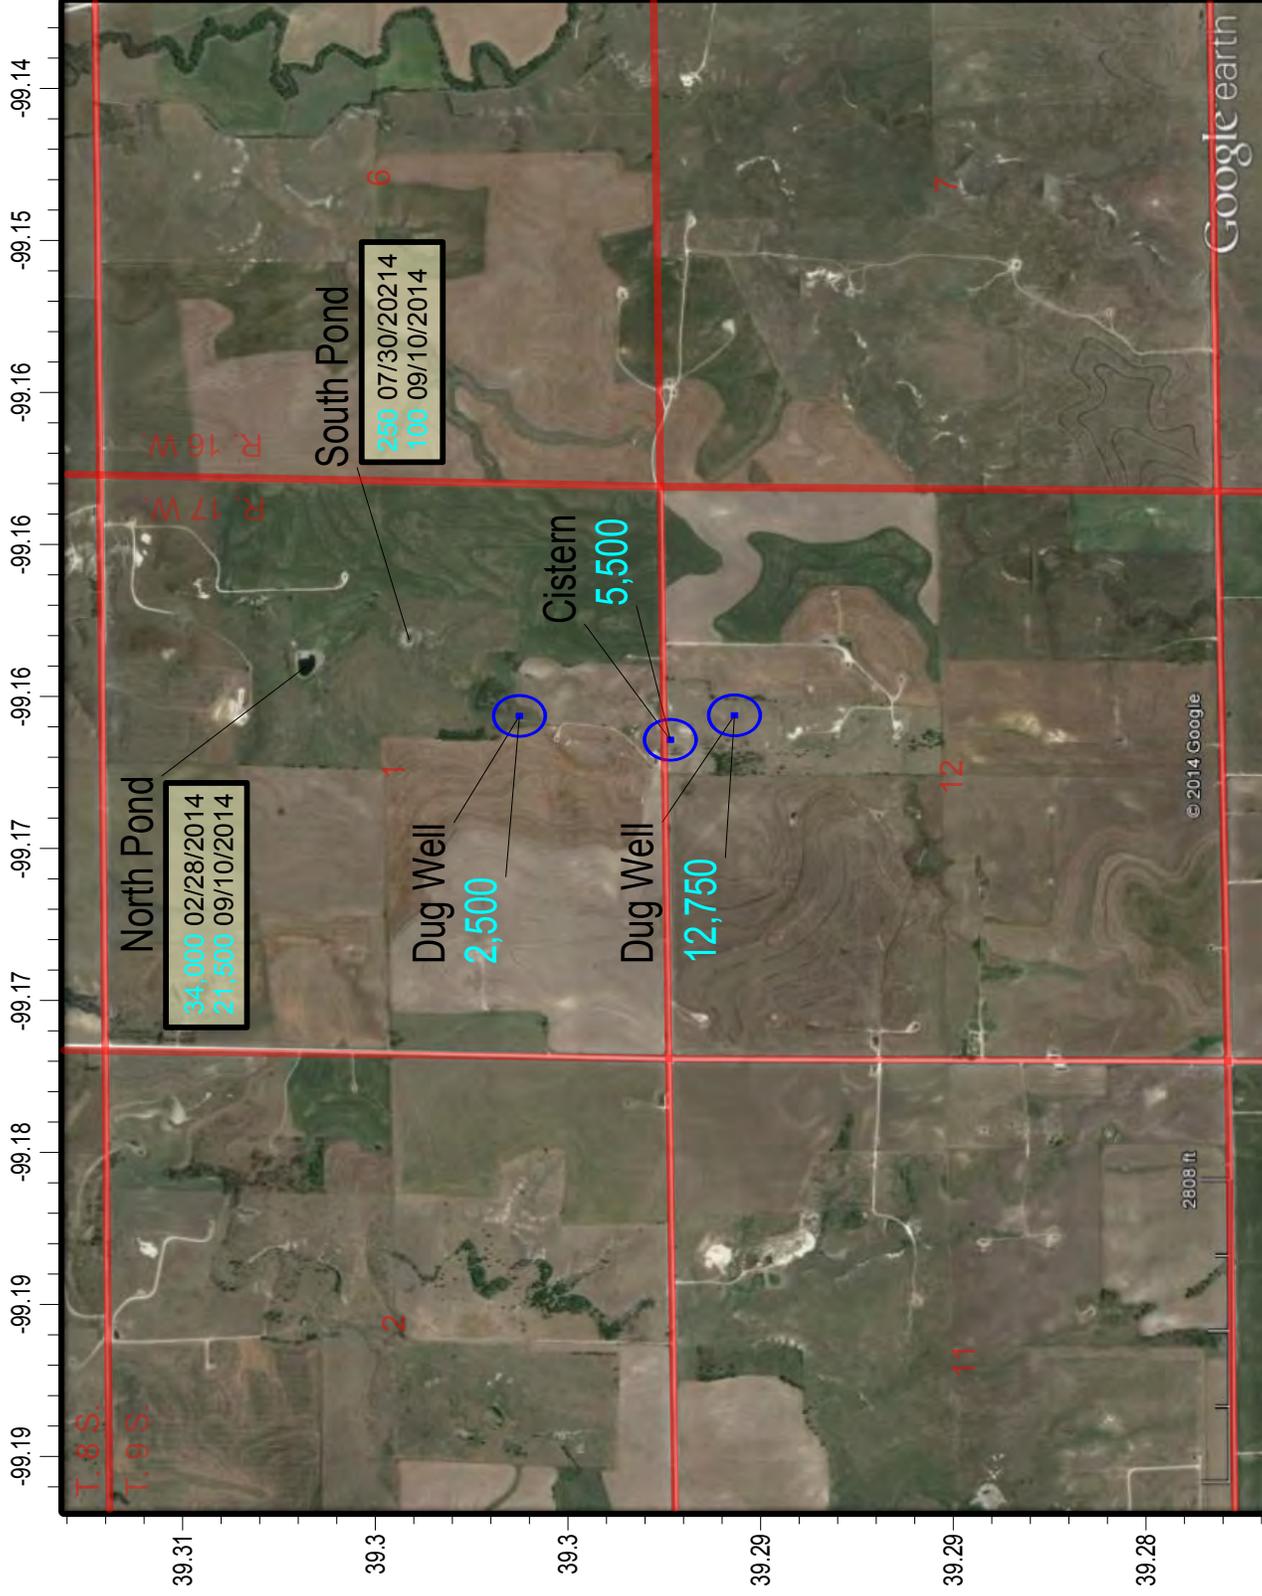

600 Chloride in ppm

Abandoned Water wells



Irey-Hrabe Groundwater Monitoring Site

Sections 1 and 12, Township 9 South, Range 17 West, Rooks County, Kansas

2014 Groundwater Chloride Levels

District #4 - Sampled on 2/28/2014, 7/30/2014, and 9/10/2014

Map Drawn on 9/12/2014 by C. Neeley



Project: *City of Jennings Contamination Site*

Site Location: NW/4 of Section 25, Township 4 South, Range 27 West, Decatur County.

Impact/Immediacy: Groundwater contaminated by poor oil field practices. Two city wells inside the city limits have experienced elevated chloride levels of varying intensity since this time. Immediacy level is rated as low to moderate.

Site Description: Poor oil field practices, spills, and brine line leaks have contributed to the problem since the 1950's. The current city water supply is from a well located west and upstream of the tank battery area, which has not been impacted by oil field pollution, and remains a viable source. The two contaminated wells in the city limits are used for purposes other than human consumption, such as watering public areas and farm use.

Unusual Problems: The high hydraulic conductivity of the soil profile allows rapid transmission of contaminants to the water table. It has been shown that the chloride concentration is capable of large increases and decreases on an annual period, and this is possibly due to responses from spills or leaks on the lease.

Status of Project: In 2008 and 2009, the chloride concentrations were 500 ppm and 600 ppm, respectively. In 2010, the level had fallen appreciably to 150 ppm, and continued to fall to 100 ppm, which was maintained through 2012. A slight increase to 200 ppm was observed during 2013, but this was still below drinking water standards for chloride concentration. However, in 2014, the concentration was found to be 850 ppm during routine annual testing. A month later, KCC staff returned to the site and pumped water to waste for 60 minutes. During this time samples were taken, and the chloride concentration stabilized at 950 ppm. During the last two years, multiple large spills and discharges have taken place at the site which may have contributed to the observed increase. Recently, a new operator has taken ownership of the lease, and appears to be more sensitive to the nature of the site.

Level of Remediation Sought:

Ideal: 250 ppm Chloride

Target: 500 ppm Chloride

Recommendations for Future Work: Monitor the site again in January 2015, during the summer of 2015, and then on an annual basis from there on. District staff will work to establish a cooperative relationship with the new operator regarding lease practices, and the implementation of safeguards to prevent pollution of the aquifer.

Estimated Total Costs: \$2000

Control No.	Staff Hours/Expenditures	Fund Expenditures	
		FY 2014/15	Total
970054-00	40 Hrs. / \$950.08		
Current Contaminate Level: 950 ppm Cl⁻			
Status:			
<input type="checkbox"/> 1. Site Assessment	<input type="checkbox"/> 2. Short Term Monitoring	<input type="checkbox"/> 3. Investigation	
<input checked="" type="checkbox"/> 4. Long Term Monitoring	<input type="checkbox"/> 5. Remediation Plan	<input type="checkbox"/> 6. Installation	
<input type="checkbox"/> 7. Remediation	<input type="checkbox"/> 8. Post Rem. Monitoring	<input type="checkbox"/> 9. Resolved	

Project: Johnson/Ramsey Contamination Site

Site Location: The project is located nine miles east and two and one half miles north of Sterling, Kansas. The site covers the SW quarter of 7-21-6W and SE quarter of 12-21-7W Rice County. The area is considered to be located within the sand hills. The site is in the drainage systems of the Cow Creek and Sand Creek. Cow Creek is a tributary of Arkansas River and flows in a southeasterly direction.

Impact/Immediacy: The contamination impacts a relatively small surface and shallow subsurface area. The immediacy level is rated as low, but there are four domestic water wells in the northwest of section 18-21-6W which could change the immediacy level if found to be impacted.

Site Description: The site is located in grazing pastureland. Sediments at the site consist mainly of unconsolidated Pleistocene, recent to Wisconsinan aged deposits of Dune Sand (KGS bulletin 206). The immediate area is topographically flat, with slopes ranging from 0-2 percent. Based on the site evaluation to date, the underlying material to a depth of approximately 40 feet was found to consist primarily of loose sand, overlying thick dense clay to approximately 35 feet near the eastern edge of the site. The clay shallows to the west and is only 20-22 feet near MW-6. The groundwater moves to the southwest and flows to the surface in section 12-21-7W. The spot where the contaminated groundwater seeps to the surface is approximately two acres in size and is historically barren of vegetation. Recent years have seen the scar shrink in total area but there is still a kill zone in section 13.

Unusual Problems: None

Status of Project: On July 7th, 2014 five groundwater monitoring wells (MW-1, MW-2, MW-3, MW-4, and MW-5) were gauged and sampled. MW-6 could not be sampled this year due to excessive poison ivy around the well area and trees that have fallen over the access road. Prior to sampling, groundwater levels were measured in each monitoring well using an electronic water level indicator. A submersible Proactive® Water-Spout water pump was used to purge a minimum of three well volumes of groundwater from each well before sampling. Purge water was tested for conductivity prior to being discharged onto the ground surface at the Site or contained in a 250 gallon poly-tank if conductivity was high before disposed of into a deep injection well.

Groundwater samples from each monitoring well were collected in one 250 (ml) polyurethane container for analysis at the KCC District #2 Laboratory. Each sample for this monitoring event was analyzed for the presence of Chloride by United States Environmental Protection Agency (USEPA) Method 8225 (Titrimetric, Silver Nitrate). Chlorides ranged from 20 mg/L in the eastern wells to 2200 mg/L in MW-3 and MW-4 in the middle of the site.


Level of Remediation Sought:

Ideal: 250 mg/l Chloride
Target: 750 mg/l Chloride

Recommendations for Future Work: KCC district staff recommends continued sampling for the next few years as chlorides are as high as 1500 mg/L in section 7, and in past years 4100 mg/L in section 12. These levels are lower than past sampling events but still very far away from the target levels originally set. Natural attenuation has been slow, and the only feasible remedial system for the shallow aquifer would entail a shallow interceptor trench. There is no brine disposal facility near-by, so water would have to be trucked from the site. Long-term monitoring is still the recommended remedial program for this site. There is a lack of delineation on the western half of the site, and new monitoring wells would be helpful in plotting the total size of the brine plume. Due to lower priority status KCC does not recommend installation of new wells at the Johnson Site unless higher brine levels are found in the monitoring wells in future events.

Estimated Total Costs: Total costs next year for annual water sampling, report writing and research: \$750

Control No.	Staff Hours/Expenditures	Fund Expenditures	
		FY 2014/15	Total
970055-00	22 Hrs. / \$585.26		\$416.28
Current Contaminate Level: 2200 @ MW-3 & MW-4 and 20 ppm @ MW-1			
Status:			
<input type="checkbox"/> 1. Site Assessment	<input type="checkbox"/> 2. Short Term Monitoring	<input type="checkbox"/> 3. Investigation	
<input checked="" type="checkbox"/> 4. Long Term Monitoring	<input type="checkbox"/> 5. Remediation Plan	<input type="checkbox"/> 6. Installation	
<input type="checkbox"/> 7. Remediation	<input type="checkbox"/> 8. Post Rem. Monitoring	<input type="checkbox"/> 9. Resolved	

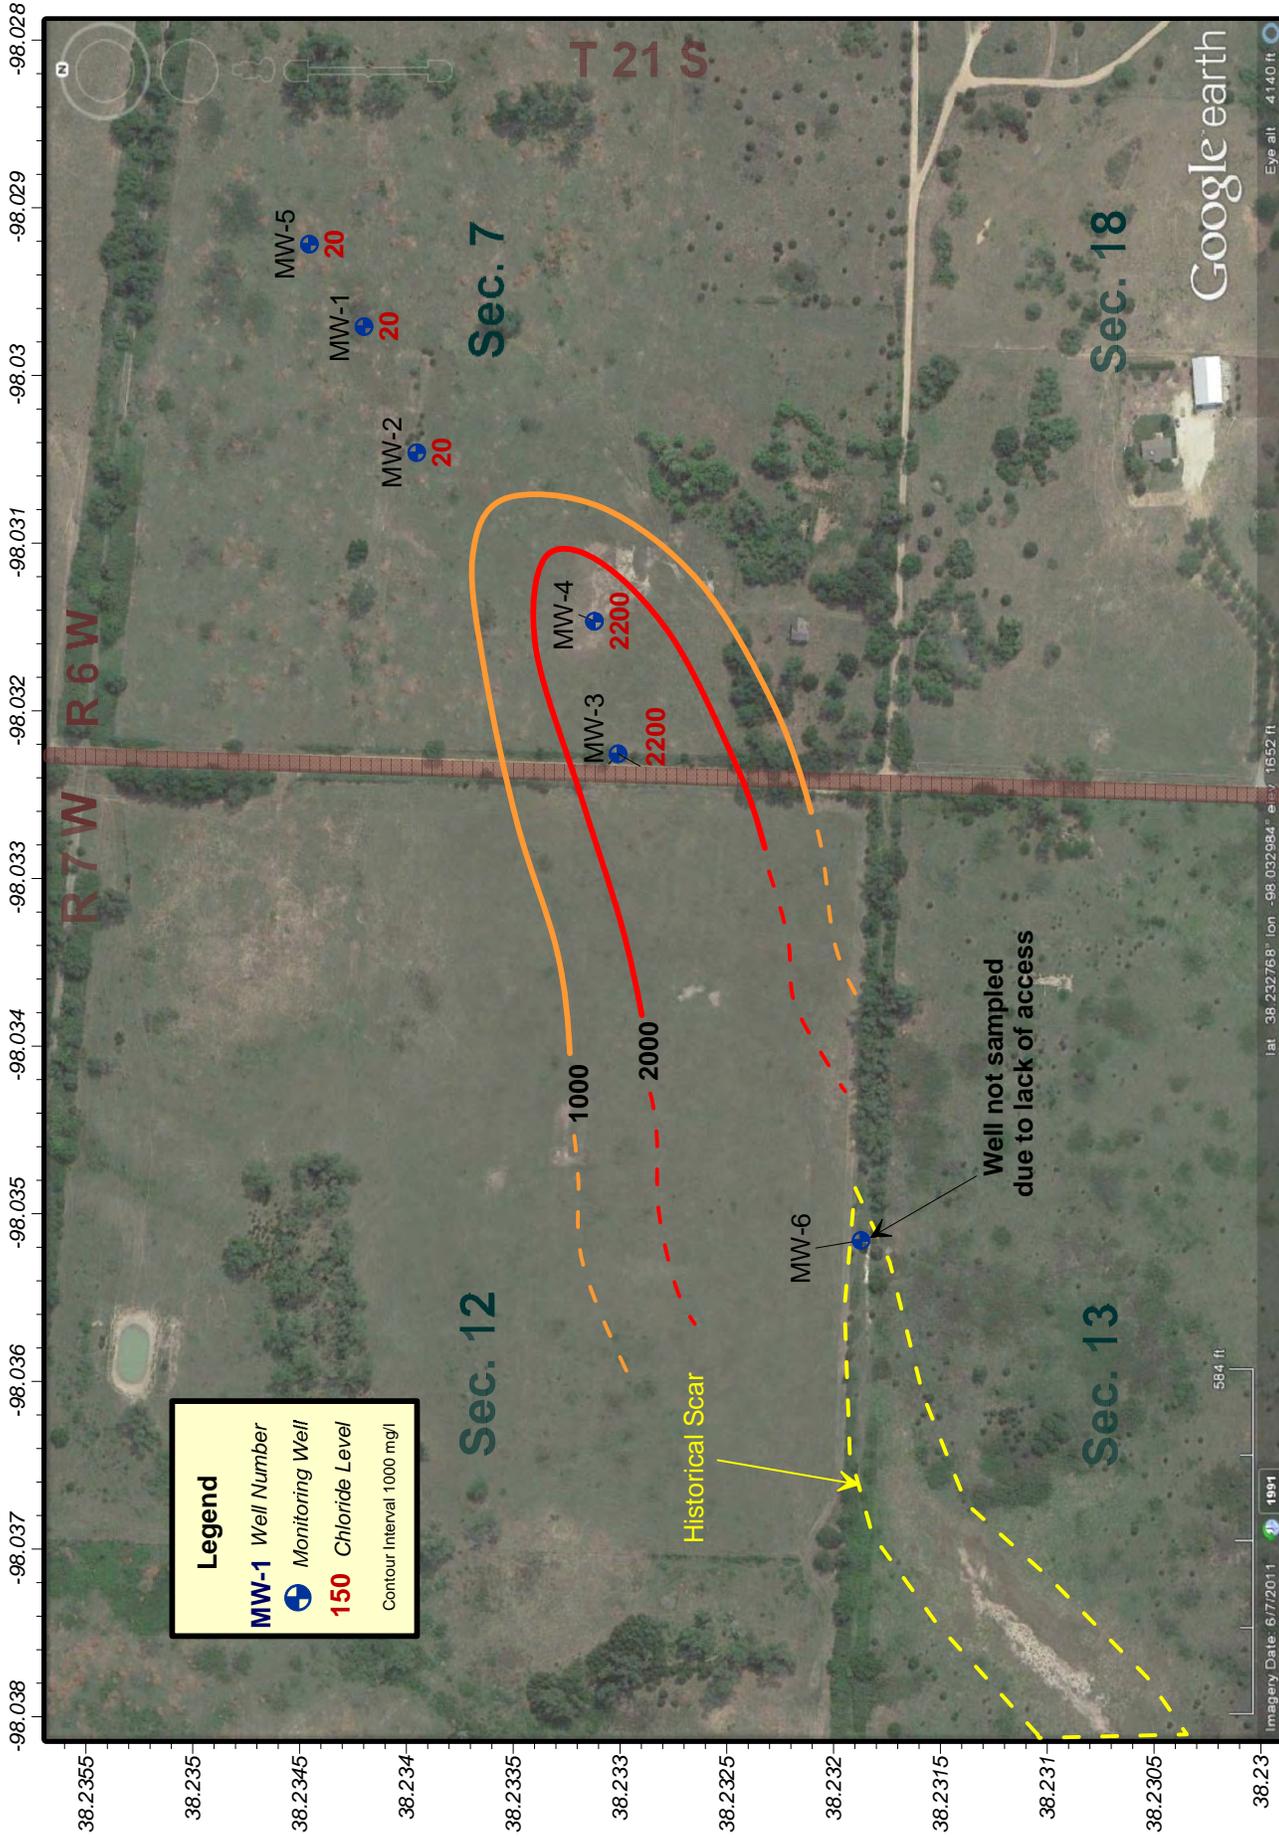

Johnson/Ramsey Monitoring Site - KCC Control # 970055-00
 Section 7 of T 21 S & R 6 W, Section 12 of T 21 S & R 7 W and Section 13 of T 21 S & R 7 W Rice County, Kansas
2014 Groundwater Chloride Levels
 District #2 - Sampled 7/8/2014 - Map Drawn 10/9/14 by D.Bollenback



Project: Knackstedt Site

Site Location: The site is located eight miles west and four miles north of Inman. The legal location is N/2 N/2 NW NW of Section 30, Township 20 South, and Range 5 West, in McPherson County.

Impact/Immediacy: Potential exists for impacts on both rural domestic and stock water resources. Public safety issues have been mitigated with the re-routing of the local roadway affected by this site, the site is still ranked as moderate immediacy level due to the unknown extent of the dissolution.

Site Description: The site consists of an unplugged saltwater disposal well whose operation led to the development of an air filled underground void at an approximate depth of 430 feet. The size of the cavity has not been determined as of this date. The site is located immediately southeast of the intersection of Plum Street and Saxman Road. In 1995 the KCC agreed to provide funding for additional seismic efforts at this site by the Kansas Geological Survey. Land use is agricultural with oil and gas activities in the area.

Unusual Problems: The air filled nature of the cavity makes the design of an acceptable plugging project more difficult. The air filled nature of the cavity also restricts the nature and kind of investigatory methods applicable to this site.

Status of the Project: The cavity in the salt section of the Wellington Formation has been stable with only slight indication of any downward surface movement. The site was is under periodic monitoring of surface elevations with respect to possible surface movement. Survey was made of the control points in July of 2013. The results of that survey indicated that the control points and/or benchmark have been compromised over the last two years and are in need of replacement by a licenced surveyor. District Staff is currently in the process of writing up a scope of work to address this issue and plans to have a new system for surveying the depression.

Level of Remediation Sought:


Ideal: Stabilize cavity and plug well bore in accordance with KCC rules and regulations.

Target: Study results indicate a reduced need for further or complete cavity stabilization beyond the original well bore and an acceptable plugging procedure can be developed which adequately addresses both fresh water resources and public safety issues.


Recommendations for Future Work: KCC will be in discussions with Kansas Geological Survey regarding the future surveying and other investigative techniques that could be used to delineate the cavern. Depending on the findings of the continued investigation it may become paramount that the KCC reenter and attempt to plug or at the minimum stabilize the cavern to prevent catastrophic collapse.

Estimated Total Costs: \$2500 to 5000 to have the benchmark/points resurveyed by a licensed surveyor. It will be very costly to attempt to plug this void at this time.

Control No.	Staff Hours/Expenditures	Fund Expenditures	
		FY 2014/15	Total
970060-00	12 Hrs. / \$322.36		\$153.39
Current Contaminate Level: Unstable well cavity			
Status:			
<input type="checkbox"/> 1. Site Assessment	<input type="checkbox"/> 2. Short Term Monitoring	<input type="checkbox"/> 3. Investigation	
<input checked="" type="checkbox"/> 4. Long Term Monitoring	<input type="checkbox"/> 5. Remediation Plan	<input type="checkbox"/> 6. Installation	
<input type="checkbox"/> 7. Remediation	<input type="checkbox"/> 8. Post Rem. Monitoring	<input type="checkbox"/> 9. Resolved	

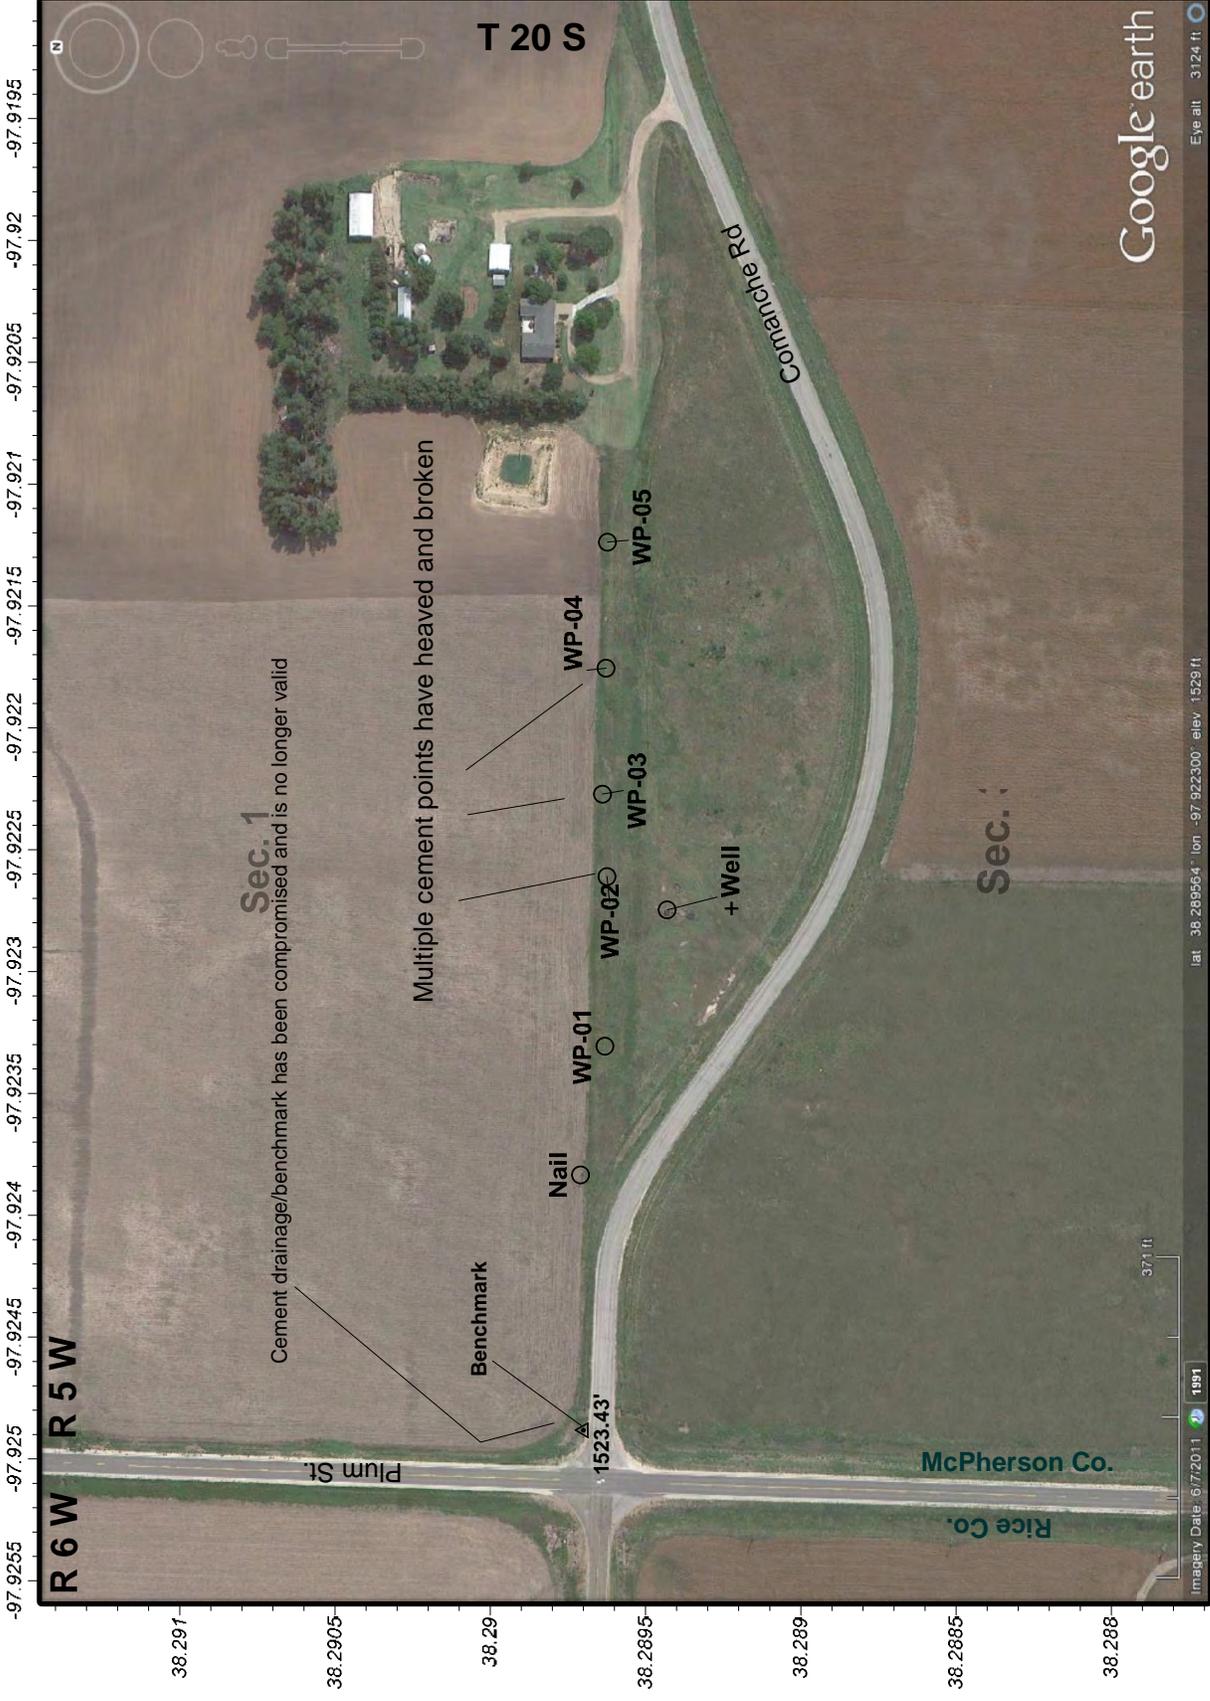

Knackstedt Depression Site
 NW - Sec. 30 - T 20 S & R 5 W, McPherson County, Kansas
2014-15 Site Map
 SITE MAP
 KCC Project Code #970060-00 - District #2 - D. Bollenback - 11/21/2014

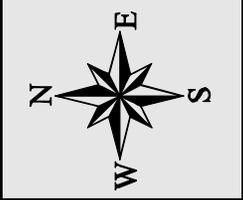

Project: Korf Contamination Site

Site Location: Legal location is the SE/4 of the SE/4 of the NE/4, Section 7, Township 23 South, Range 22 West.

Impact/Immediacy: There is a very slight chance of the plume impacting the area to the northeast. The site has a low rating.

Site Description: There are currently six monitoring wells on the site which are sampled on an annual basis. Land use is agricultural with oil activities to the south. The site is located at the bottom of a small valley carved by an intermittent stream. The aquifer is a mixture of weathered shale, clay, and some clayey sand sitting on top of the Cretaceous Dakota shale.

Unusual Problems: The aquifer is composed of weathered shale, shale, with some clayey sand. Due to this, water does not flow quickly through the area. This makes normal methods of treating the aquifer difficult to accomplish.

Status of Project: The project is currently in a monitoring phase. The saltwater plume is moving very slowly to the north northeast along the draw. The samples from the monitoring wells, while erratic at times, show a slow decrease in chlorides. Three surface samples were taken from puddles inside the draw and they results ranged from 9.3-55 ppm chlorides. The soil has grass and other plants growing in it.

Level of Remedation Sought:


Ideal: 250 ppm

Target: 1000 ppm

Recommendations for Future Work: Continue monitoring work until the aquifer reaches the target level.

Estimated Total Costs: Costs covered by PRP.

Control No.	Staff Hours/Expenditures	Fund Expenditures	
		FY 2014/15	Total
20140017-001	3.5 Hrs. / \$98.90		
Current Contaminate Level: 22 ppm Cl- to 2360 ppm Cl-			
Status:			
<input type="checkbox"/> 1. Site Assessment	<input type="checkbox"/> 2. Short Term Monitoring	<input type="checkbox"/> 3. Investigation	
<input checked="" type="checkbox"/> 4. Long Term Monitoring	<input checked="" type="checkbox"/> 5. Remediation Plan	<input type="checkbox"/> 6. Installation	
<input type="checkbox"/> 7. Remediation	<input type="checkbox"/> 8. Post Rem. Monitoring	<input type="checkbox"/> 9. Resolved	

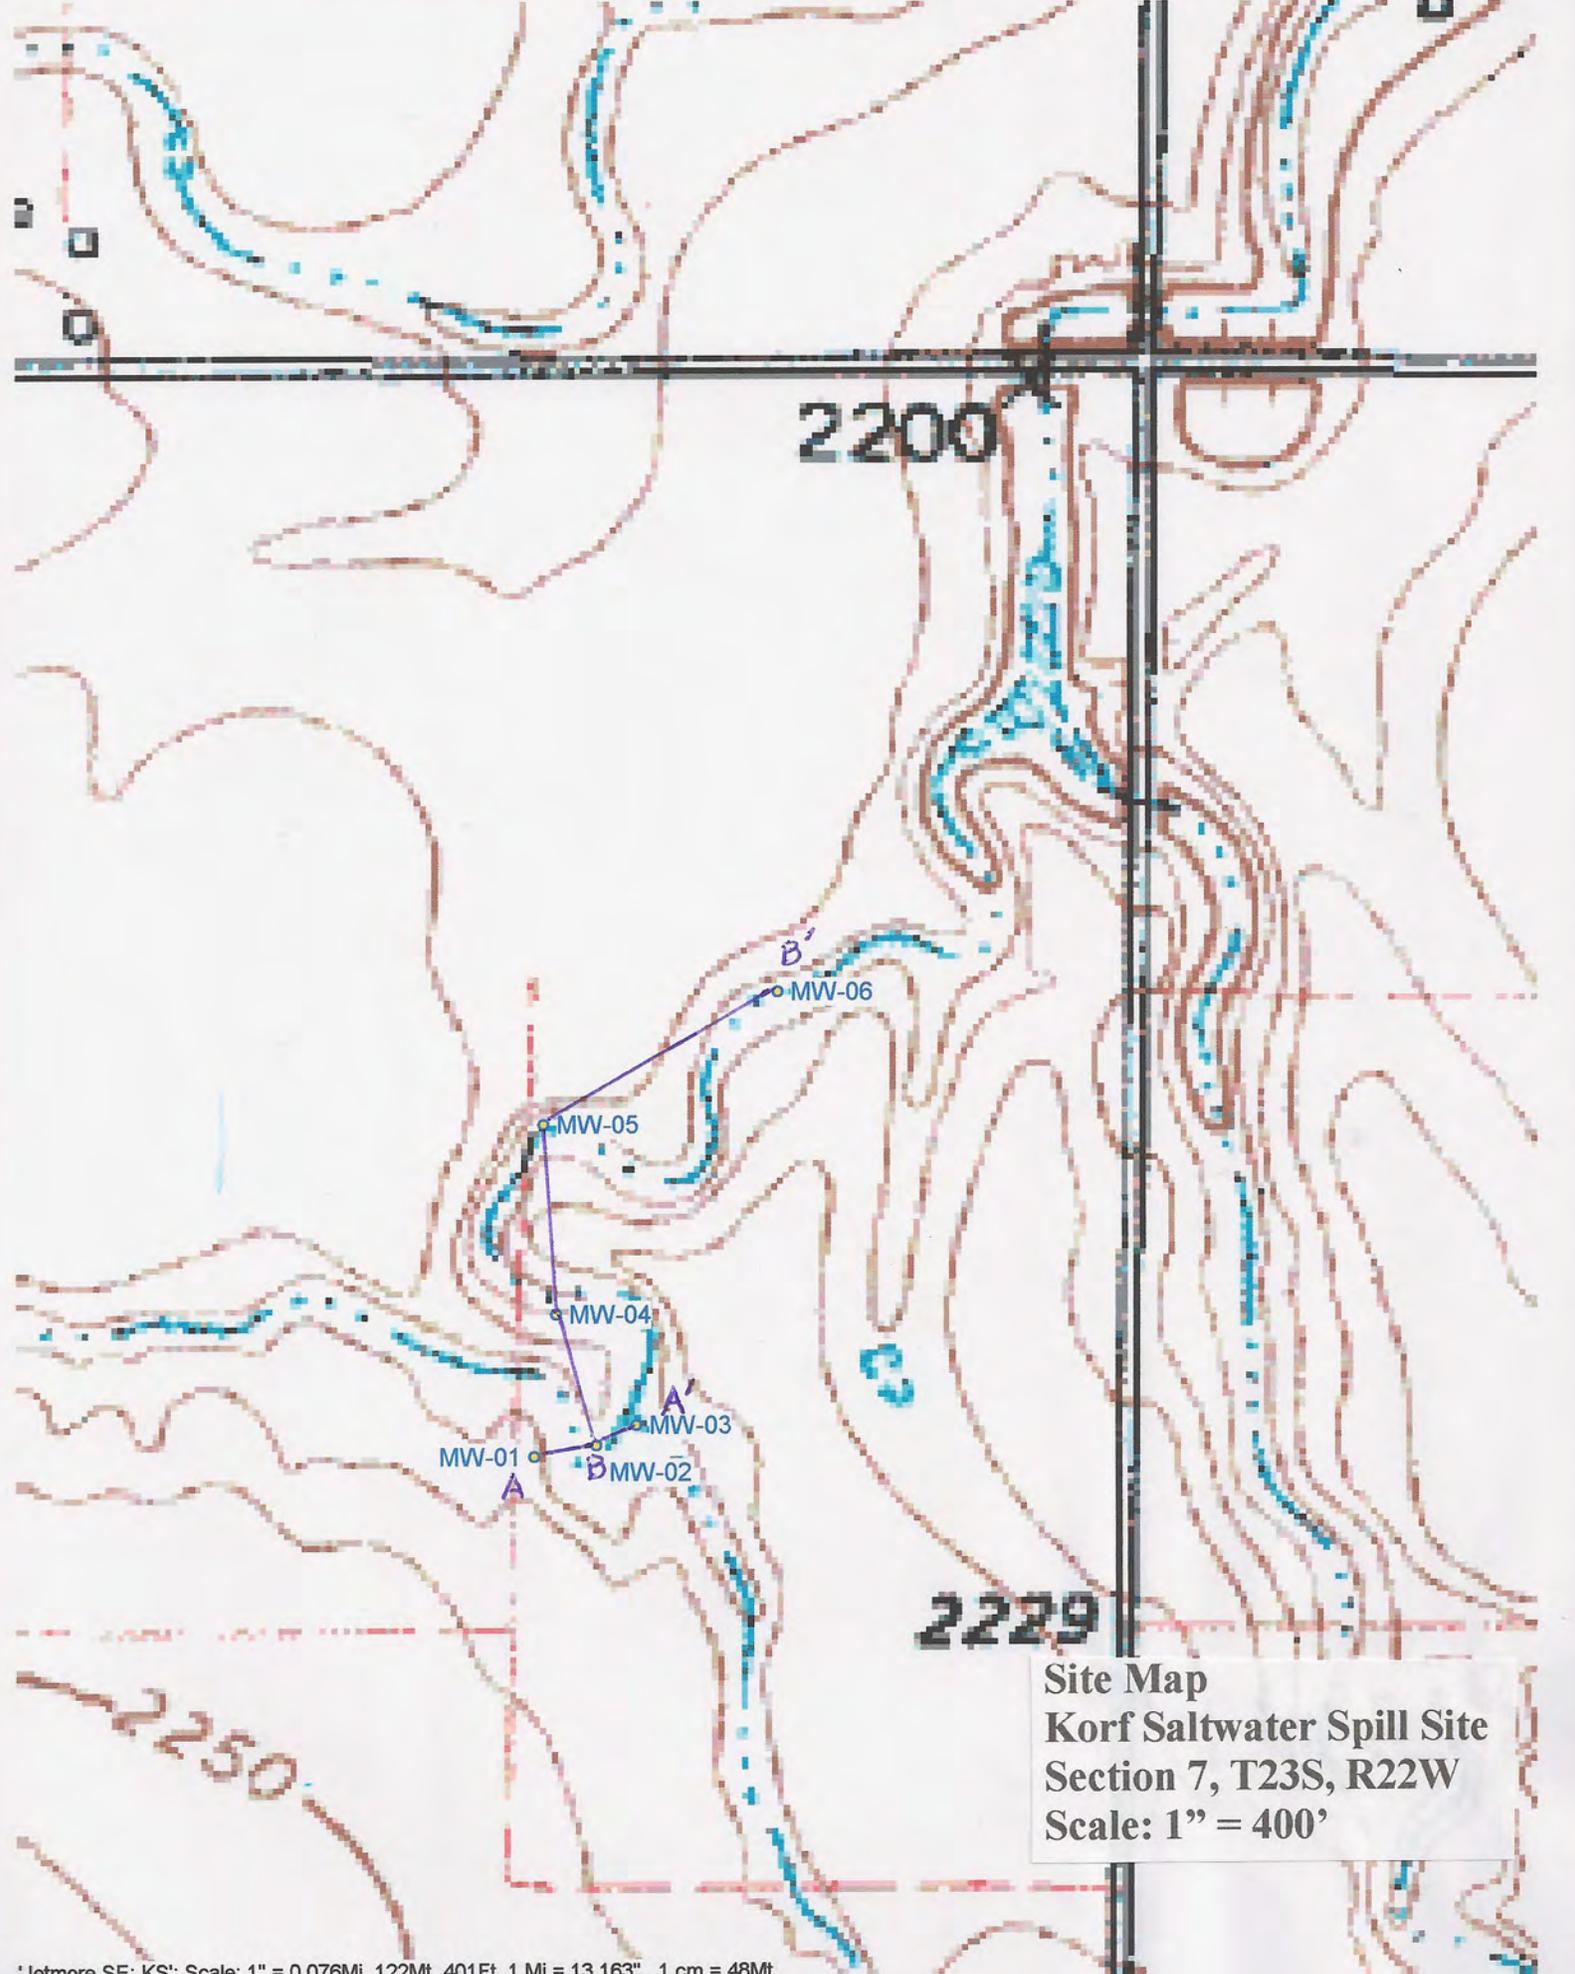

2200

2229

2250

Site Map
Korf Saltwater Spill Site
Section 7, T23S, R22W
Scale: 1" = 400'

*Jetmore SE; KS; Scale: 1" = 0.076Mi 122Mt 401Ft, 1 Mi = 13.163" , 1 cm = 48Mt

TABLE 1

Pintail Petroleum, LTD

Korf Lease

Monitoring Wells

Historical Chloride Concentrations (ppm)

NE/4 Section 7, T23S, R22W

Hodgeman Co., Kansas

SAMPLE ID	MW-01	MW-02	MW-03	MW-04	MW-05	MW-06
	Cl (ppm)					
Sample Date						
25-Sep-07	70	1800	DRY	3300	DRY	43
12-Nov-07	55	1100	DRY	4500	DRY	25
18-Feb-08	1700	490	DRY	2700	DRY	23
23-May-08	520	1000	14	1900	47	23
04-Aug-08	1700	1300	DRY	1800	45	26
14-Nov-08	1200	1500	DRY	750	53	27
10-Feb-09	2300	1400	DRY	1300	42	29
04-Aug-09	3400	1500	DRY	1600	400	51
23-Feb-10	3500	1000	DRY	1200	220	53
05-Aug-10	5000	1100	44	1700	180	31
21-Mar-11	3700	760	DRY	2700	150	24
08-Aug-11	2600	830	DRY	2700	110	23
21-Jun-12	1800	1700	DRY	3000	280	24
21-May-13	1800	NS	DRY	1900	160	24
28-Oct-14	960	600	DRY	2360	229	22

Table 3
Pintail Petroleum, LTD
Korf Lease
Historical Chloride Concentrations (ppm)
E/2 Section 7, T23S, R22W
Hodgeman Co., Kansas

SAMPLE ID	SW-1	SW-2	SW-3
SAMPLE DEPTH			
Sample Date			
27-Jun-07	7500	8700	1200
08-Aug-07	DRY	2000	DRY
18-Feb-08	DRY	DRY	DRY
23-May-08	DRY	55	27
04-Aug-08	DRY	DRY	DRY
14-Nov-08	Dry	96	30
10-Feb-09	DRY	DRY	DRY
04-Aug-09	DRY	DRY	DRY
23-Feb-10	DRY	DRY	DRY
05-Aug-10	DRY	DRY	DRY
21-Mar-11	DRY	DRY	DRY
08-Aug-11	DRY	DRY	200
21-Jun-12	DRY	DRY	DRY
21-May-13	DRY	DRY	DRY
28-Oct-14	53	19.8	9.3

NS - Not sampled

Project: Leesburg Sink Hole Site

Site Location: The site is located in Section 12, Township 25 South, Range 13 West, Stafford County.

Impact / Immediacy: Potential exists for impacts on stock and irrigation resources. Subsidence around the Leesburg #302 and Leesburg #303 may develop into a sinkhole. Worst-case scenario would be a catastrophic collapse taking several acres of farm ground. Probable action is a gentle downward movement of the area until stable. The site has a moderate to high rating.

Site Description: The site consists of a plugged saltwater disposal well whose operation led to the probable development of a solution cavity. The site is located in a rural setting approximately 990' FEL and 2310' FSL of section 12. Land use is agricultural with oil activities in the area. The subsidence at the site now covers an area of approximately 350'x400' in size.

Unusual Problems: A solution cavity is thought to exist under the existing location.

Status of the Project: Elevation shot at 9/27/2013. There has been no change in elevation since the last survey in 2012. No survey data was obtained in 2014. Updating survey data is planned for the spring of 2015.

Recommendations for Future Work: The PRP has been surveying the site irregularly. It is recommended the site be surveyed at least biannually to establish a subsidence rate. The ground level at the stake on the east side should be surveyed in addition to the Leesburg 302 if it is accessible (low/no water). Additional points on the north and south edges of the sink, as well as a point in the center of the sink should be added in order to more thoroughly describe the movement.

Level of Remediation Sought:

Ideal: Stabilize cavity.

Target: Safely monitor site.

Estimated Total Costs: RP -\$62,000, plugging costs, seismic and installation of monitor wells.

Control No.	Staff Hours/Expenditures	Fund Expenditures	
		FY 2014/15	Total
20040003-001	3.5 Hrs. / \$98.90		\$6,266
Current Contaminate Level: Unknown			
Status:			
<input type="checkbox"/> 1. Site Assessment	<input type="checkbox"/> 2. Short Term Monitoring	<input checked="" type="checkbox"/> 3. Investigation	
<input checked="" type="checkbox"/> 4. Long Term Monitoring	<input type="checkbox"/> 5. Remediation Plan	<input type="checkbox"/> 6. Installation	
<input type="checkbox"/> 7. Remediation	<input type="checkbox"/> 8. Post Rem. Monitoring	<input type="checkbox"/> 9. Resolved	

Legend and Comments


250 - Height (ft)

+ - Survey Point

MW-1 - Survey Point Name

Surveyed 9/30/2013

240 feet

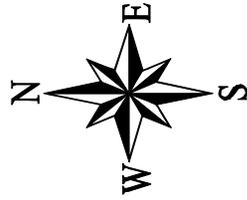

Imagery Date: 10/12/2011 lat 37.889009° lon -98.696377° elev 1922 ft eye alt 2738 ft

Leesburg Sinkhole
Section 12-T25S-R13W
Stafford County, Kansas
Change in Elevation Map-Shot 9/27/2013
KCC Control # 2004003-001 District 1
D. Sellers 10/01/2013

Project: Little River Site

Site Location: The site is located 4 miles north and one east of the southwest edge of the city of Little River. The area of contamination is in the SE/4 of section 29 and NE/4 of section 32 T 18S R6W, Rice County.

Impact/ Immediacy: The impact is to the ground water supply for the city of Little River from unknown oil field source. The immediacy level is rated as high because of its potential impact to the existing public water supply wells.

Site Description: The Little River water well field is located in part of the Odessa Oil Field. The ground water table in this area is at a depth of thirty feet in a sandstone aquifer with an aquitard of blue shale at a depth of fifty to sixty feet. The sandstone has its highest increase in conductivity (chlorides) at a depth of 47 to 50 feet as indicated by a conductivity test in MW# 1. The source for the contamination may be from old core soundings, spills, pits or leaking wells.

Unusual Problems: Unknown source for the contamination.

Status of Project: A chloride plume is located in the SE corner of Section 29 where the highest chloride values are found in PWS-7 (3000mg/L). This plume seems to be slow moving and consistently located around PWS-7 as the center as chloride levels in has risen from 2300 mg/L to 3,000 mg/L from last year's sampling event. MW #1 has decreased 800 ppm from last year and is at 700 mg/L. PWS #10 in the NE/4 of Section 32 has been brought back online for use by the city and chlorides in 2014 were 170mg/L.

A review of historical chloride data from 1999 to present show water quality for this site has slightly improved to no change over the past six years. Five operating public water supply wells are well within target limits for chlorides ranging from 70 to 130 mg/l. PWS#13 to the west of the other wells is now online and utilized as a public water supply well for the town of Little River. It had a chloride level of 600 mg/l in 2014. This well is mixed with the other wells so the elevated chlorides are diluted before public consumption. If this well continues to increase in the future it maybe unusable by the city of Little River. MW-1 decreased substantially in 2014 while MW-2 remained at 40 ppm.

Level of remediation Sought:


Ideal: 60 mg/l

Target: 300 mg/l

Recommendation for Future Work: If the water quality at any of the existing PWS wells declines due to saltwater contamination staff would recommend that up to 4 monitoring wells/test holes be installed to help delineate the salt-water contamination. PMW#13 is still at 600 ppm but MW-1 has decreased 50% over the last year so delineation to the west is unnecessary at this time.

Estimated Total Costs: Time for staff to mobilize to site and sample the wells, perform the laboratory work, data entry, mapping and report writing. If conditions warrant additional recourses tracking the western brine edge, KCC could put together an investigative scope for approximately \$10,000 to \$18,000 counting field work and well installs.

Control No.	Staff Hours/Expenditures	Fund Expenditures	
		FY 2014/15	Total
20000057-001	38 Hrs. / \$974.42		\$3,112.20
Current Contaminate Level: 700 mg/l Cl⁻ MW #1 to 40 mg/l MW #2 3,000 mg/l Cl⁻ PWS-7			
Status:			
<input type="checkbox"/> 1. Site Assessment	<input type="checkbox"/> 2. Short Term Monitoring	<input type="checkbox"/> 3. Investigation	
<input checked="" type="checkbox"/> 4. Long Term Monitoring	<input type="checkbox"/> 5. Remediation Plan	<input type="checkbox"/> 6. Installation	
<input type="checkbox"/> 7. Remediation	<input type="checkbox"/> 8. Post Rem. Monitoring	<input type="checkbox"/> 9. Resolved	

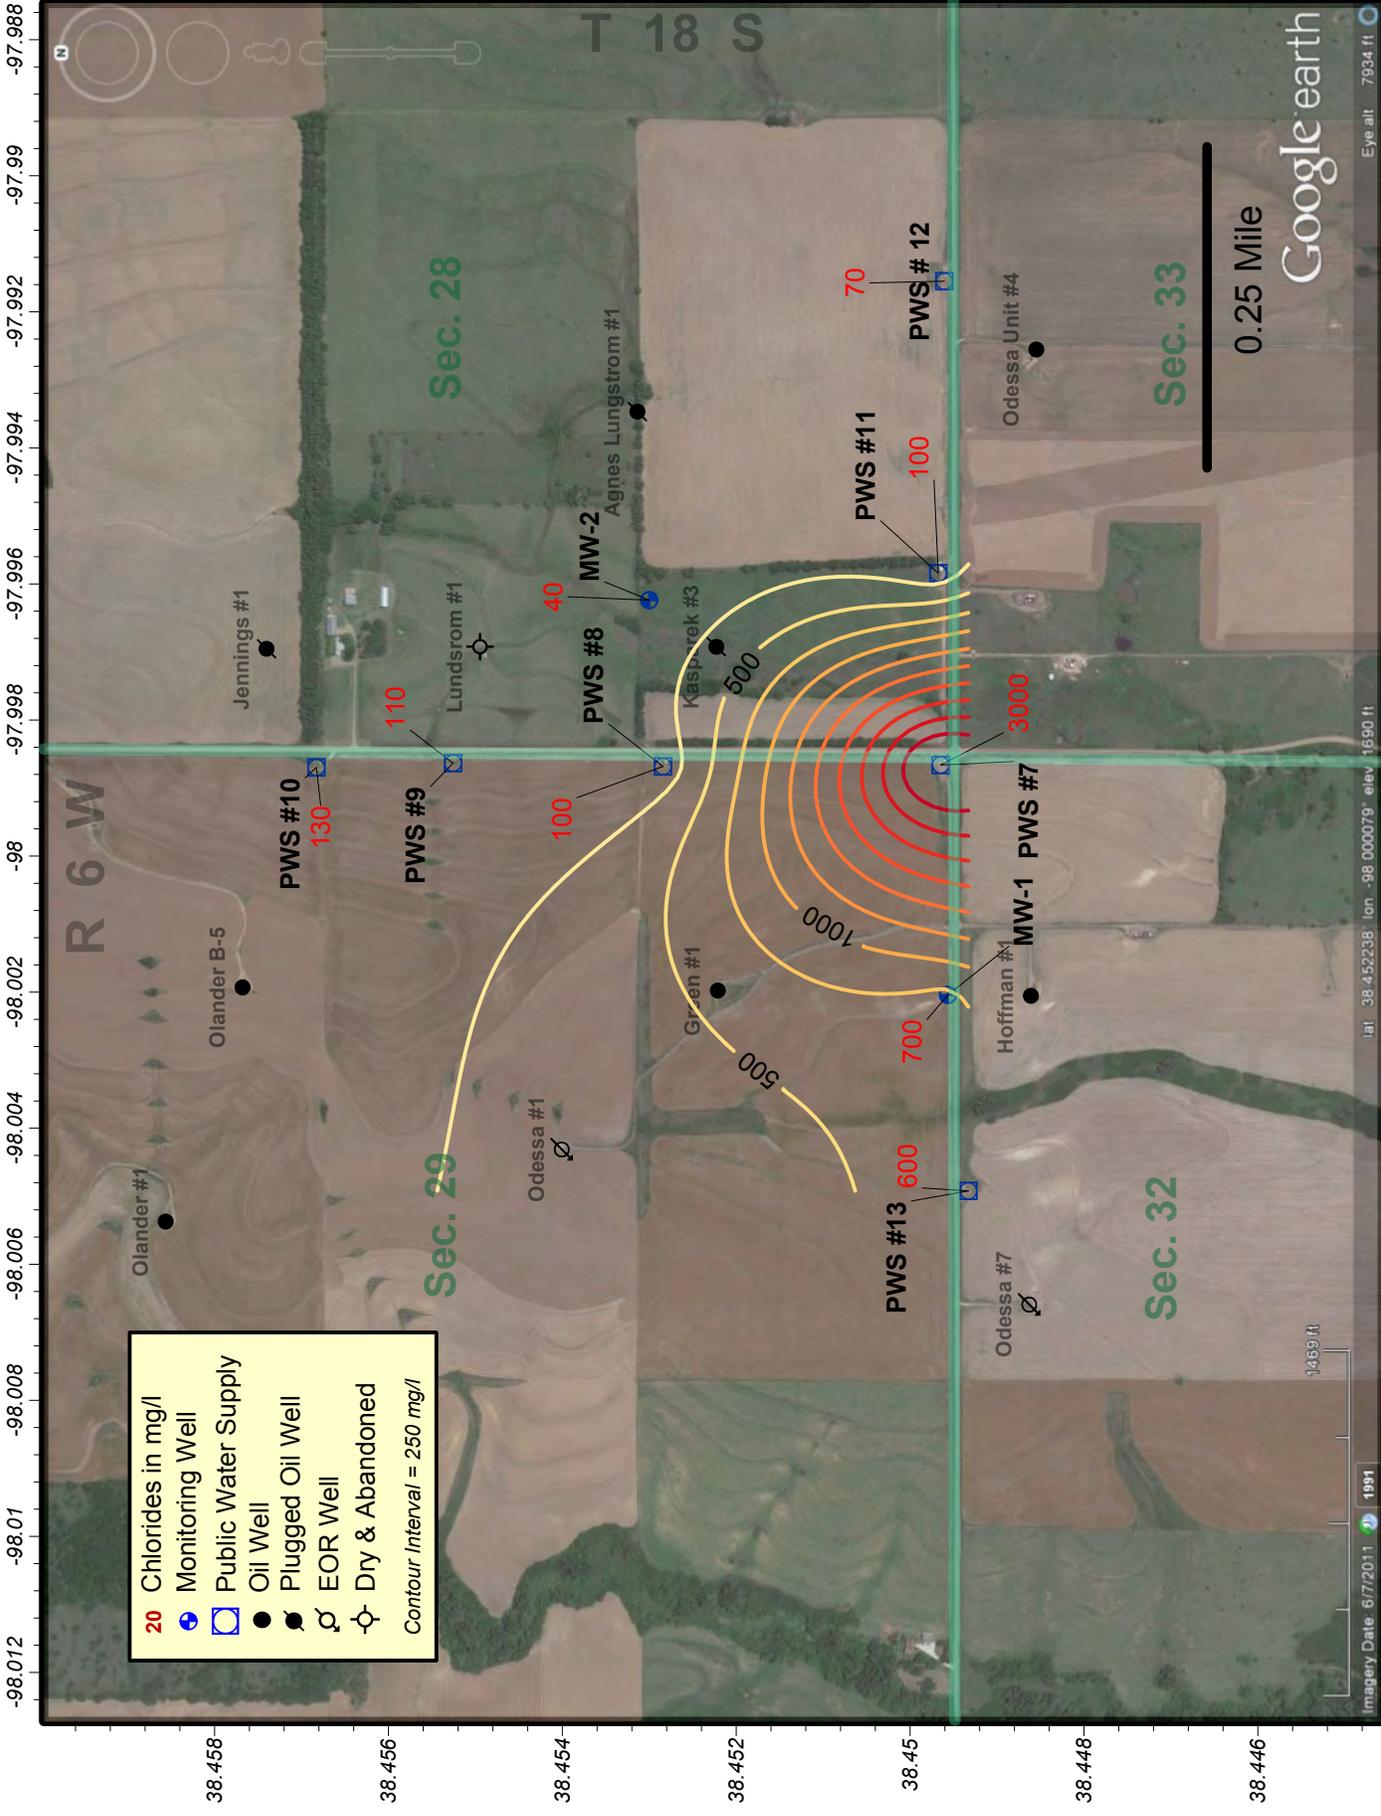

20	Chlorides in mg/l
Blue Square	Monitoring Well
Blue Square	Public Water Supply
Black Dot	Oil Well
Black Dot with Dot	Plugged Oil Well
Circle with Dot	EOR Well
Circle with Cross	Dry & Abandoned
Contour Interval = 250 mg/l	



Little River Groundwater Monitoring Site
 Section 29 of Township 18 South & Range 6 West, Rice County, Kansas
 2014 Groundwater Chloride Levels
 District #2 - Sampled on 9/10/14 - Map Drawn on 9/23/14 by B. Milner

0.25 Mile

Google earth

lat: 38.452238° lon: -98.000079° elev: 1690 ft

Eye alt: 7934 ft

Project: Macksville Contamination Site

Site Location: Legal location of the site is in the S/2 SW Section 30, Township 23 South, Range 15 West, in Pawnee County.

Impact/Immediacy: An irrigation well is located in the NE/4 of this section which is in direct line with the natural flow of the groundwater. A new irrigation well was drilled and is being used to irrigate corn. Sampling shows that while the water in the well has been impacted, the water is below drinking water standards. The sinkhole itself seems to be growing to the north. Immediacy level is rated at Moderate-High due to the growing sinkhole.

Site Description: A sinkhole developed around an abandoned salt-water disposal well on July 21, 1988. Brine from the old well and possibly other sources entered the fresh water aquifer. The aquifer consists of sand and gravel overlying the Wellington Formation of Permian age. The salt-water plume is being monitored by thirty-seven wells. The plume is moving to the northeast from the sinkhole area towards an irrigation well.

Unusual Problems: Ground usage is lost over several acres due to the development of the sink. The depression is still increasing in size.

Status of Project: Thirty four monitoring wells and one surface water sample were taken in 2014. Chlorides were either stable or rising compared to 2012. Chlorides at this site are below fresh water standards in all except two wells. First is the MW-16d, where the chlorides are 775ppm. The second is the MW-15d, where the chlorides are 500 ppm, right at the top of the freshwater limit. Overall, the chlorides at this site have been steadily declining due to natural attenuation, but will likely remain elevated over background chlorides due to the higher chlorides that still reside in the pond formed by the sink, which are at 1,410ppm and have risen since last year. There was a sudden rise of chlorides in the pond last year. This has led to a monthly sampling program. While it was initially believed that the rise in chlorides this year may be due to the drought conditions that have been occurring in Central and Western Kansas, chlorides seem to be rising up from either the red beds below the aquifer or a pulse of saltwater somehow made it way up through the old wellbore. The site was not surveyed this year due to the results that were acquired last year. The numbers showed the sinkhole rising a half a foot on average. We went back and found surveys from previous years, and we now believe that our benchmark is sinking faster than the sinkhole. The sinkhole has begun moving to the north.

Level of Remediation Sought:


Ideal: 250 ppm Chloride

Target: 300 ppm Chloride

Recommendations for Future Work: Because we believe our benchmark is now sinking, funds will be needed so a new benchmark can be established so accurate surveying can recommence. Funds will also be sought to establish new survey points to track the northern progression of the sinkhole. Funds are sought to rebuild the cellar of the disposal well which has deteriorated. Chlorides, overall, were stable this year with a few key exceptions. If chlorides either stabilize or drop next year, plugging of the monitoring wells should begin. Since only one well currently remains above the fresh water standard it is recommended to begin plugging a majority of the wells at the location, starting with well in the NE/4, and working back towards the sinkhole, potentially leaving MW- 16d available for sampling until the chlorides have fallen below fresh water standards. The site should also continue to be surveyed on an annual basis to track the current rate of subsidence.

Estimated Total Cost: Costs to plug the wells have not yet been explored.

Control No.	Staff Hours/Expenditures	Fund Expenditures	
		FY 2014/15	Total
970066-00	64 Hrs. / \$1,628.86	\$1,200.00	\$74,212.02
Current Contaminate Level: Monitor wells: 40 ppm Cl- to 775 ppm Cl- Sink Pond: 1401 ppm Cl-			
Status:			
<input type="checkbox"/> 1. Site Assessment	<input type="checkbox"/> 2. Short Term Monitoring	<input type="checkbox"/> 3. Investigation	
<input type="checkbox"/> 4. Long Term Monitoring	<input type="checkbox"/> 5. Remediation Plan	<input type="checkbox"/> 6. Installation	
<input type="checkbox"/> 7. Remediation	<input checked="" type="checkbox"/> 8. Post Rem. Monitoring	<input type="checkbox"/> 9. Resolved	

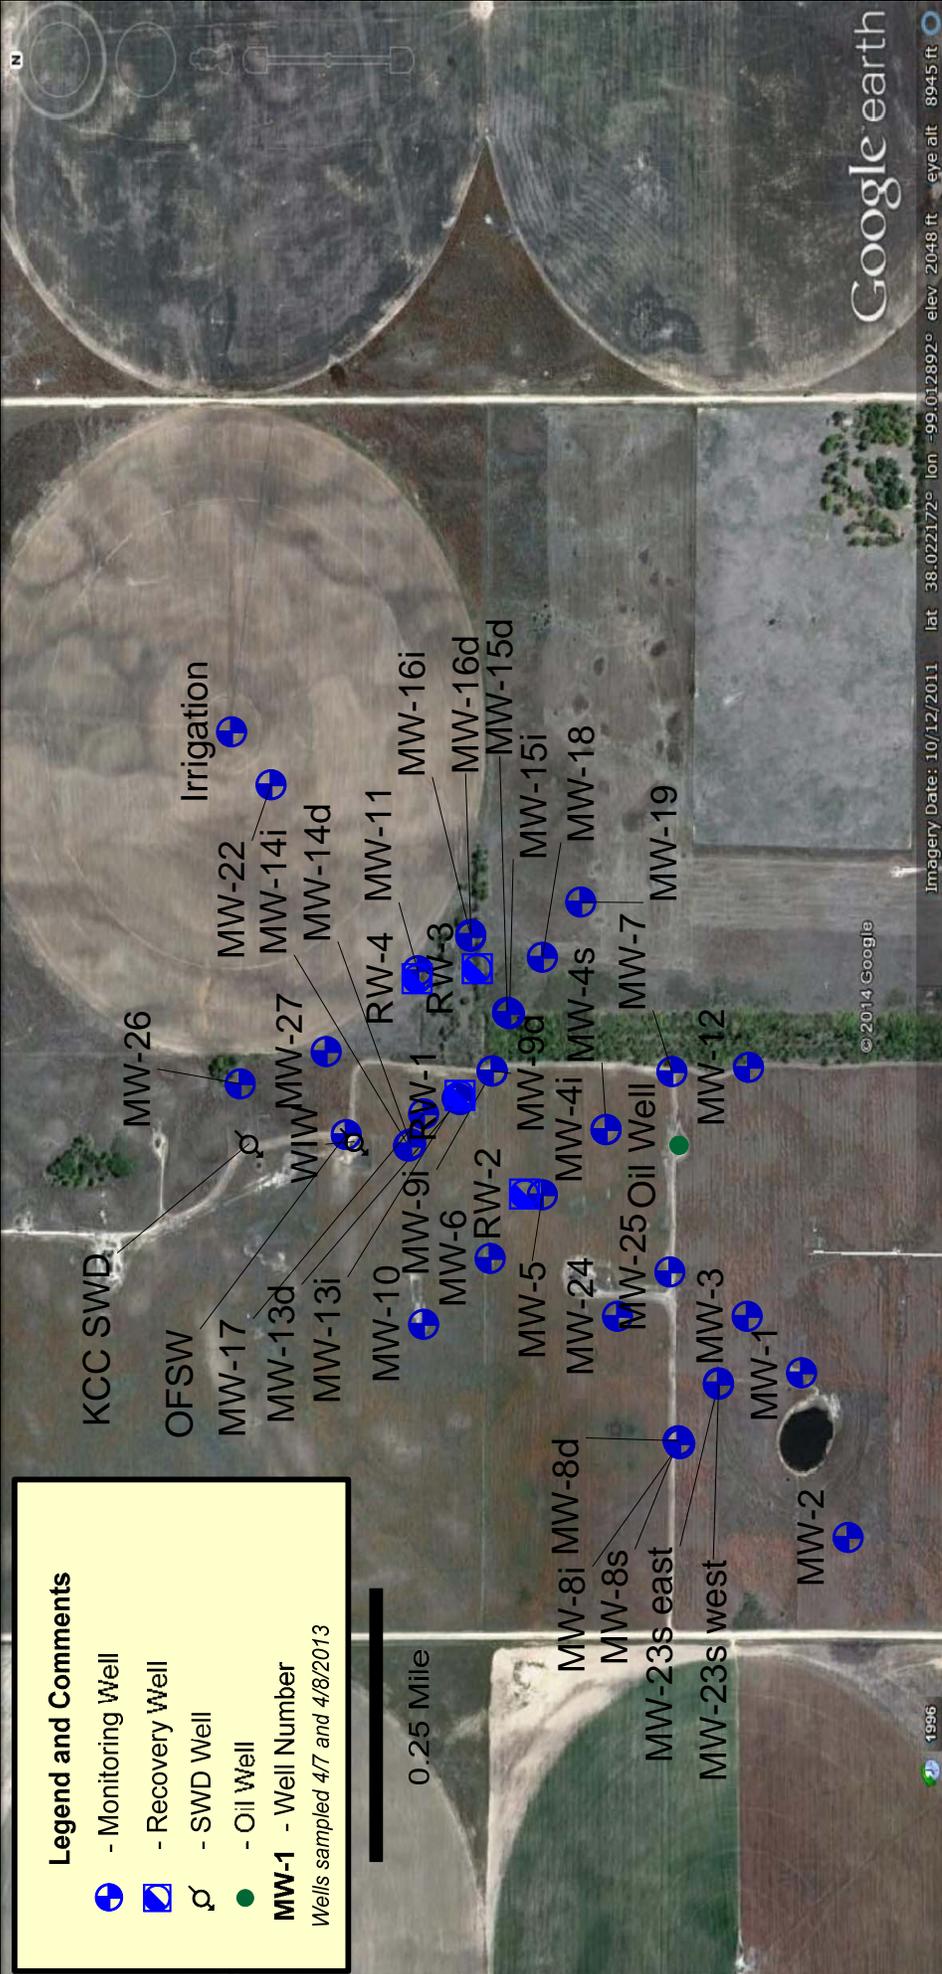


Legend and Comments

-  - Monitoring Well
-  - Recovery Well
-  - SWD Well
-  - Oil Well

MW-1 - Well Number
Wells sampled 4/7 and 4/8/2013

Macksville Site
 Section 30-T-23S-R15W
 Pawnee County, Kansas
2014-2015 Well Location Map
 KCC Control # 970066-00 District 1
 D. Sellers 4/30/14

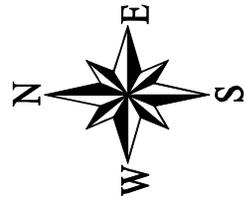

Imagery Date: 10/12/2011 lat 38.022172° lon -99.012892° elev 2048 ft eye alt 8945 ft

Google earth

© 2014 Google

1996

Legend and Comments



250 - Chloride Concentration (mg/L)

 - Monitoring Well

MW-1 - Well Number

Wells sampled 4/7 and 4/8/2013

0.25 Mile

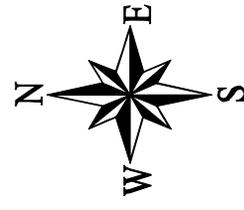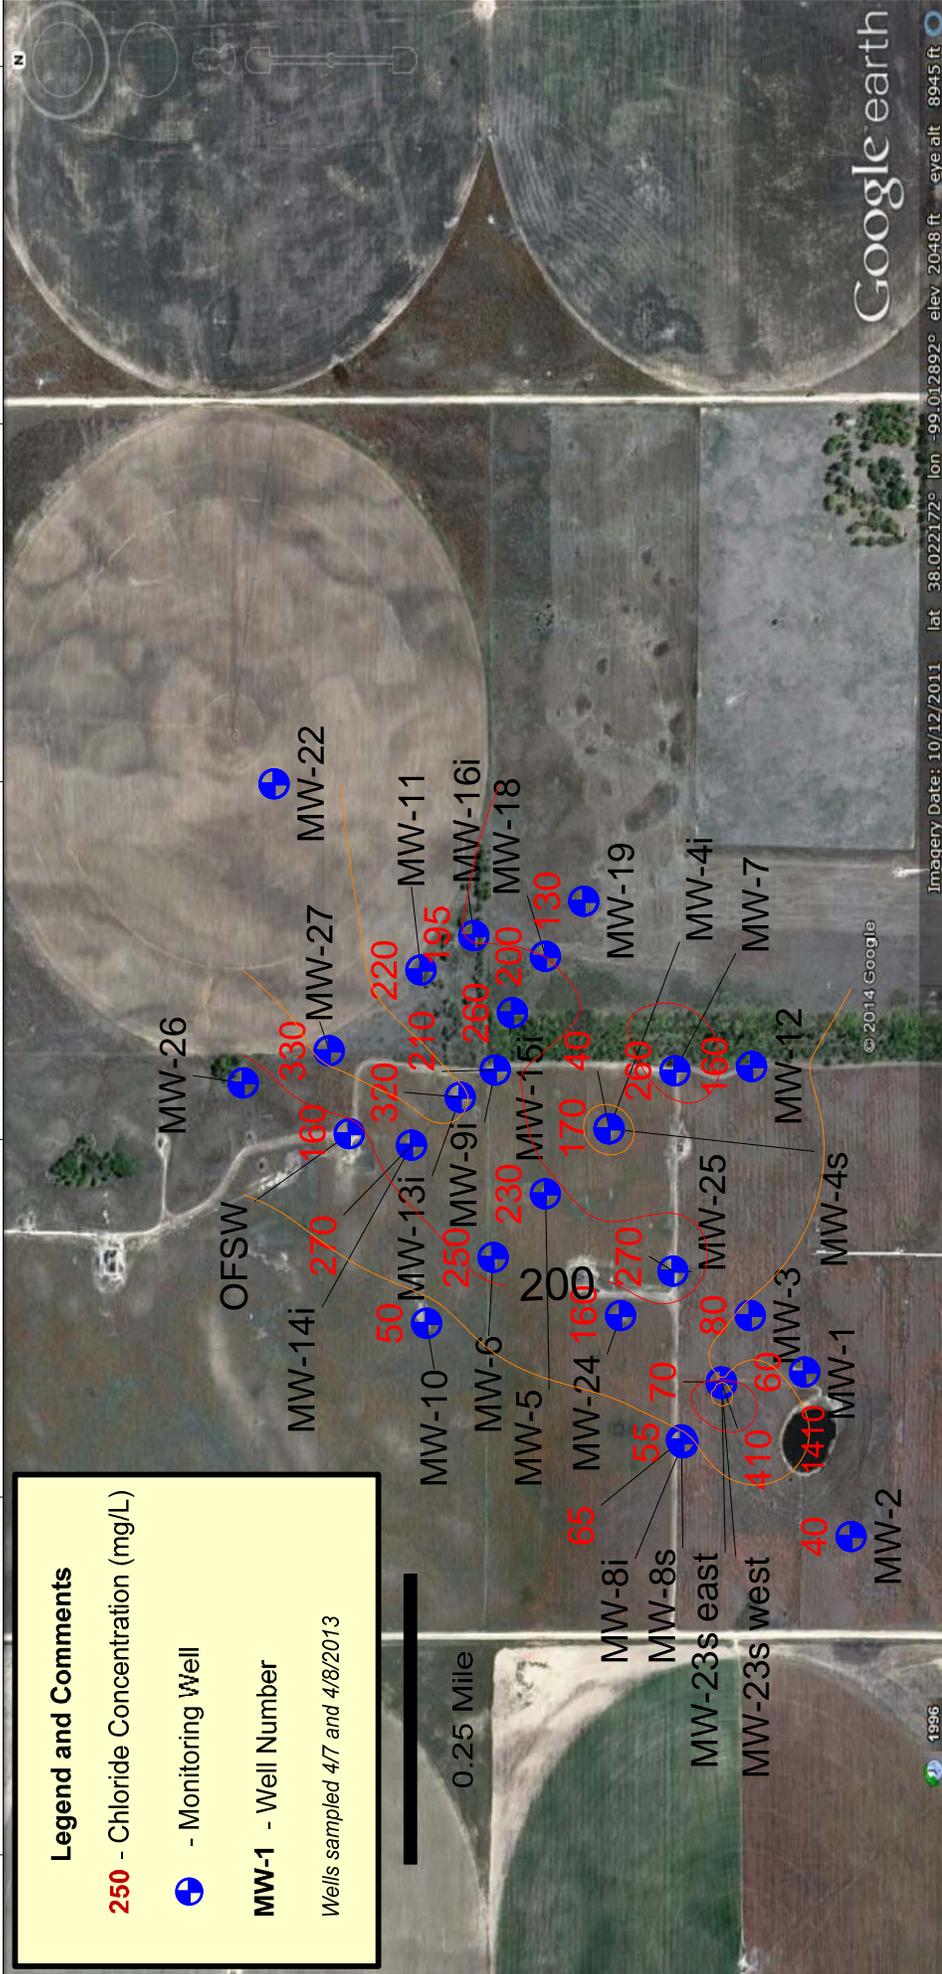

Macksville Site

Section 30-T-23S-R15W
Pawnee County, Kansas

2013-2014 Area Map with Intermediate Depth

Chlorides KCC Control # 970066-00 District 1
D. Sellers 4/30/14



Project: Mantooth Contamination Site

Site Location: Section 29, Township 33 South, Range 14 East, Montgomery County.

Impact/Immediacy: Impact is to surface water and groundwater. The immediacy level is rated as moderate.

Site Description: The initial investigation was begun in May of 1996 by personal from the Chanute Office, in response to a complaint of brine in Deer Creek. At That Time the site consisted of an abandoned oil lease with as many as 41 abandoned well locations, some of which were leaking brine at or near the surface and effecting both surface water and groundwater resources. The site is situated immediately north of Deer Creek, a tributary of the Caney River in the Verdigris River Basin. In the spring of 1999 funds were approved for the excavation of abandoned well sites on this property. During that investigation 25 abandoned wells were confirmed and referenced by GPS.

Unusual Problems: Lack of detailed lease data concerning the number and location of wells drilled in the area is a significant problem in properly and completely assessing potential contaminates source areas for this site. However to date there have been 25 wells plugged in 1999 and an additional 10 wells in 2013. There are also several potential sources being investigated outside the physical lease boundaries of this site.

Status of Project: The Primary Fee Fund Project for this site was completed in the summer of 2000. Twenty-five abandoned wells were plugged. In 2012 the area of interest was expanded resulting in the discovery and plugging of an additional 10 wells in 2013. Data gathered from the well plugging operations and monitoring well sampling indicates that the source of the salt water plume is most likely located in the south half of the project. Leases immediately bordering this site are being inventoried and referenced by GPS to identify further environmental threats outside the original area of concern. The overall Cl- concentrations are still trending down. Six additional monitoring wells were completed in early 2012 to further evaluate the extent and to help determine the possible brine source. The following are the Cl- concentrations of this year's sampling:

MWE 01: 4,500 ppm Cl- (01/29/2014); 4,300 ppm Cl- (7/29/2014); MWE 02: 3,500 ppm Cl- (01/29/2014); 3,400 ppm Cl- (7/29/2014); MWE 03: 3,300 ppm Cl- (01/29/2014); 3,100 ppm Cl-(7/29/2014); MWE 04: 300 ppm Cl- (2/20/2014); 2,300 ppm Cl- (7/29/2014); MWE 05: 200 ppm Cl- (01/18/2014); 500 ppm Cl- (7/29/2014); MWE 06: 500 ppm Cl- (01/18/2014); 600 ppm Cl- (7/29/2014); MWE07: 400 ppm Cl- (1/10/2014); 400 ppm Cl- (7/29/2014).

Level of Remediation Sought:

Ideal: Less than 250 ppm Chloride

Target: 500 ppm Chloride

Recommendation for Future Work: Continue monitoring in order to verify whether plugging of the existing abandoned wells eliminates the current source of saltwater contamination within the ground and surface water in the project area. Future work will be based upon the results of the sample analysis of the monitoring wells and Deer Creek. There have been 20 new CBM wells and associated SWD wells drilled in the last few years in section 20 & 29.

Estimated Total Costs: Fee Fund Plugging of 10 abandoned wells cost \$77,926.

Control No.	Staff Hours/Expenditures	Fund Expenditures	
		FY 2014/15	Total
980058-001	59.5 Hrs. / \$1,571.14		\$17,349
Current Contaminate Level: 200 ppm to 4,500 ppm Cl- Status: Active			
<input type="checkbox"/> 1. Site Assessment	<input type="checkbox"/> 2. Short Term Monitoring	<input checked="" type="checkbox"/> 3. Investigation	
<input checked="" type="checkbox"/> 4. Long Term Monitoring	<input type="checkbox"/> 5. Remediation Plan	<input type="checkbox"/> 6. Installation	
<input type="checkbox"/> 7. Remediation	<input type="checkbox"/> 8. Post Rem. Monitoring	<input type="checkbox"/> 9. Resolved	

KANSAS CORPORATION COMMISSION

Mantooth Remediation Site
Sec 20 & 29 - T33S - R14E
Montgomery County, Kansas
Project 980058-001

11/20/2014 District 3

● Active Gas Well


⊗ Fee Fund Plugged Well

○ Abandoned Well

■ Monitoring Well

~ CI- Concentration Contour = 250 ppm

900 ft

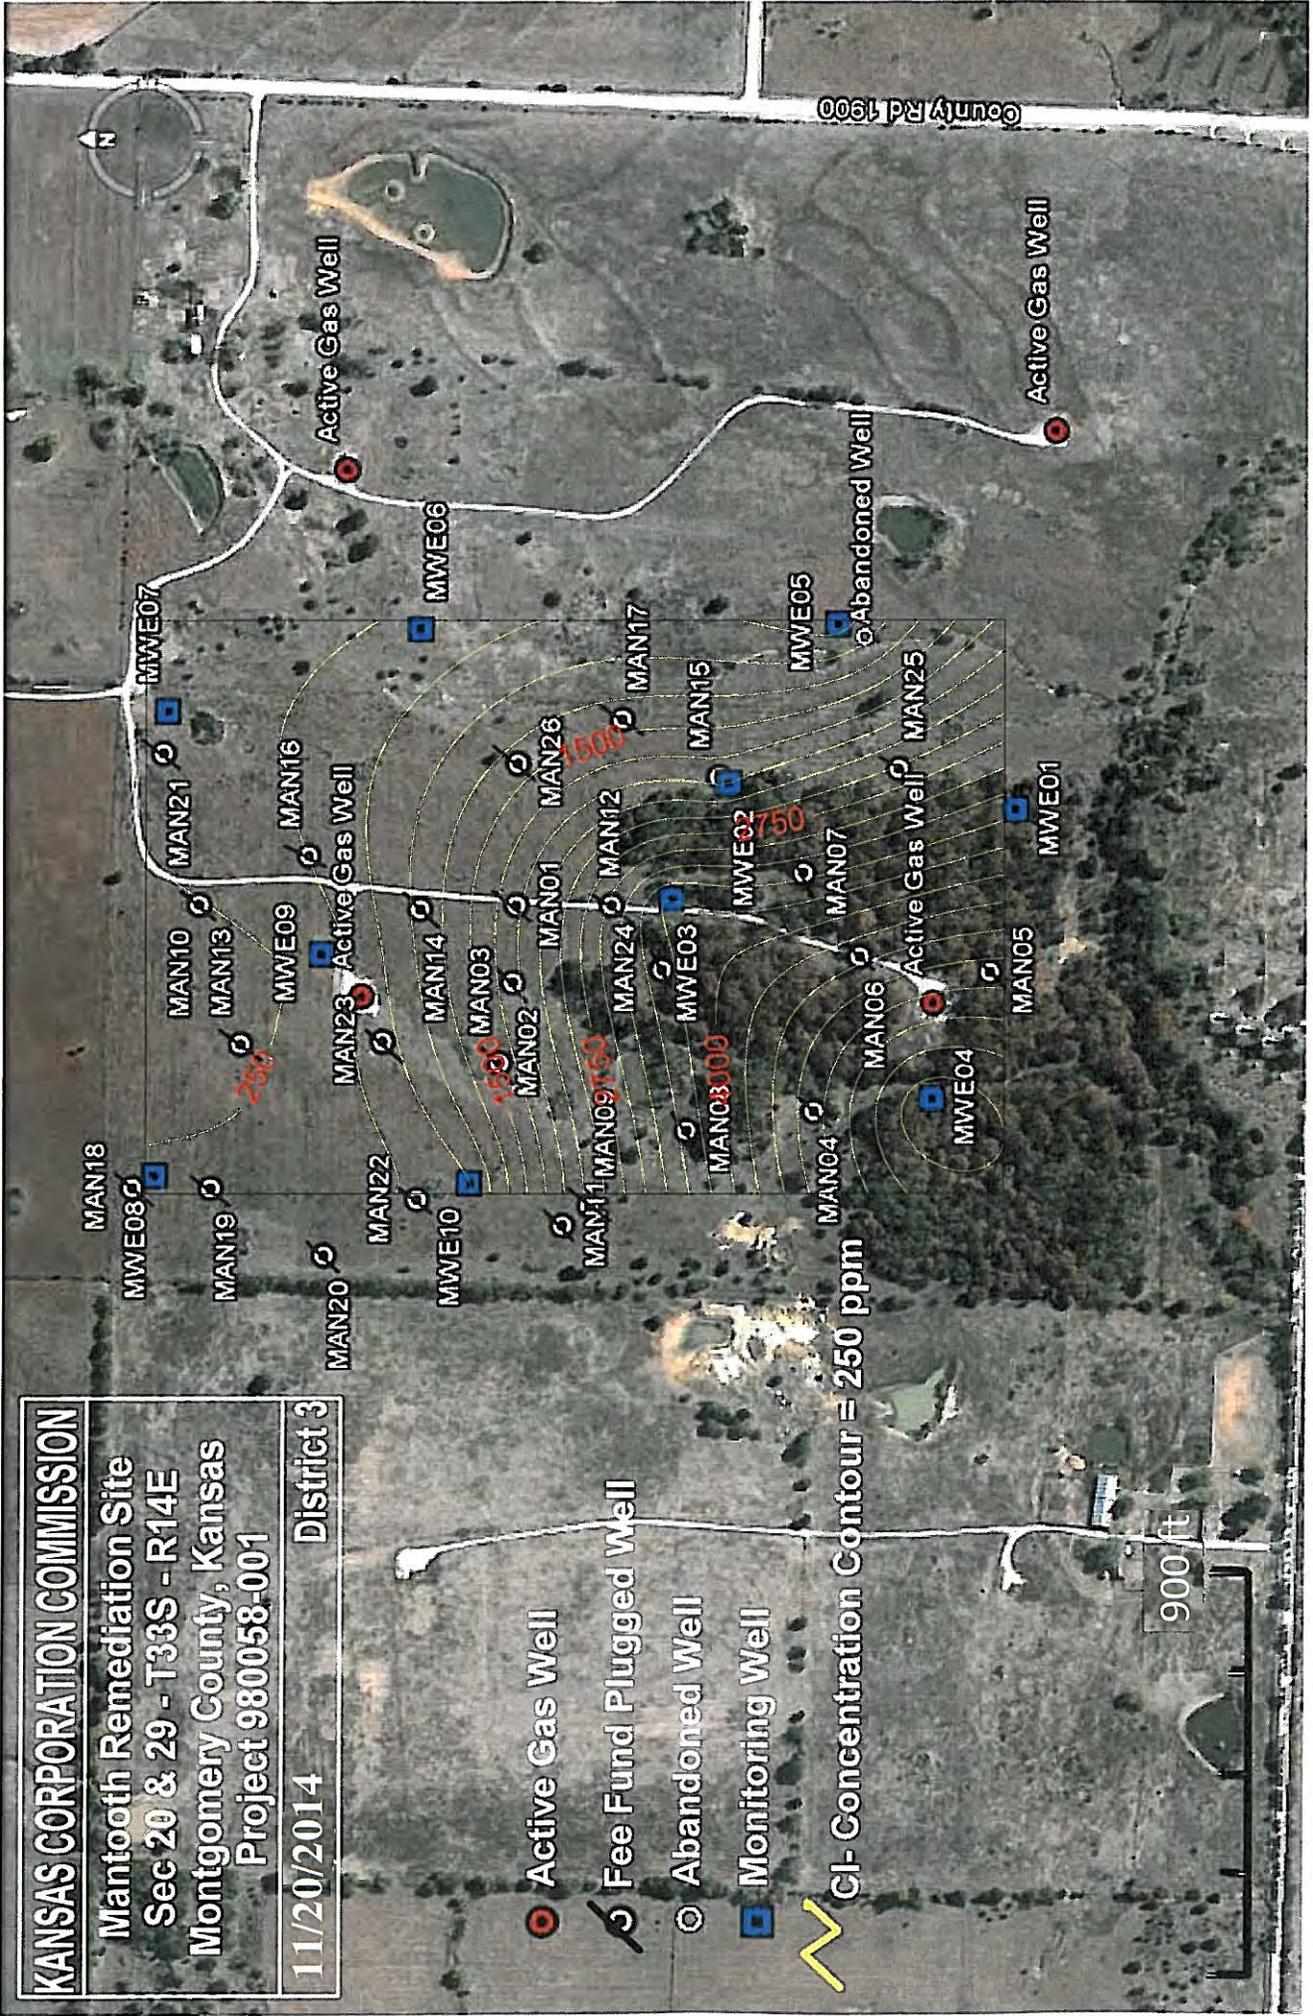

Project: Tom Maupin Contamination Site

Site Location: SE/4 of Section 9, Township 11 South, Range 15 West, Russell County.

Impact/Immediacy: Brine contamination of a shallow aquifer and a spring which is utilized for cattle. Immediacy level is rated as low.

Site Description: The site is rangeland at the head of a drainage within the Saline River Basin. Originally, the primary source of water for cattle in the pasture was a spring which had been developed as a source by diverting its water to an open stock tank. Nearby water wells and ponds were experiencing increases in chloride concentration by 1956, and a complaint regarding high chlorides in this spring was made in 1991. Following an investigation, five monitoring wells were drilled on the location, and the waters of this basin ranged in chlorides, including the spring, from 200 ppm to 3,400 ppm throughout the history of sampling. While the pollution has never caused the water to become unusable, the concentration of chloride in the spring is too high if it is the sole source of water for the cattle. However, a new stock tank which is fed by the Ellsworth Rural Water District #1 is now available for the cattle to drink from.

Unusual Problems: None

Status of Project: At this time, the chloride concentrations in the monitoring wells are 550 ppm at monitoring well 3, and 1,050 ppm at monitoring well 5, and the concentration of the spring-fed stock tank ranged from 2,180 ppm in April 2014 to 1,400 ppm in September 2014. At this time, these levels do not warrant additional action aside from continued monitoring.

Level of Remediation Sought:


Ideal: 250 ppm Chloride

Target: 500 ppm Chloride


Recommendations for Future Work: This site will continue to be monitored on an annual basis until closure.

Estimated Total Costs: \$2000.00

Control No.	Staff Hours/Expenditures	Fund Expenditures	
		FY 2014/15	Total
970068-00	53 Hrs. / \$1,285.30		
Current Contaminate Level: 550 ppm to 1,400 ppm Cl⁻			
Status:			
<input type="checkbox"/> 1. Site Assessment	<input type="checkbox"/> 2. Short Term Monitoring	<input type="checkbox"/> 3. Investigation	
<input checked="" type="checkbox"/> 4. Long Term Monitoring	<input type="checkbox"/> 5. Remediation Plan	<input type="checkbox"/> 6. Installation	
<input type="checkbox"/> 7. Remediation	<input type="checkbox"/> 8. Post Rem. Monitoring	<input type="checkbox"/> 9. Resolved	

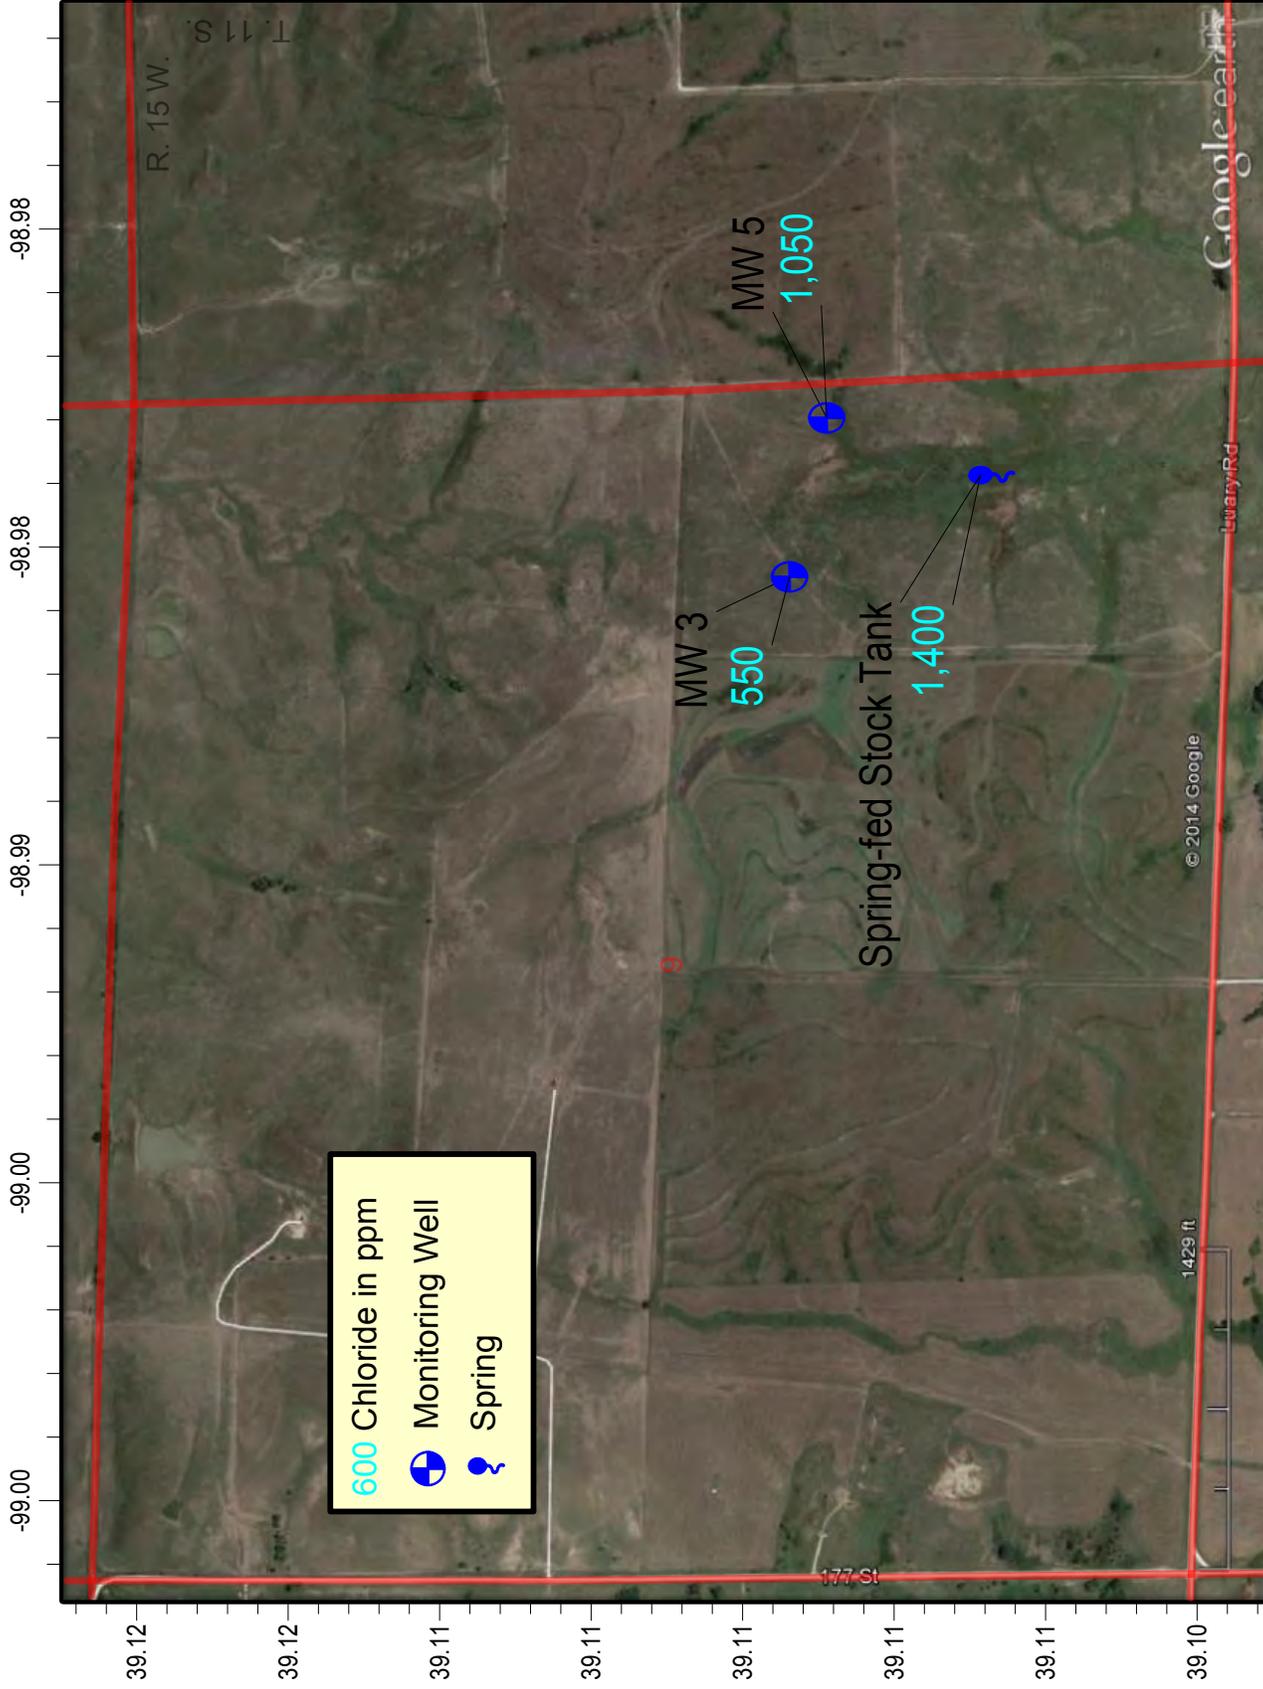

Maupin Groundwater Monitoring Site
 Section 9, Township 11 South, Range 15 West, Russell County, Kansas
 2014 Groundwater Chloride Levels
 District #4 - Sampled on 4/24/2014 and 9/16/2014
 Map Drawn on 9/17/2014 by C. Neeley

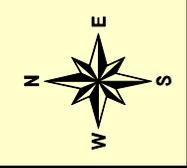

Project: *McDonald-East Contamination Site*

Site Location: NW/4 of Section 27, Township 19 South, Range 22 East, Linn County.

Impact/Immediacy: Impact is to the surface water. Immediacy level is rated as low.

Site Description: This site is located at the bottom of a small, fairly steep drainage in the Cherryvale Shale. A seep originating from this drainage tested 3,300 ppm chloride in 1991, 6,500 ppm chloride in 1992, 750 ppm chloride on September 26, 1995 and 380 ppm chloride on January 26, 1998. Seepage within the drainage is intermittent based on precipitation in the area.

Unusual Problems: None.

Status of Project: The State has made an agreement with a local Operator to put this lease back into production and plug several of the injection wells and older oil wells. There are six monitoring wells located on the McDonald East Site in the NW ¼ of section 27–T19S–R22E. The following Cl- concentrations of sample results were obtained on 3/11/2014 and 7/31/2014:

- Monitoring well#2 (MCDE02): 400 and 500 ppm Cl-
- Monitoring well#3 (MCDE03): 500 and 600 ppm Cl-
- Monitoring well#4 (MCDE04): 900 and 1,000 ppm Cl-
- Monitoring well#5 (MCDE05): dry and 1,000 ppm Cl-
- Monitoring well#6 (MCDE06): 400 and 400 ppm Cl-

Cl- levels spiked during 2010 and since have been trending down. Further monitoring will be necessary as Operator continues to bring lease back into production and designated wells plugged.

Level of Remediation Sought:

- Ideal:** 200 ppm Chloride
- Target:** 500 ppm Chloride

Recommendation for Future Work: Continue sampling bi-annually and monitoring injection activity on this lease.

Estimated Total Costs: \$1,500.00 yearly.

Control No.	Staff Hours/Expenditures	Fund Expenditures	
		FY 2014/15	Total
970070-00	70 Hrs. / \$1,847.18		
Current Contaminate Level: 400 ppm Cl- to 1,000 ppm Cl-			
Status: Active			
<input type="checkbox"/> 1. Site Assessment	<input type="checkbox"/> 2. Short Term Monitoring	<input type="checkbox"/> 3. Investigation	
<input checked="" type="checkbox"/> 4. Long Term Monitoring	<input type="checkbox"/> 5. Remediation Plan	<input type="checkbox"/> 6. Installation	
<input type="checkbox"/> 7. Remediation	<input type="checkbox"/> 8. Post Rem. Monitoring	<input type="checkbox"/> 9. Resolved	

KANSAS CORPORATION COMMISSION

McDonald East Remediation Site
NW 27 - T19S - R22E
Linn County, Kansas
Project 970070-00


11/20/2014

District 3

□ Monitoring Well

~ Cl- Concentration Contour = 50 ppm

200 ft

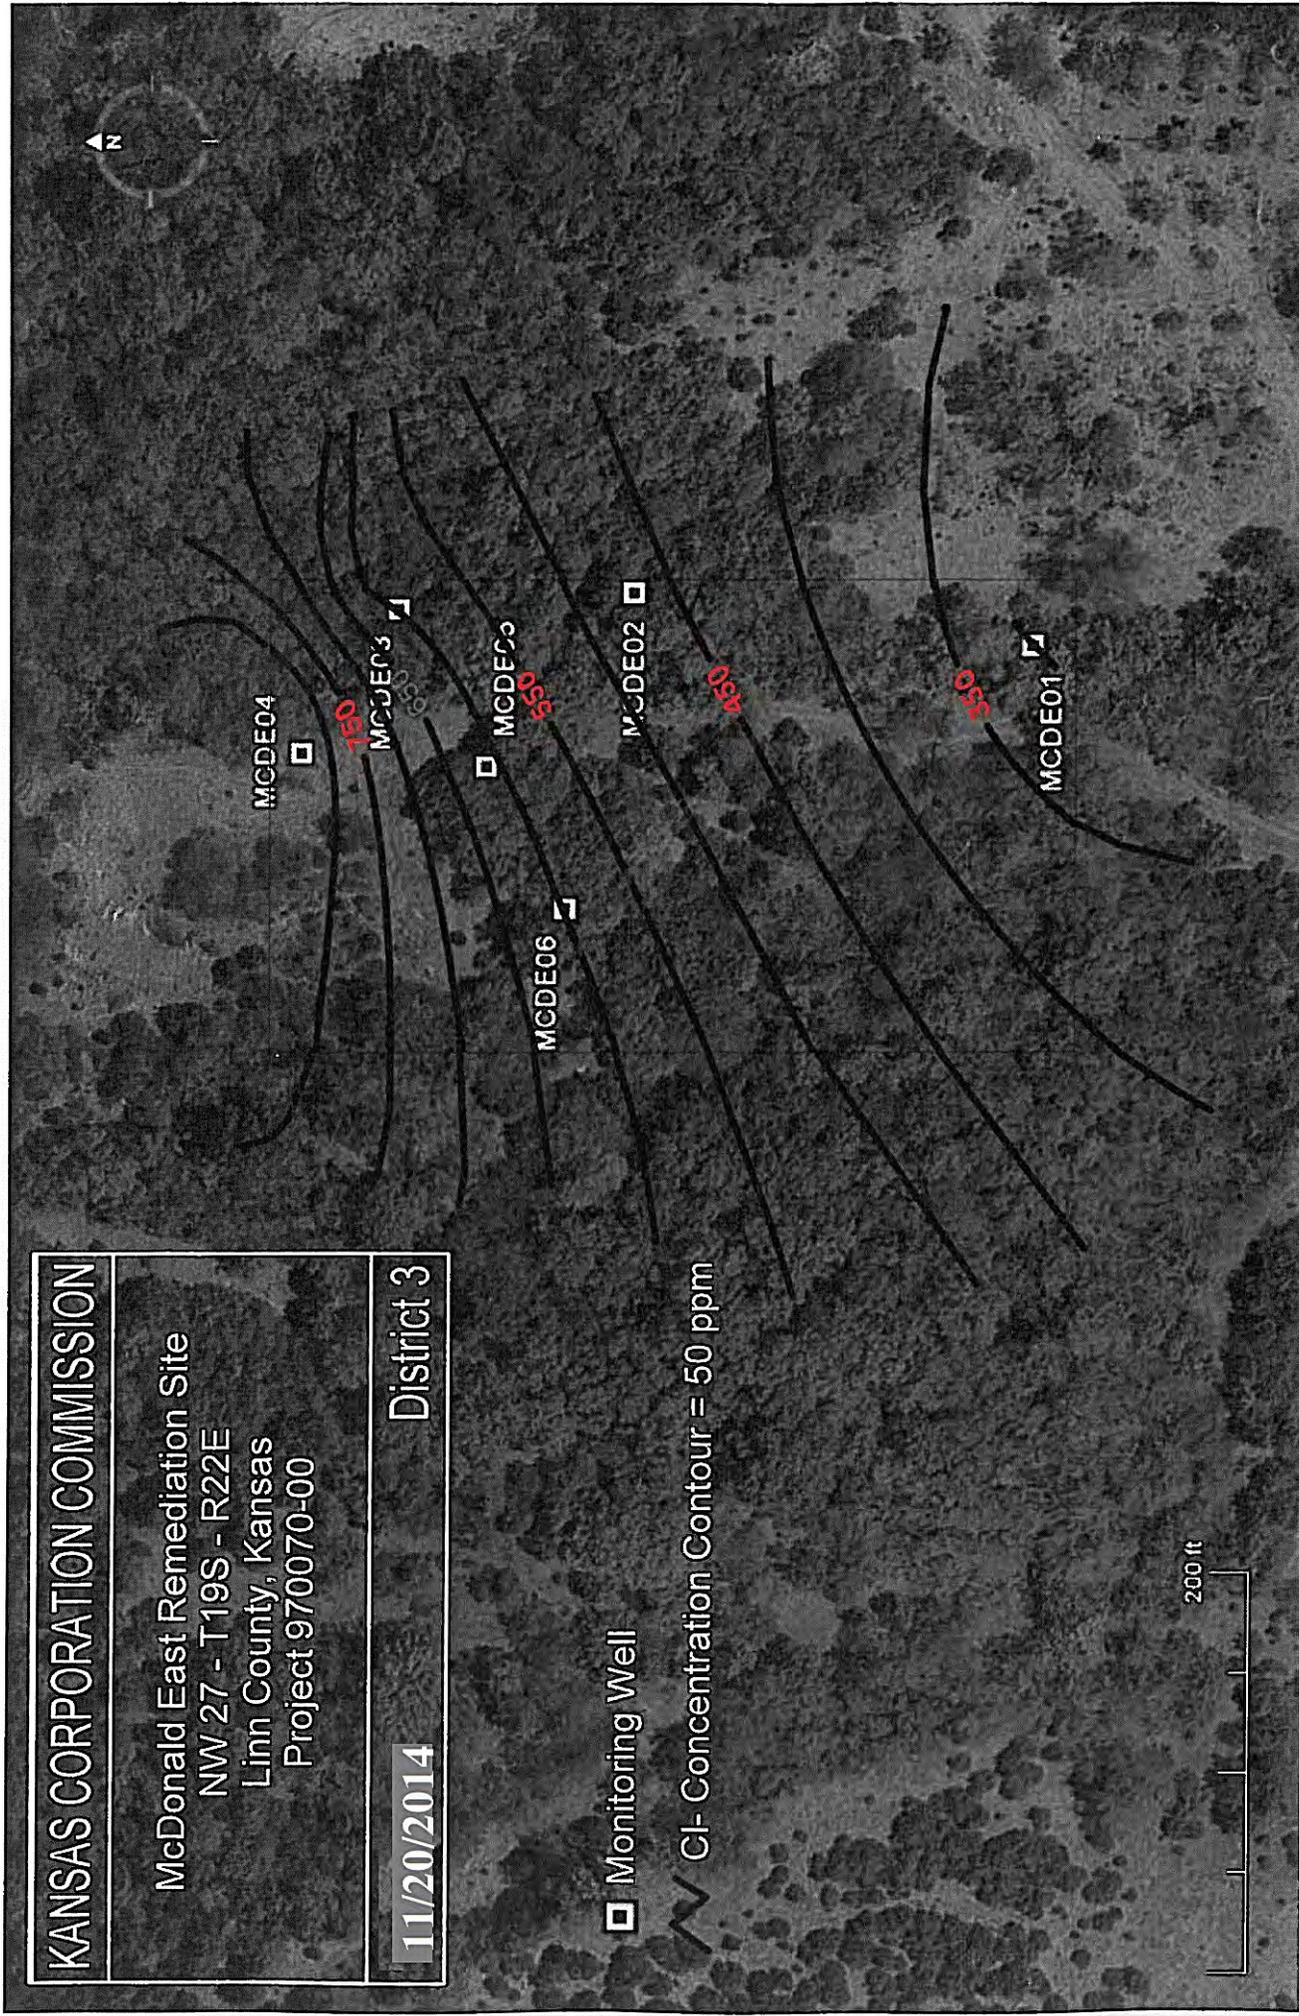

Project: McPherson Landfill-Johnson Oil Field Contamination Site

Site Location: The McPherson Landfill itself is located in Section 34, Township 19 South, Range 3 West, in McPherson County, approximately .75 miles southeast of the city of McPherson. The affected areas include Sections 33 & 34, Township 19 South, Range 3 West, and Sections 3,4 & 5, Township 20 South, Range 3 West.

Impact/ Immediacy: The contamination has impacted industrial water supply wells for National Cooperative Refinery Association (NCRA), as well as domestic rural water wells. This site has a moderate to high immediacy level.

Site Description: The site is located in rural McPherson County near the landfill and the NCRA refinery. The area of contamination lies on the west side of the Johnson Oil Field, which is the probable source of the high salinity in the ground water.

Unusual Problems: None.

Status of Project: Since 2003 NCRA has annually provided a report on their East Refinery Groundwater Quality Improvement Project, and the Groundwater Monitoring Plan. A full report from the consulting company, Trihydro Corporation is on file with the KCC. The goals for this project include mitigating chloride impacted oil field brine water migrating from the Johnson Oil field east of the refinery, and preventing lateral movement of the identified hydrocarbon plume beneath the refinery toward the chloride remediation system. The remediation system consists of 12 recovery wells, RW-7 through RW-18, which are all screened in the lower portion of the Equus Beds aquifer.

In 2013 to demonstrate that refinery related impacts were not being intercepted by the recovery well network, five chloride monitoring wells (CENEX-1, KDHE-9R, MW-114S, MW-125R and MW-126R) were sampled for total petroleum hydrocarbons as gasoline-range organics (TPH-GRO). TPH-GRO was not detected in any of the 2013 samples. Overall chloride levels in the 16 deep screened monitoring wells reported on did not change significantly in 2014 except for EB402C. EB402C is southeast of the NCRA Refinery and has historically had the highest chloride levels since the start of the project. Levels increased from 3,630 mg/l in 2013 to 5,400 mg/l in 2014. Additional sampling should be done in 2015 to monitor this spike to determine if this was in error, or if plume movement has occurred. EB402C is not near any of the recovery wells, therefore recovery efforts should not be affecting this MW. KCC will coordinate with KDHE to sample the KDHE monitoring wells located at the old McPherson Landfill in 2015. KDHE did not sample their monitoring wells in 2014.

Level of Remediation Sought:

Ideal: 250 ppm chlorides

Target: 500 ppm chlorides.

Recommendations for Future Work: Collect data on an annual basis from NCRA, and GMD2.

Estimated Total Costs: KCC provides funding to GMD2 for sampling surrounding monitoring wells.

Control No.	Staff Hours/Expenditures	Fund Expenditures	
		FY 2014/15	Total
980034-001	12 Hrs. / \$364.06	\$663.83	\$19,817.81
Current Contaminate Level: 58mg/l (MW-2) to 5,400 mg/l (EB 402C)			
Recovery wells ranged from 442mg/l (RW-7) to 1,050mg/l (RW-12)			
Status:			
<input type="checkbox"/> 1. Site Assessment	<input type="checkbox"/> 2. Short Term Monitoring	<input type="checkbox"/> 3. Investigation	
<input checked="" type="checkbox"/> 4. Long Term Monitoring	<input type="checkbox"/> 5. Remediation Plan	<input type="checkbox"/> 6. Installation	
<input checked="" type="checkbox"/> 7. Remediation (NCRA)	<input type="checkbox"/> 8. Post Rem. Monitoring	<input type="checkbox"/> 9. Resolved	

R 3 W

McPherson

T 19 S
T 20 S


5

2

T 20 S

8

11

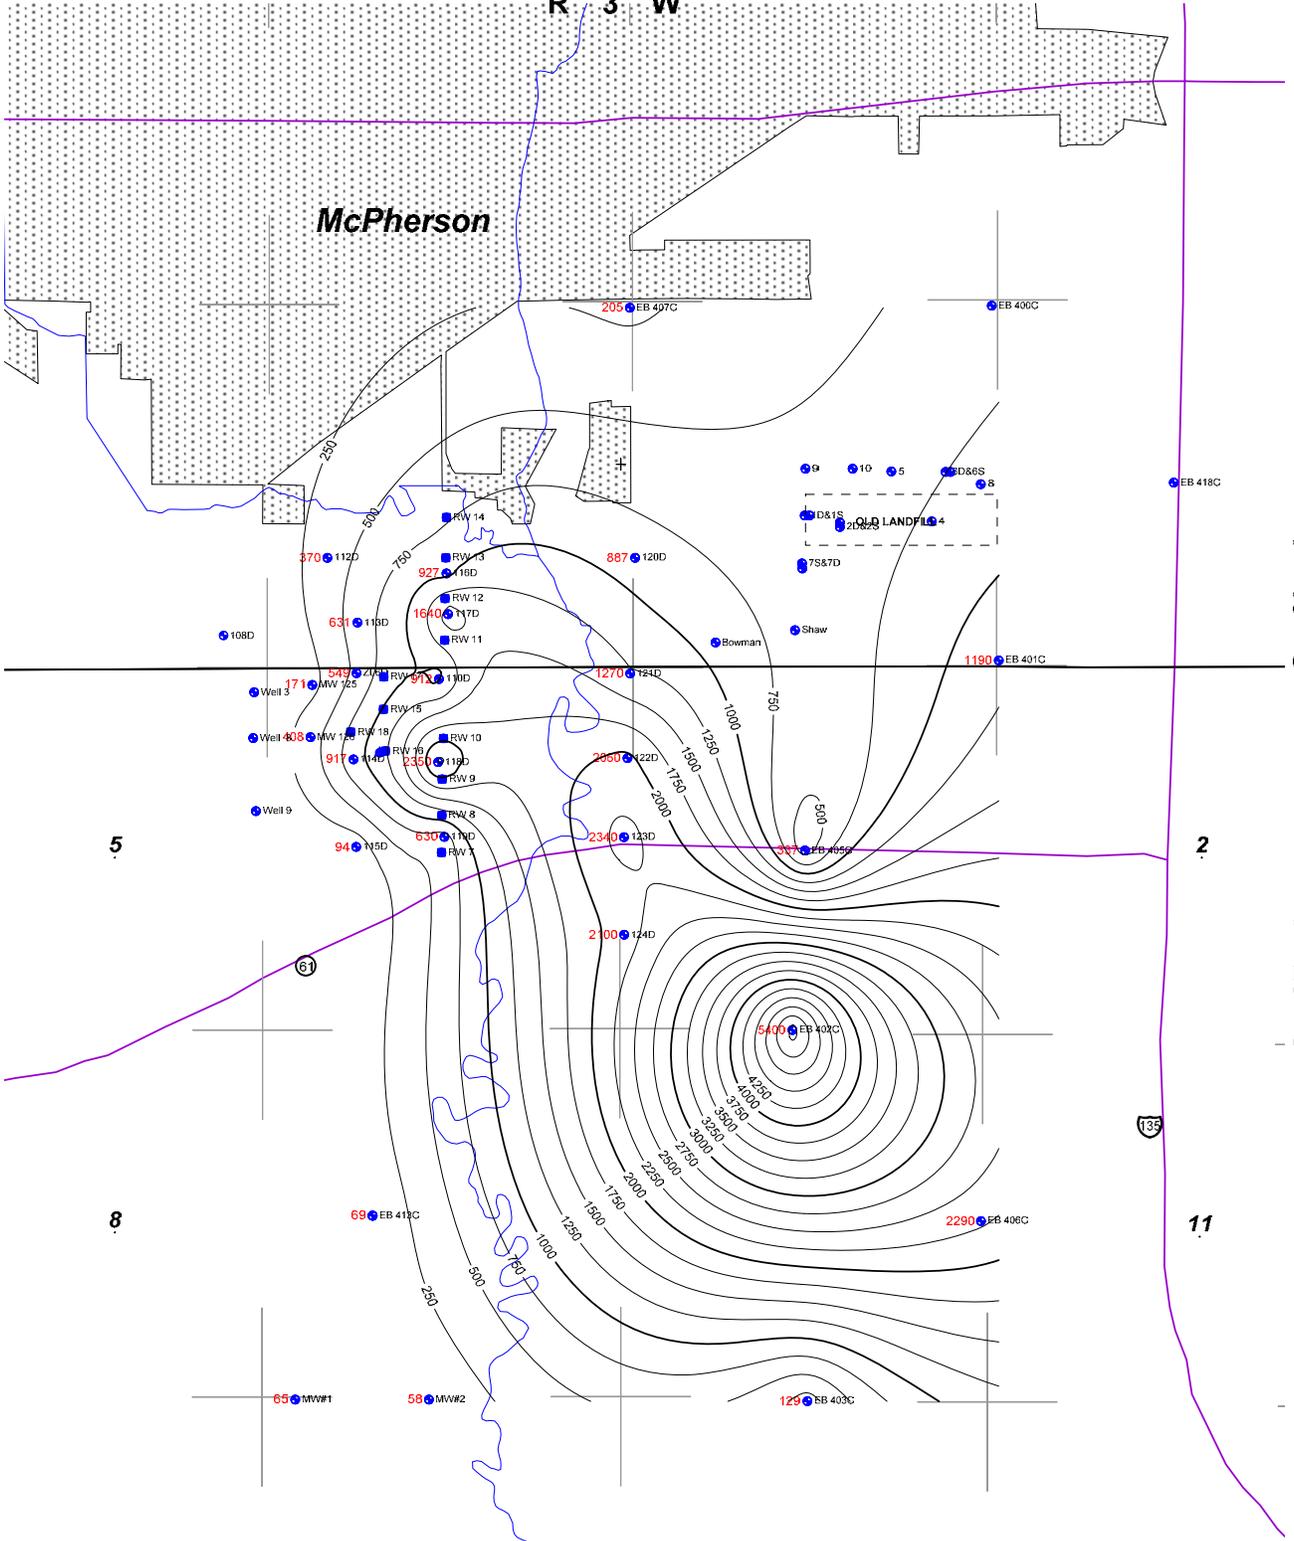

LEGEND

- Monitoring Well
- NCRA Recovery Well
- ⊕ NCRA Water Supply Well

1880 ● 118D Numbers in RED are Chloride Values
 Numbers in BLACK are Monitoring Well Numbers

Contour Interval = 250 mg/l


KANSAS CORPORATION COMMISSION

McPherson Landfill-Johnson Oil Field 2014

2014 CHLORIDE CONTOUR MAP

T19S & T20S-R3W, McPherson County, KS

Dist. 2 Control No. 990034-01 10-14-2014 J. Klock

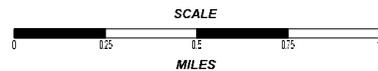

Project: Nikkel-Epps

Site Location: The Nikkel-Epps contamination site is located in the NE/4 of Section 18, Township 20 South, Range 1 West, in McPherson County.

Impact/Immediacy: Medium-high immediacy level. Chlorides here affect a shallow groundwater aquifer with multiple residences within a half mile some of which use the aquifer as the sole source of water. There is crop irrigation in the area side and down gradient as well.

Site Description: The aquifer consists of two to three sand units separated by clay layers. At the base of the aquifer lies the Wellington Shale. The aquifer appears to contain several possible aquitards, which could be impermeable clays separating the sands. It is unknown if these clays are continuous throughout the area. Due to the depth that the saltwater has been found it is assumed that potential pathways down to the Wellington formation exist. The land surface is flat irrigated farmland. Chlorides seem to be settling along the Wellington Shale contact. The top of the Wellington is an erosional disconformity which can allow for high relief channels and bumps with in the shallow aquifer.

Unusual Problems: Like many other chlorides problems in the area, the chlorides can be hit and miss and contained in 'hot spots' down-gradient of old evaporation pits and settling in deeper pockets within the aquifer.

Status of Project: Research done by Jeff Klock on the Epp's complaint in 2007 found that historically there have been other complaints and records of contamination around the Epp Site. On 3/6/2007 Mike Peterson, of Peterson Irrigation, called the KCC to report that the four irrigation wells he had installed for Ted Nikkel on the Epp's Property had become salty. On 3/7/2007, Jeff Klock with the KCC was onsite to investigate and took samples of the water from the irrigation wells. The Main well tested over 5,000 ppm chlorides. Samples sent to Dr. Donald Whittmore, at the Kansas Geological Survey, were found to have oil field brine as the source of the chlorides. On 8/26/2008, David Bollenback with the KCC returned to the site and sampled the three remaining irrigation wells. Sampling results ranged from 4,500 to 400 ppm chlorides increasing towards the south and the main well. Data from the irrigation logs indicate this maybe due to greater sand development towards the center of the site, which could account for the sinking saltwater plume. A composite sample of all the irrigation wells tested to be 2,300-ppm chlorides and is unusable for agricultural use. KCC recommended that the irrigation well not be used at this time. 6/4/09 KCC sampled the Ratzlaff house well just south of the irrigation wells and lab results at the KCC lab showed that chlorides were 890 ppm. The Ratzlaff's house well is their only source of water at this time.

Monitoring well drilling commenced on November 30, 2011 where MW-1, MW-2, and MW-4 were drilled and completed. Heavy rains limited Rig and truck access until February 1, 2012. MW-3, MW-5, MW-3S, and MW-4S were drilled and installed between February 1 and 2, 2012.

On September 19, 2014, MW-2, MW-3, MW-3S, and MW-5 groundwater monitoring wells, were gauged and sampled for chloride levels. KCC discovered at that time agricultural equipment had knocked over and broken MW-1, MW-4, and MW-4S which are located along the road on the north side of section 18. All monitoring wells were clearly marked with yellow KCC identification stickers and 6 feet long PVC markers prior to this occurrence. Samples could not be obtained during the event. KCC is evaluating the possibility of repair some or all of the wells, though it is unclear if it is possible.

Level of Remediation Sought:

Ideal: <250 ppm


Target: 500 ppm

Recommendations for Future Work: KCC has contacted the township and is looking for information regarding the individuals that broke the monitoring wells that were just installed just over two years ago. KCC will determine if the wells can be repaired and will evaluate further action regarding these wells at that time.

Further soil borings and monitoring wells are needed to the north of the site. MW-2 has increased in chlorides since last year and confirms the need for an investigative Phase II work scope should be drawn up for consideration. New work will need to be focused to the north and east of the current site. Evidence suggests that the main brine plume has a source(s) in section 7.

Estimated Total Costs: \$10,000 to \$30,000 to drill the new wells during a Phase II investigation. The KCC District #2 will also need funding for sampling, research, and report preparation.

Control No.	Staff Hours/Expenditures	Fund Expenditures	
		FY 2014/15	Total
20100082-001	33 Hrs. / \$845.49		\$8,318.75
Current Contaminate Level: MW-3 260 ppm to MW-2 1400 ppm.			
Status:			
<input checked="" type="checkbox"/> 1. Site Assessment	<input type="checkbox"/> 2. Short Term Monitoring	<input checked="" type="checkbox"/> 3. Investigation	
<input type="checkbox"/> 4. Long Term Monitoring	<input type="checkbox"/> 5. Remediation Plan	<input type="checkbox"/> 6. Installation	
<input type="checkbox"/> 7. Remediation	<input type="checkbox"/> 8. Post Rem. Monitoring	<input type="checkbox"/> 9. Resolved	

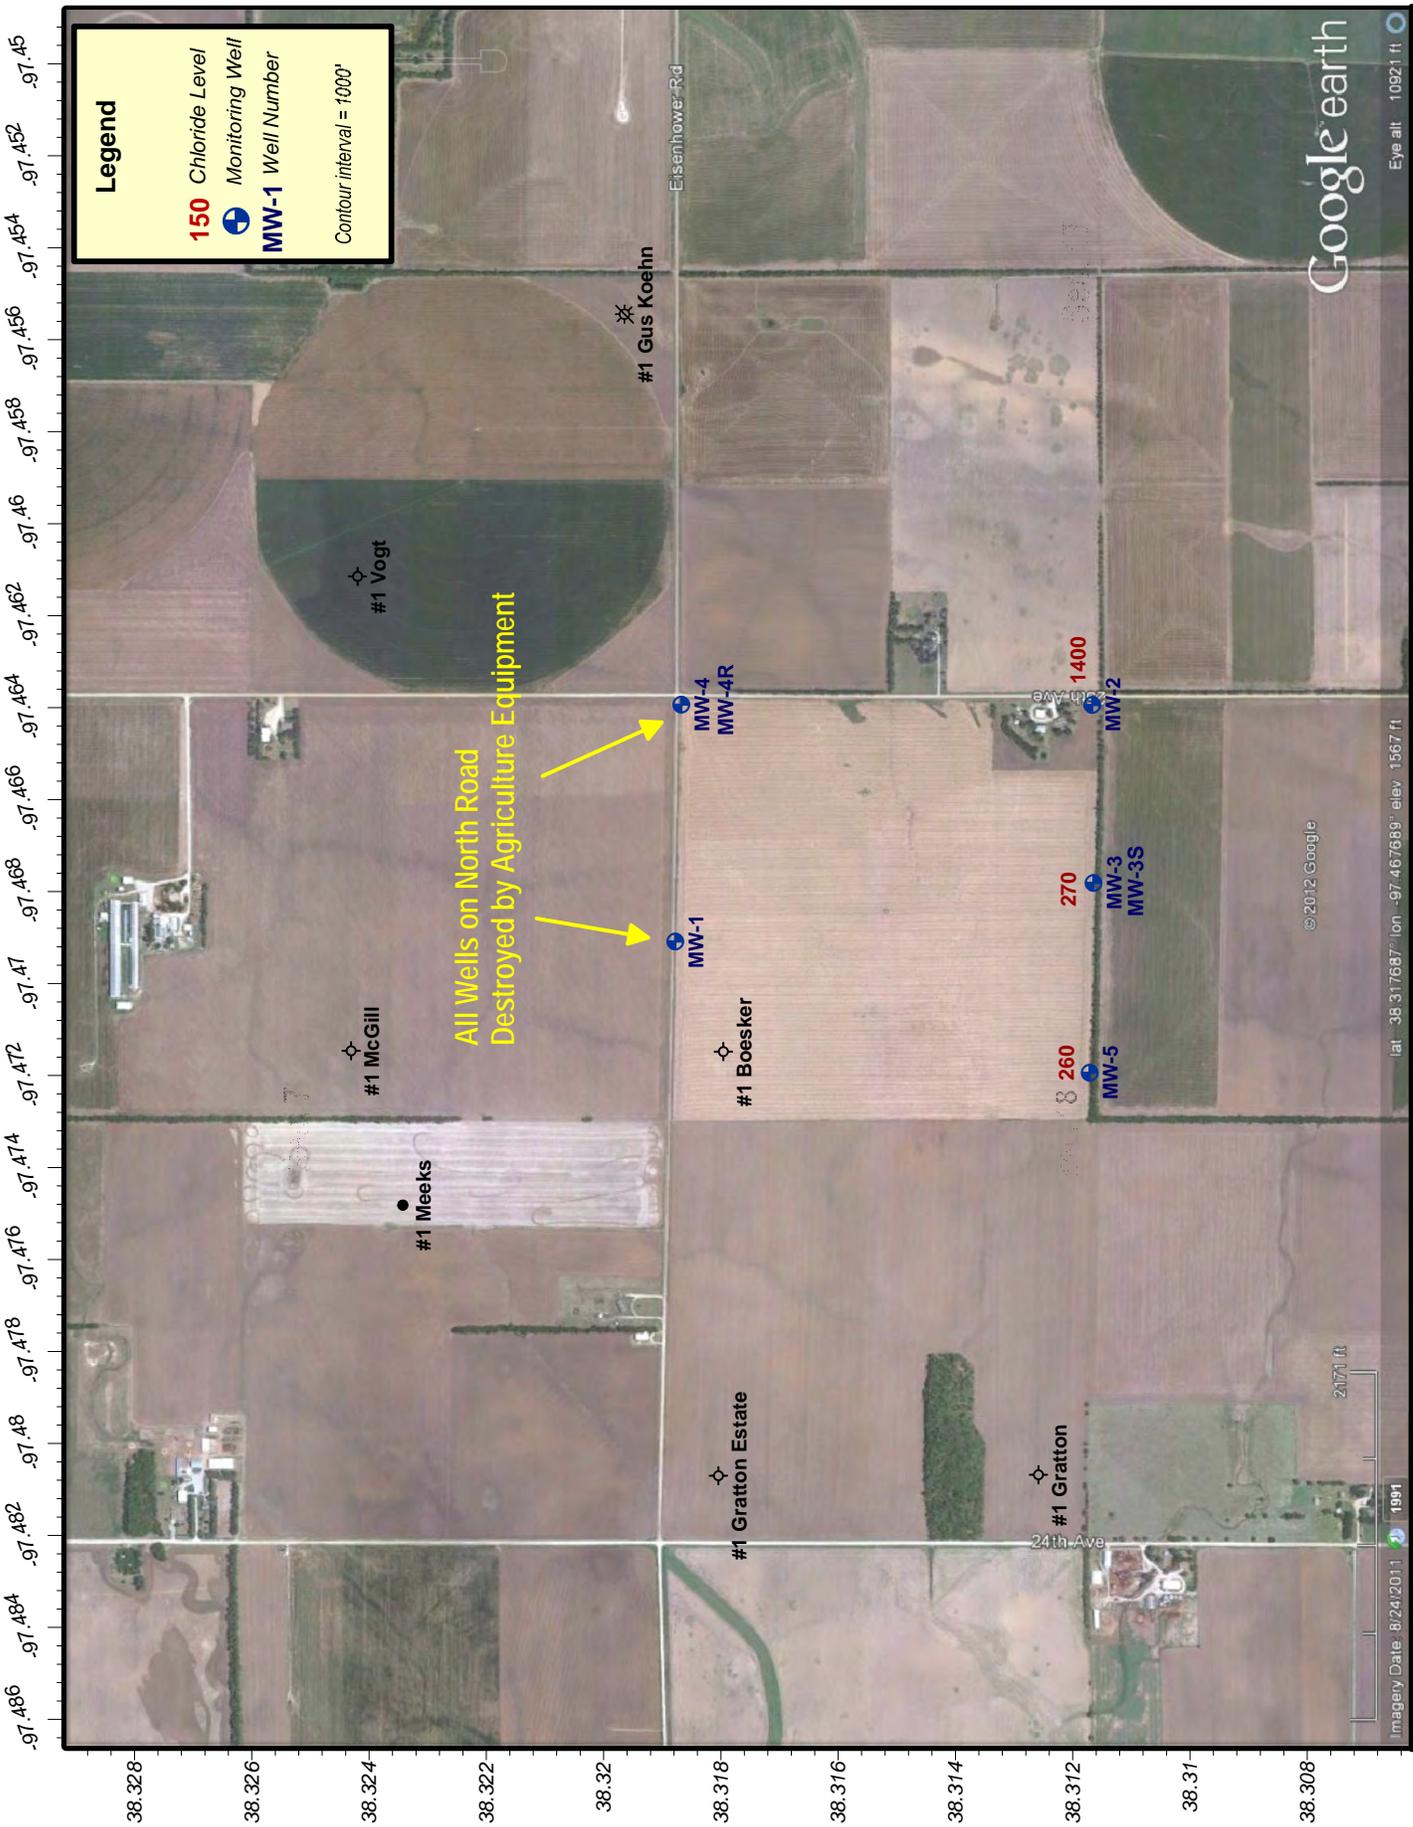

Legend

- 150 Chloride Level
- + Monitoring Well
- MW-1 Well Number

Contour interval = 1000'

All Wells on North Road
Destroyed by Agriculture Equipment

Figure
1

Nikkel-Epps Contamination Site
NE Section 18 of T20S & R1W, McPherson County, Kansas
2014 Deep Monitoring Well Chlorides
District #2 - Control# 20100082-001 - Drawn on: 11/20/2014 by D.Bollenback

Kansas
Corporation Commission

Imagery Date: 8/24/2011 1991

lat: 38.317687° lon: -97.467669° elev: 1567 ft

© 2012 Google

Google earth

Eye alt: 10921 ft

Project: Packard Contamination Site

Site Location: Legal location is Section 15, 22, 23 Township 31 South, Range 13 West, in Barber County. 7 miles west of Medicine Lodge on river road.

Impact/Immediacy: The ground water has been contaminated, and a very good water well has been contaminated with chlorides. Immediacy level is rated as moderate.

Site Description: The salt-water plume is moving to the south away from the Packard #1 oil well. It has contaminated the water supply well and could possibly damage the domestic well at the abandoned house, the supply well in the SE/4 of section 23, and the spring to the southwest.

Unusual Problems: The contamination could be from multiple sources.

Status of Project: A total of eight samples were taken in 2014. Four monitoring wells samples were taken in addition to three supply wells and one surface sample from a spring. Chloride data shows the plume continuing to move to the southeast towards the Medicine Lodge River from the Packard #1. Chlorides overall have decreased except at the spring which jumped slightly. The New Stock well showed a dramatic drop in chlorides. It had been at 1500ppm in 2013, and it dropped to 250ppm in 2014.

Level of Remediation Sought:


Ideal: 250 ppm Chloride

Target: 1000 ppm Chloride

Recommendation for Future Work: Monitoring will continue on an annual basis as the area continues to be remediated by natural attenuation. As the groundwater in this area is relatively shallow, several holes may be augured in order to gather more comprehensive data on the size and whereabouts of the chlorides. Depending on the information gathered, additional permanent monitoring wells may need to be installed. Analytical may need to be run on the new south supply well in order to determine if the chlorides are of a natural source, or from oilfield activities.

Estimated Total Costs: \$10,000

Control No.	Staff Hours/Expenditures	Fund Expenditures	
		FY 2014/15	Total
970075-00	7 Hrs. / \$190.91		\$310.09
Current Contaminate Level: 90 ppm CL- 2200 ppm CL-			
Status:			
<input type="checkbox"/> 1. Site Assessment	<input type="checkbox"/> 2. Short Term Monitoring	<input type="checkbox"/> 3. Investigation	
<input checked="" type="checkbox"/> 4. Long Term Monitoring	<input type="checkbox"/> 5. Remediation Plan	<input type="checkbox"/> 6. Installation	
<input type="checkbox"/> 7. Remediation	<input type="checkbox"/> 8. Post Rem. Monitoring	<input type="checkbox"/> 9. Resolved	

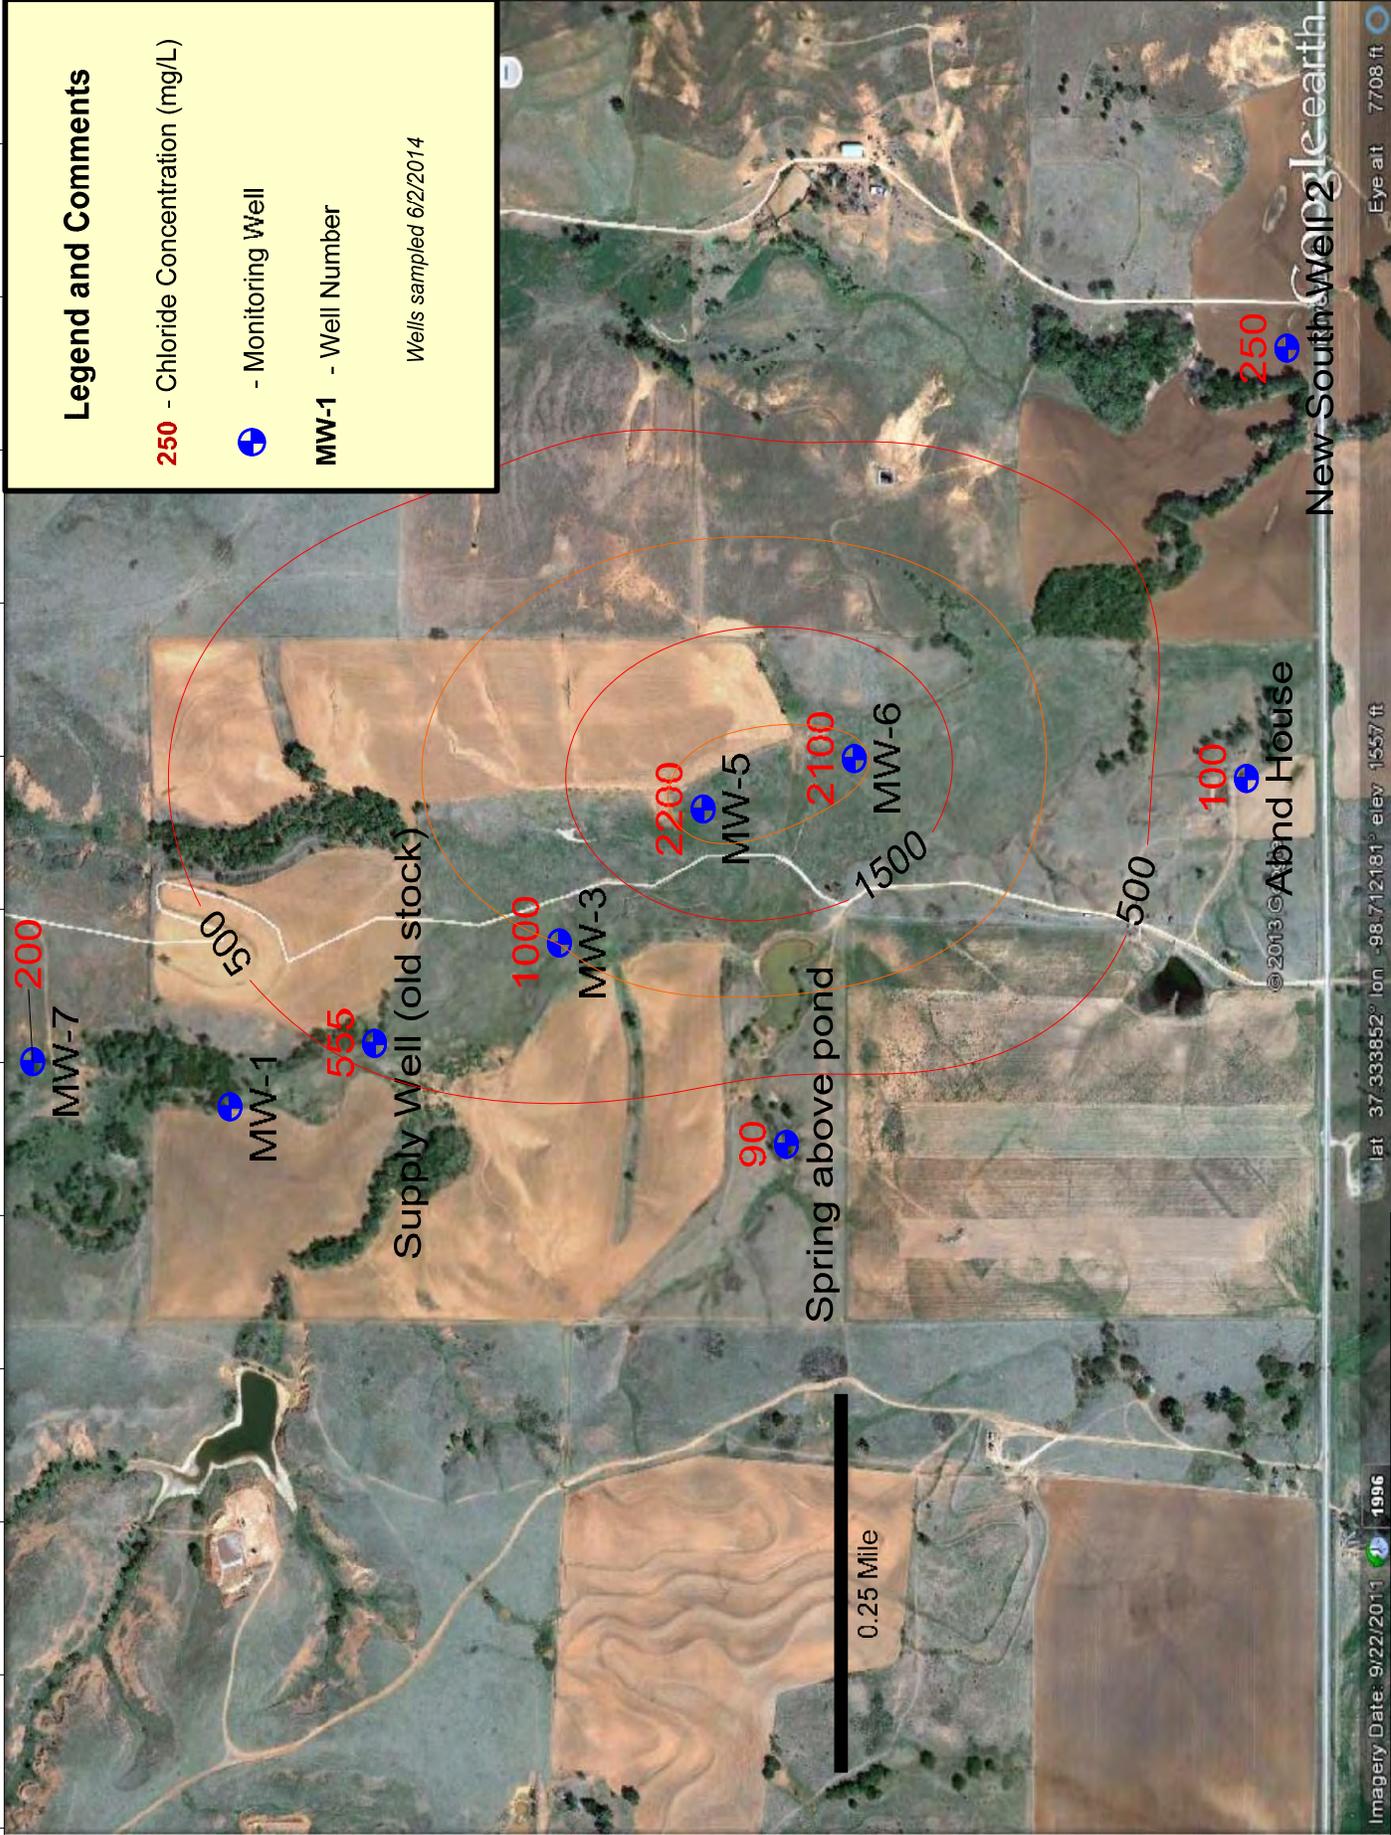

Legend and Comments

250 - Chloride Concentration (mg/L)

Monitoring Well

MW-1 - Well Number

Wells sampled 6/2/2014

Packard Contamination Site

Sections 15/22/23-T31S-R13W

Barber, County Kansas

2013-2014 Area Map with Chlorides

KCC Control # 970075-00 District 1-D. Sellers 6-13-14

Imagery Date: 9/22/2011 1996

lat 37.333852° lon -98.712181° elev 1557 ft

Eye alt 7708 ft



Kansas
Corporation Commission



New South **Well2Leath**

Abnd House

0.25 Mile

Supply Well (old stock)

Spring above pond

MW-7 200

MW-1 555

MW-3 1000

MW-5 2200

MW-6 2100

100

250

500

1500

500

Project: Ruder Creek Contamination Site

Site Location: Sections 17, 20, 28, and 29 of Township 15 South, Range 18 West, Ellis County.

Impact/Immediacy: The Ruder Creek Alluvial Aquifer has been impacted by brine intrusion due to surface ponds, poorly constructed shallow disposal wells in the Cheyenne Sandstone, and numerous leaks. The Immediacy level for this site is rated as moderate.

Site Description: Ruder Creek runs south along US 183 from near Hays to the Smoky Hill River near Schoenchen. North of the site, Ruder Creek is divided into east and west branches, which come together into the main trunk in the northern section of the site. The area is almost exclusively range land with a subtle relief from the uplands to the bottom of the draw. Documented oil field pollution has existed in the drainage since the 1930's, and correspondence made during 1954 states that the west branch was fresh while the east branch and the main trunk of the stream were heavily impacted by brine. Historical aerial photographs show many pits and tank battery locations directly adjacent to the stream and in some cases show salt scarring running from them to the waterway. The sources of pollution in this area have been numerous, and geographically as well as temporally wide spread, preventing the remediation of the overall issue.

Unusual Problems: Proximity to the City of Hays' public water supply well field.

Status of Project: Presently, the chloride concentrations in the monitoring wells range from 925 ppm in the northern end of the site, to 140 ppm in the southern monitoring well near the Smoky Hill River. This north-south gradient has persisted for many years. Appreciable decreases in chloride contamination have not been observed throughout the duration of sampling; however, and it is unknown if the input of additional contaminants has been halted by the closure of surface pits, plugging of flowing wells, and general improvement of lease practices.

Level of Remediation Sought:


Ideal: 250 ppm Chloride

Target: 500 ppm Chloride

Recommendations for Future Work: A conspicuous potential source of pollution has been identified on a historical aerial photograph, and a conductivity survey will be carried out, and combined with additional groundwater sampling locations to help determine if it is an active source of chloride ions. This site will continue to be monitored on an annual basis, and resources will be compiled to identify other possible sources of pollution.

Estimated Total Costs: \$29,000

Control No.	Staff Hours/Expenditures	Fund Expenditures	
		FY 2014/15	Total
970082-00	32 Hrs. / \$782.54		\$12,960
Current Contaminate Level: 140 ppm to 925 ppm Cl			
Status:			
<input type="checkbox"/> 1. Site Assessment	<input type="checkbox"/> 2. Short Term Monitoring	<input checked="" type="checkbox"/> 3. Investigation	
<input checked="" type="checkbox"/> 4. Long Term Monitoring	<input type="checkbox"/> 5. Remediation Plan	<input type="checkbox"/> 6. Installation	
<input type="checkbox"/> 7. Remediation	<input type="checkbox"/> 8. Post Rem. Monitoring	<input type="checkbox"/> 9. Resolved	

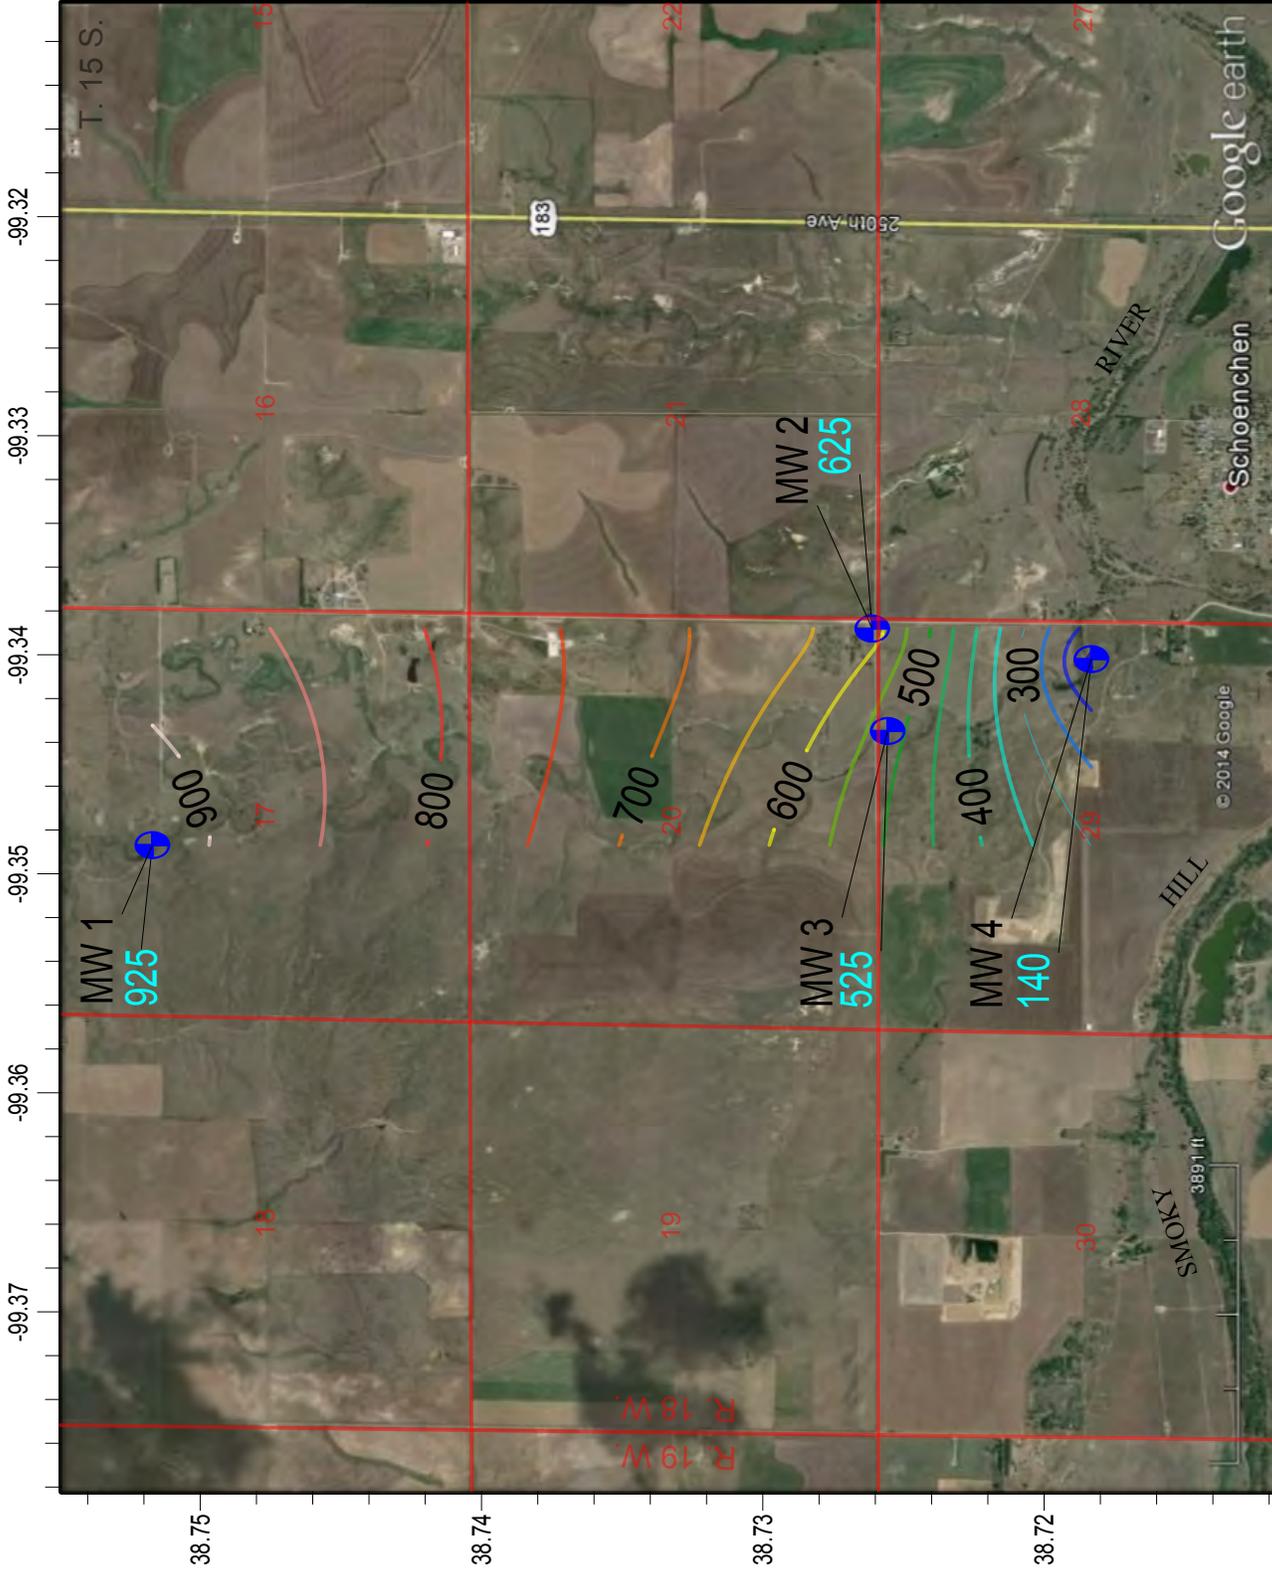


Kansas
 Corporation Commission

Ruder Creek Groundwater Monitoring Site
 Sections 17, 20, and 29 of Township 15 South, Range 18 West, Ellis County, Kansas
 2014 Groundwater Chloride Levels
 District #4 - Sampled 5/22/2014 - Map Drawn on 9/18/2014 by C. Neeley



Project: Running Turkey Creek

Site Location: The area of contaminated surface and ground water is in the Running Turkey drainage pattern and appears to start in the N/2 of 26-19S-2W. This area is within the Ritz Canton oil field, east of Galva, and extends south of Highway 56.

Impact/Immediacy: Oil field impact to the soil can be seen through out the area of the oil fields along the drainage basin. Due to the age of the area oil fields many spills, line leaks and old brine pits has caused damage to soil and water resources. Ground water used for domestic, irrigation and potential public water supplies is the largest and problematic resource affected by the contamination zones. The major source of contamination to the ground water appears to be the past use of evaporation pits. The immediacy rating is moderate to high.

Site Description: The topography of the area is flat to gently rolling hills. Most of the land is under cultivation. The ground water also flows generally in a south to southwest direction with minor hydrologic anomalies. The ground water contamination is highest near the bedrock contact.

Unusual Problems: In order to delineate this site a monitoring well matrix may have to spread for quite a distance. Ritz-Canton Oil Field brine contamination can have multiple sources which will complicate delineation.

Status of the Project: This site is in a monitoring phase, though investigations are warranted in order to delineate the plume. The monitoring wells are sampled using submersible pumps or air-lift technology depending on the depth of the well. Overall the plume within this site has remained stable over 2014.

Level of Remediation Sought:


Ideal: 250 mg/l mg/l

Target: 500 mg/l

Recommendation for Future Works: Continue with the annual monitoring program of the site as the highest chloride wells are still over 20,000 mg/L chlorides. KCC District #2 plans to put together a scope of work which would entail the plugging/repair of certain wells within the site as well as the drilling and installation of no fewer than 5 new monitoring wells in order to delineate the very highly contaminated area in the east-northeast of the plume.

Estimated Total Cost: \$1000 for annual sampling and research. If a new investigation is begun cost will rise as a sizable amount of time and research will be needed to plan the next phase of this site. Installation of more monitoring wells would range from \$20,000 to 30,000.


Control No.	Staff Hours/Expenditures	Fund Expenditures	
		FY 2014/15	Total
20010033-001	20.5 Hrs. / \$547.91		\$61,603.07
Current Contaminate Level: 30 mg/l Cl⁻ MW 2001 to 22,000mg/l Cl⁻ MW202 (Aquifer)			
Status:			
<input type="checkbox"/> 1. Site Assessment	<input type="checkbox"/> 2. Short Term Monitoring	<input checked="" type="checkbox"/> 3. Investigation	
<input checked="" type="checkbox"/> 4. Long Term Monitoring	<input type="checkbox"/> 5. Remediation Plan	<input type="checkbox"/> 6. Installation	
<input type="checkbox"/> 7. Remediation	<input type="checkbox"/> 8. Post Rem. Monitoring	<input type="checkbox"/> 9. Resolved	

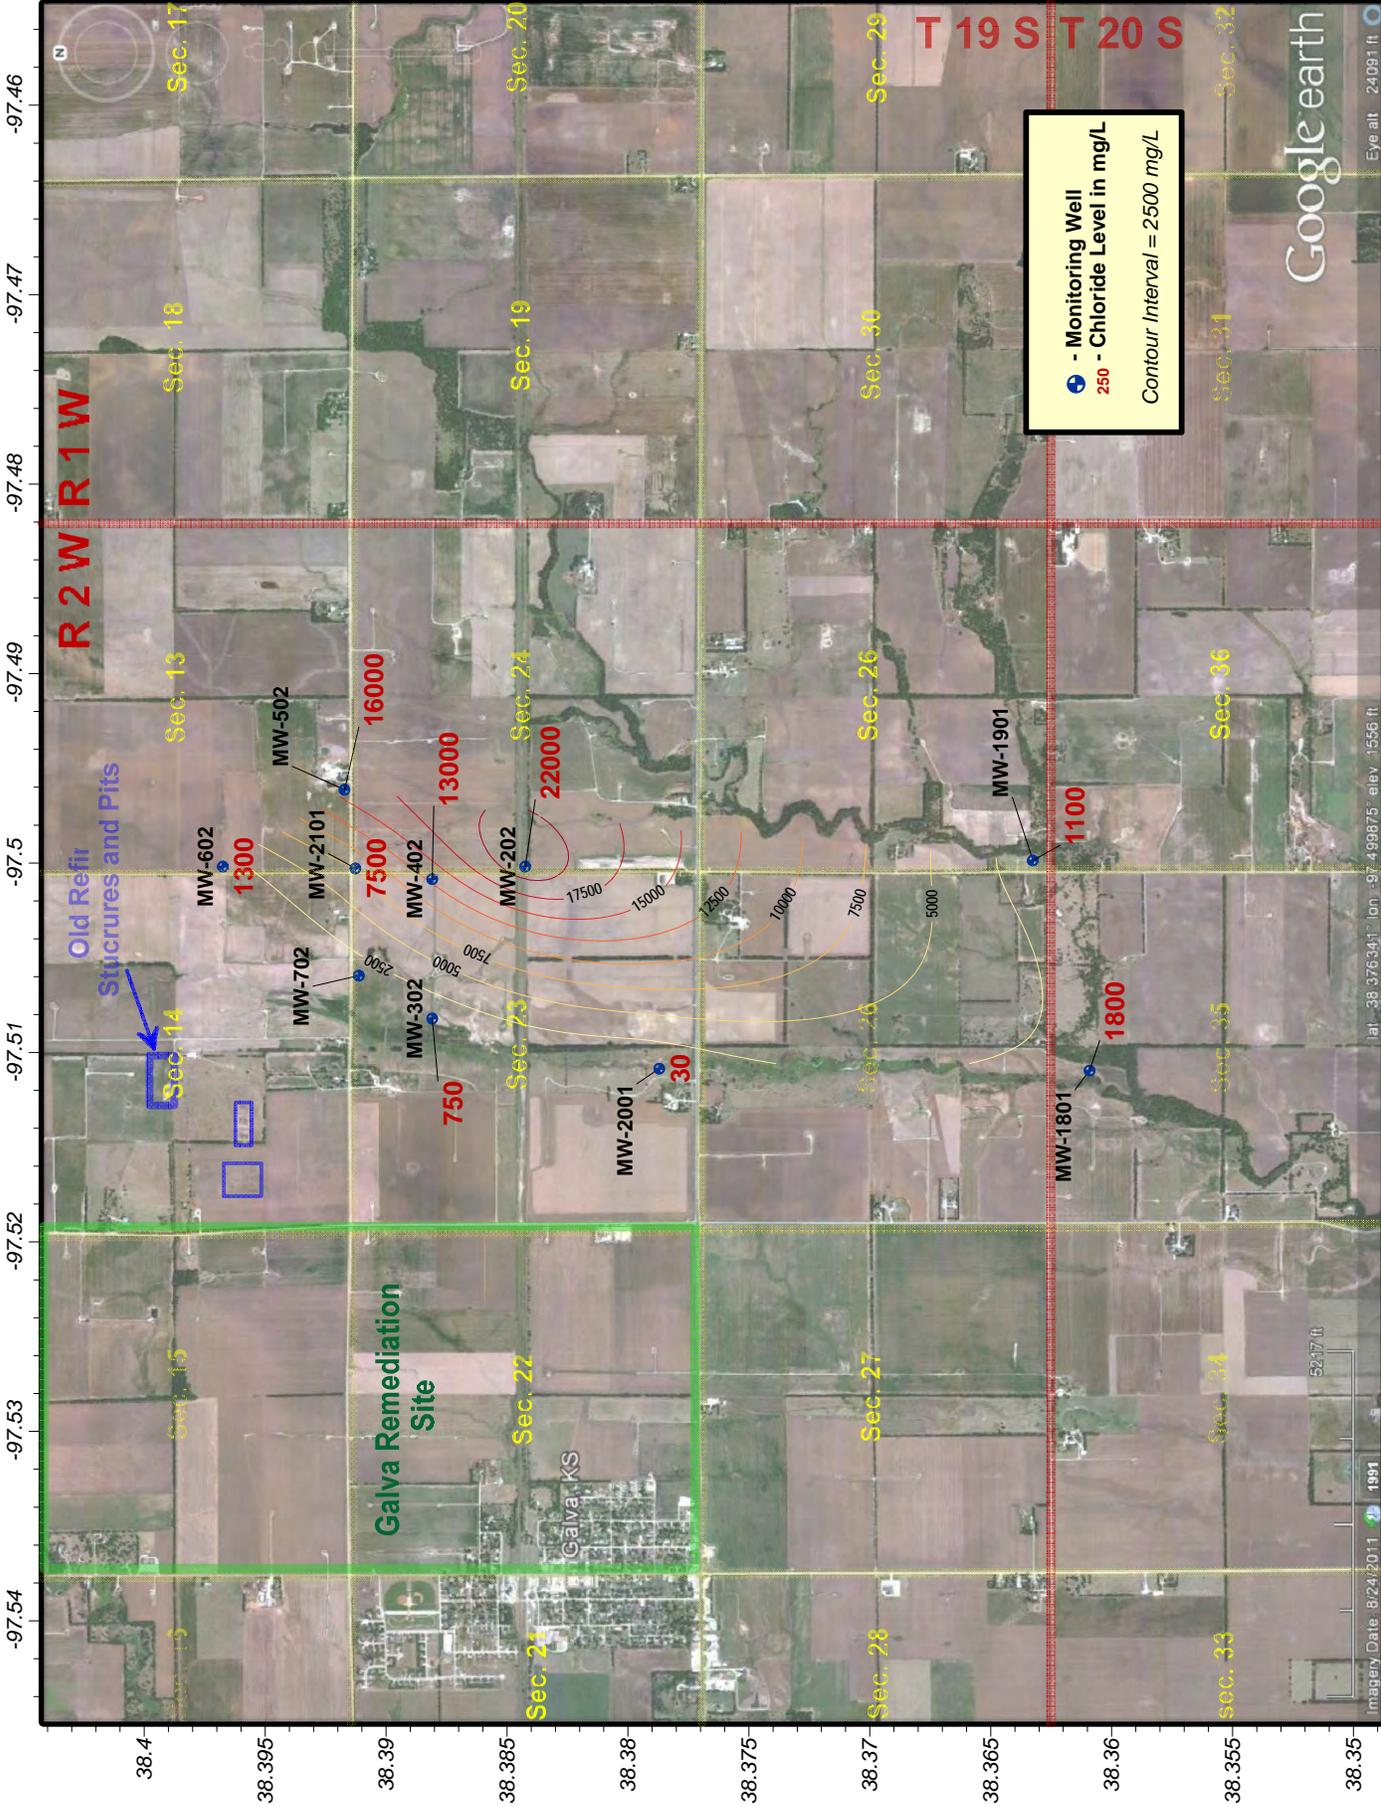



N


Northern Running Turkey Creek Contamination and Monitoring Site - KCC Control #20030059-001
 Multiple sections in Township 19 & 20 South and Range 2 West, McPherson County, Kansas
2014 Groundwater Chloride Levels
 District #2 - Sampled 10/9/2014 - Map Drawn on 1/20/2014 by D.Bollenback

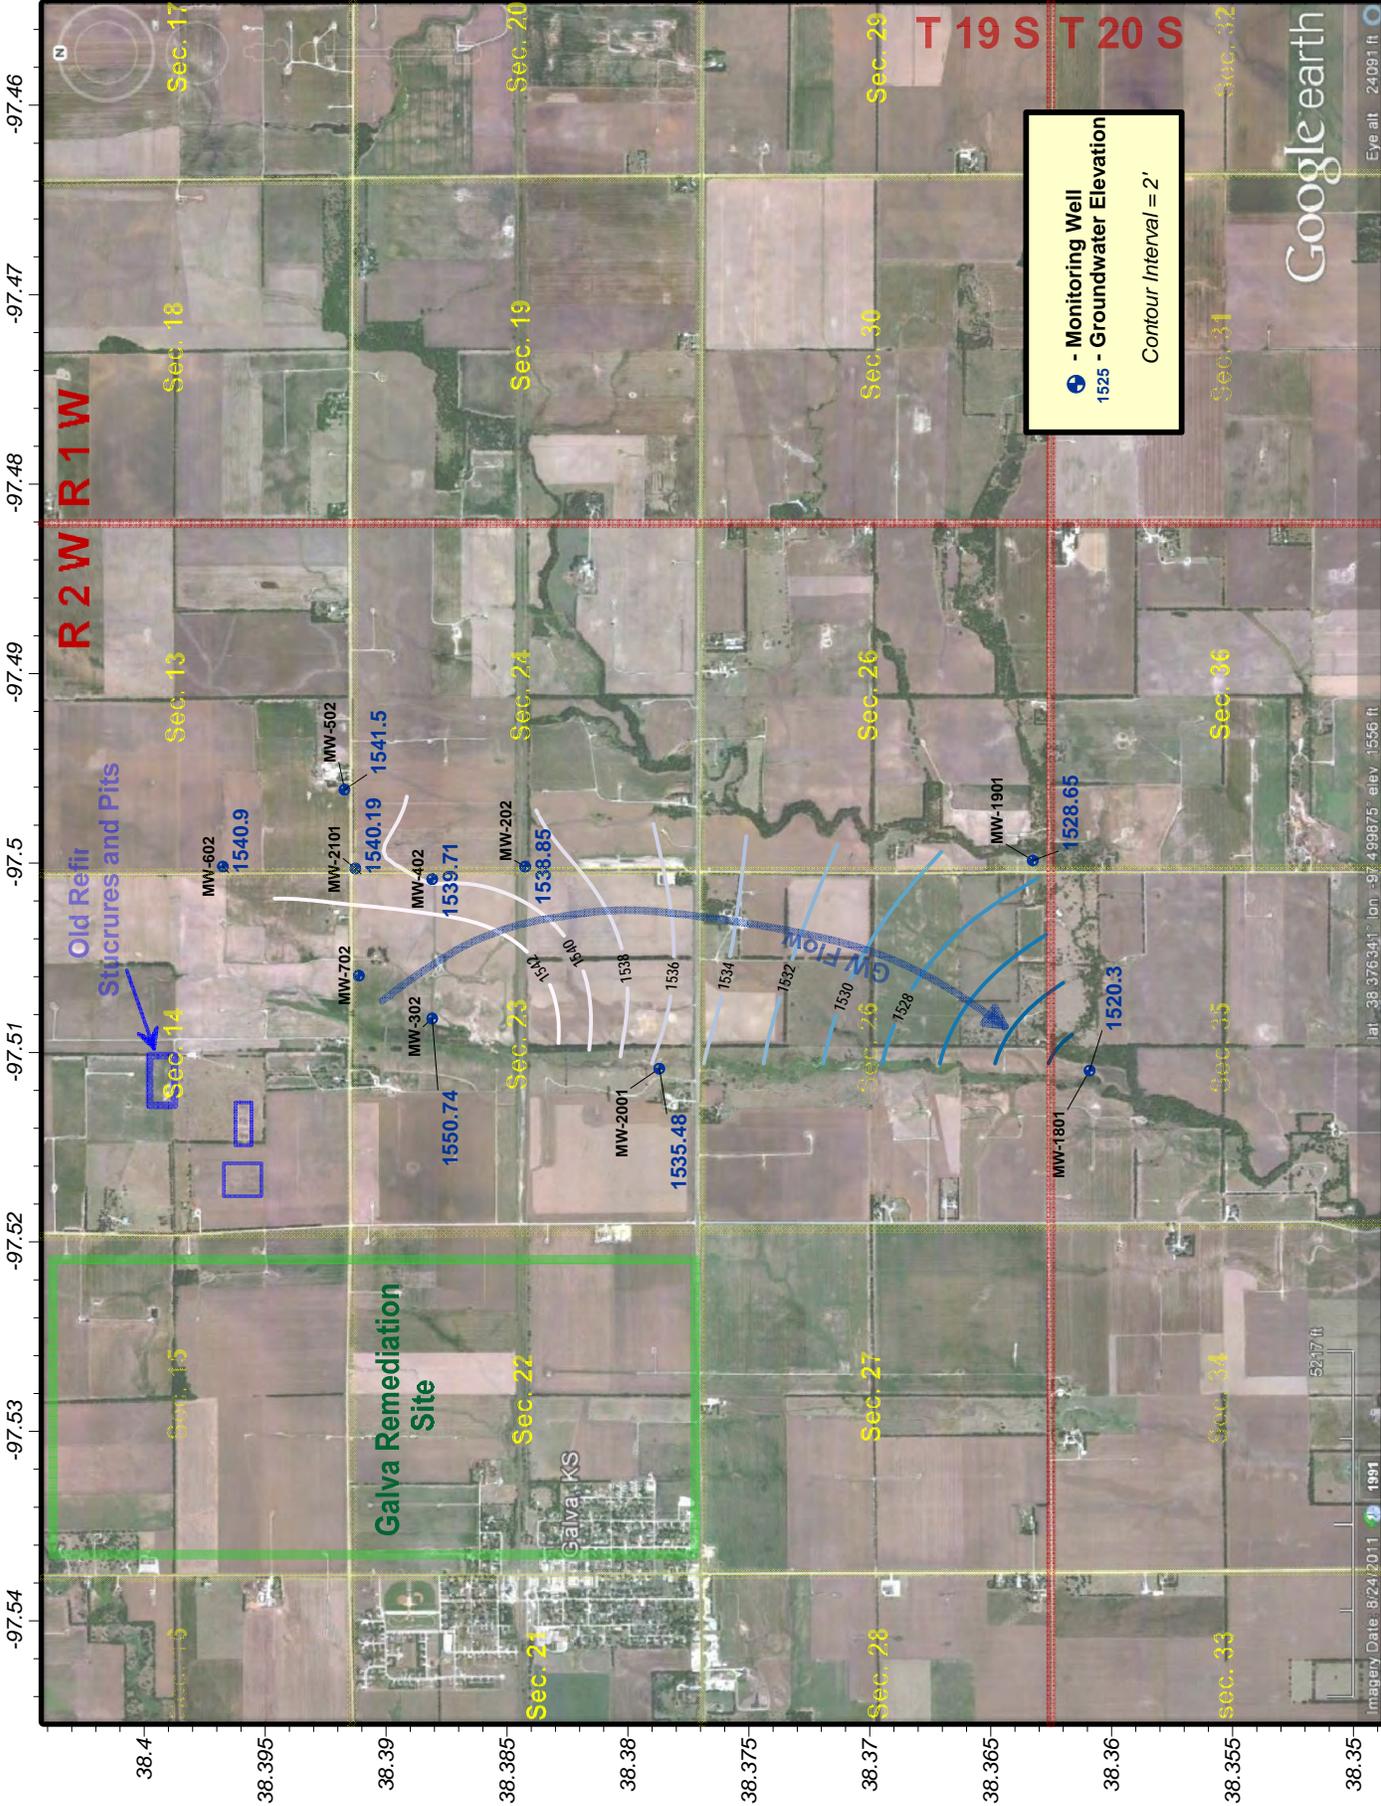

Google earth
 Eye alt: 24091 ft

Northern Running Turkey Creek Contamination and Monitoring Site - KCC Control #20030059-001
 Multiple sections in Township 19 & 20 South and Range 2 West, McPherson County, Kansas
2012 Groundwater Elevation Map
 District #2 - Levels gauged 10/9/2014 - Map Drawn on 11/20/2014 by D.Bollenback



Imagery Date: 8/24/2011 1991
 52.17 ft

Project: City of Russell Contamination Site

Site Location: Within and around the City of Russell, in Parts of Township 13 South, Range 14 West and Township 14 S, Range 14 W, Russell County.

Impact/Immediacy: Brine contamination of a shallow aquifer utilized for domestic purposes such as irrigation of lawns. Immediacy level is rated as low.

Site Description: Potential sources include the approximately 334 wells drilled either in the city limits or in close proximity to the city limits. The associated drill pits, lead lines, tank battery sites, brine tanks, brine lines, disposal and injection wells, and emergency pits have all contributed to the brine contamination. In addition, there are 36 oil wells and brine disposal wells within this site that are either abandoned or have little or no documentation to confirm that they have been plugged. Test holes were drilled in the area during the summer of 2001 in an effort to delineate the source of the contamination. Data collected through the test holes, and other research indicated that the major contributor of chloride ions may be a former brine pit located to the northwest of the city. However, there has been extensive oil and gas development in the same vicinity, and the contribution from old drill pits and old line leaks cannot be determined.

Unusual Problems: The investigation of all potential contamination sources would be costly and not without challenges. If remediation is initiated, the Disposal of contaminated water would incur severe costs, and logistical problems.

Status of Project: In September of 2004, the monitor well tested at 2,200 ppm chloride. No samples were taken between 2004 and 2014, due to the well being inaccessible. In 2014, access to the well was gained, and the chloride concentration was 1,250 ppm. The continual pumping of the water wells in the area for lawn irrigation may contribute to the decline in the level of chloride concentration.

Level of Remediation Sought:


Ideal: 500 ppm Chloride

Target: 1000 ppm Chloride

Recommendations for Future Work: Further research may be needed to determine whether remediation is feasible, and what action should be taken. Additional samples will be collected in 2015 to determine the configuration of the brine plume, and if the chloride concentration in our monitoring well is characteristic for the entire area.

Estimated Total Costs: \$400,000.

Control No.	Staff Hours/Expenditures	Fund Expenditures	
		FY 2014/15	Total
970083-00	22 Hrs. / \$543.40		\$1,192.60
Current Contaminate Level: 1,250 ppm Cl			
Status:			
<input type="checkbox"/> 1. Site Assessment	<input type="checkbox"/> 2. Short Term Monitoring	<input type="checkbox"/> 3. Investigation	
<input checked="" type="checkbox"/> 4. Long Term Monitoring	<input checked="" type="checkbox"/> 5. Remediation Plan	<input type="checkbox"/> 6. Installation	
<input type="checkbox"/> 7. Remediation	<input type="checkbox"/> 8. Post Rem. Monitoring	<input type="checkbox"/> 9. Resolved	

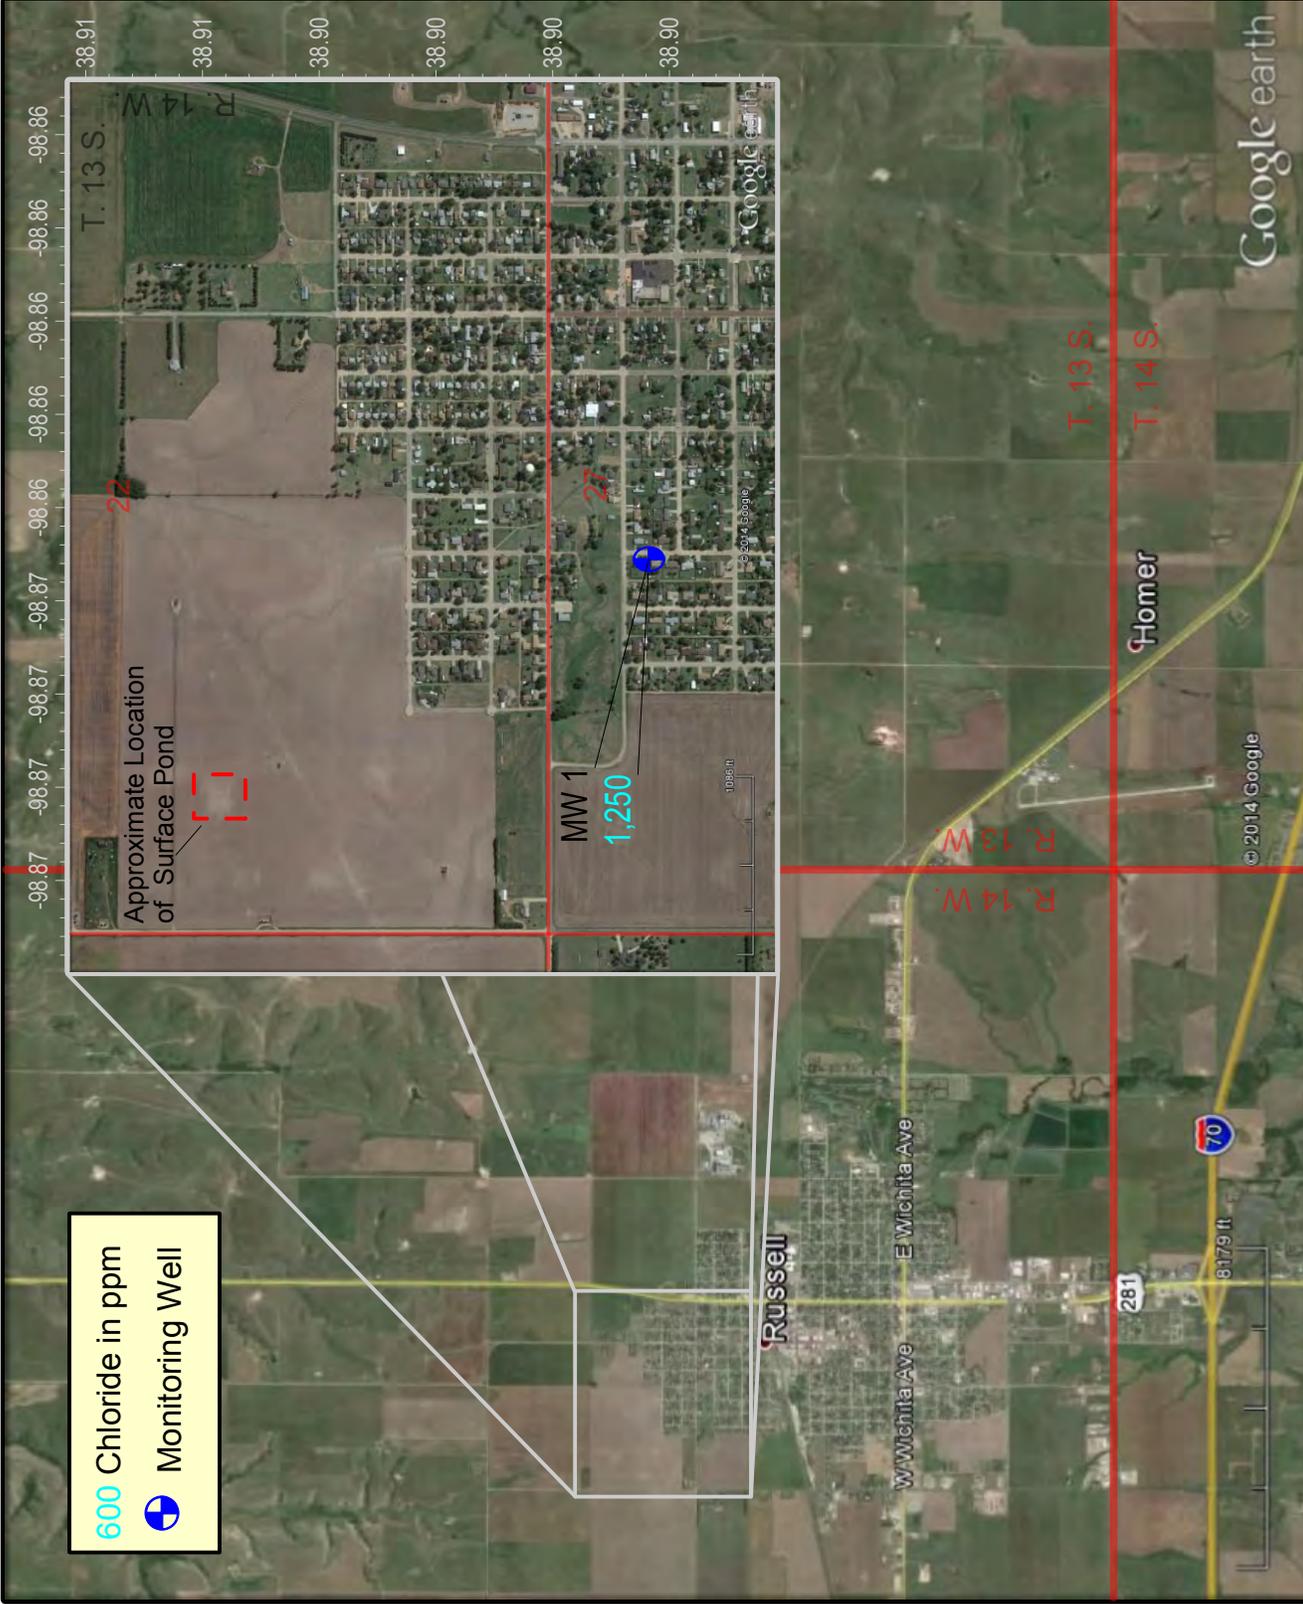



City of Russell Groundwater Monitoring Site
 E Sections 22 and 27, Township 13 South, Range 14 West, Russell County, Kansas
 2014 Groundwater Chloride Levels
 District #4 - Sampled 6/11/2014 - Map Drawn on 9/19/2014 by C. Neeley

Project: Russell Rural Water District #1

Site Location: Section 34 and 35, Township 14 South, Range 14 West, Russell County.

Impact/Immediacy: A public water supply well is producing water with elevated chloride content. The immediacy level is rated as low to moderate.

Site Description: The hydrology of the area is complicated through the interaction of a shallow drainage mantled with alluvium, the Smoky Hill aquifer, and the Dakota Sandstone aquifer. The public water supply well was drilled to the north of the river, likely in hopes of utilizing the alluvium. However, the well is sufficiently deep to be drawing water directly from either the Smoky Hill aquifer, or the Dakota. Additionally, the geology of the area does not provide a seal between the otherwise fresh shallow aquifers and the Dakota aquifer. Although the area has undergone significant oil and gas development, no active sources for pollution have been definitively identified. Furthermore, the Dakota Sandstone was an early disposal formation in the area. As such, any oil field brines found in this aquifer are of a non-point source origin.

Unusual Problems: Research conducted by the Kansas Geological Survey in 1991 and 1992 showed that the chloride content of the Smoky Hill River in the vicinity of this site ranged from 843 ppm to 1,879 ppm, with oil field brines contributing 11% to 29% of the total concentration. The major natural chloride source is the dissolution of halite in Permian strata, which migrates into and through the Dakota Sandstone into the alluvium and river itself. Because of the non-point source origin of the oil field brines, and the natural input of saline water, and the probability that the public supply well is drawing this water, remediation of this site would not be plausible.

Status of Project: Over the previous 4 years, the chloride concentrations of the monitoring wells have remained steadily between 500 ppm and 900 ppm. Presently, the wells contain chloride concentrations of 650 ppm in MW 1, and 750 ppm in MW 3 and MW 5.

Level of Remediation Sought:


Ideal: 100 ppm Chloride

Target: 250 ppm Chloride

Recommendations for Future Work: This site should be monitored on an annual basis. However, realistic goals for the usage of this public water supply, and the level of expected contamination should be developed through close coordination with the rural water district.

Estimated Total Costs: The estimated costs to KCC and KDHE for extensive studies in the past have been \$30,000 or greater. Continued monitoring costs will be \$3,000.00.

Control No.	Staff Hours/Expenditures	Fund Expenditures	
		FY 2014/15	Total
970084-00	19 Hrs. / \$464.30		
Current Contaminate Level: 650 ppm to 750 ppm Cl			
Status:			
<input type="checkbox"/> 1. Site Assessment	<input type="checkbox"/> 2. Short Term Monitoring	<input type="checkbox"/> 3. Investigation	
<input checked="" type="checkbox"/> 4. Long Term Monitoring	<input type="checkbox"/> 5. Remediation Plan	<input type="checkbox"/> 6. Installation	
<input type="checkbox"/> 7. Remediation	<input type="checkbox"/> 8. Post Rem. Monitoring	<input type="checkbox"/> 9. Resolved	

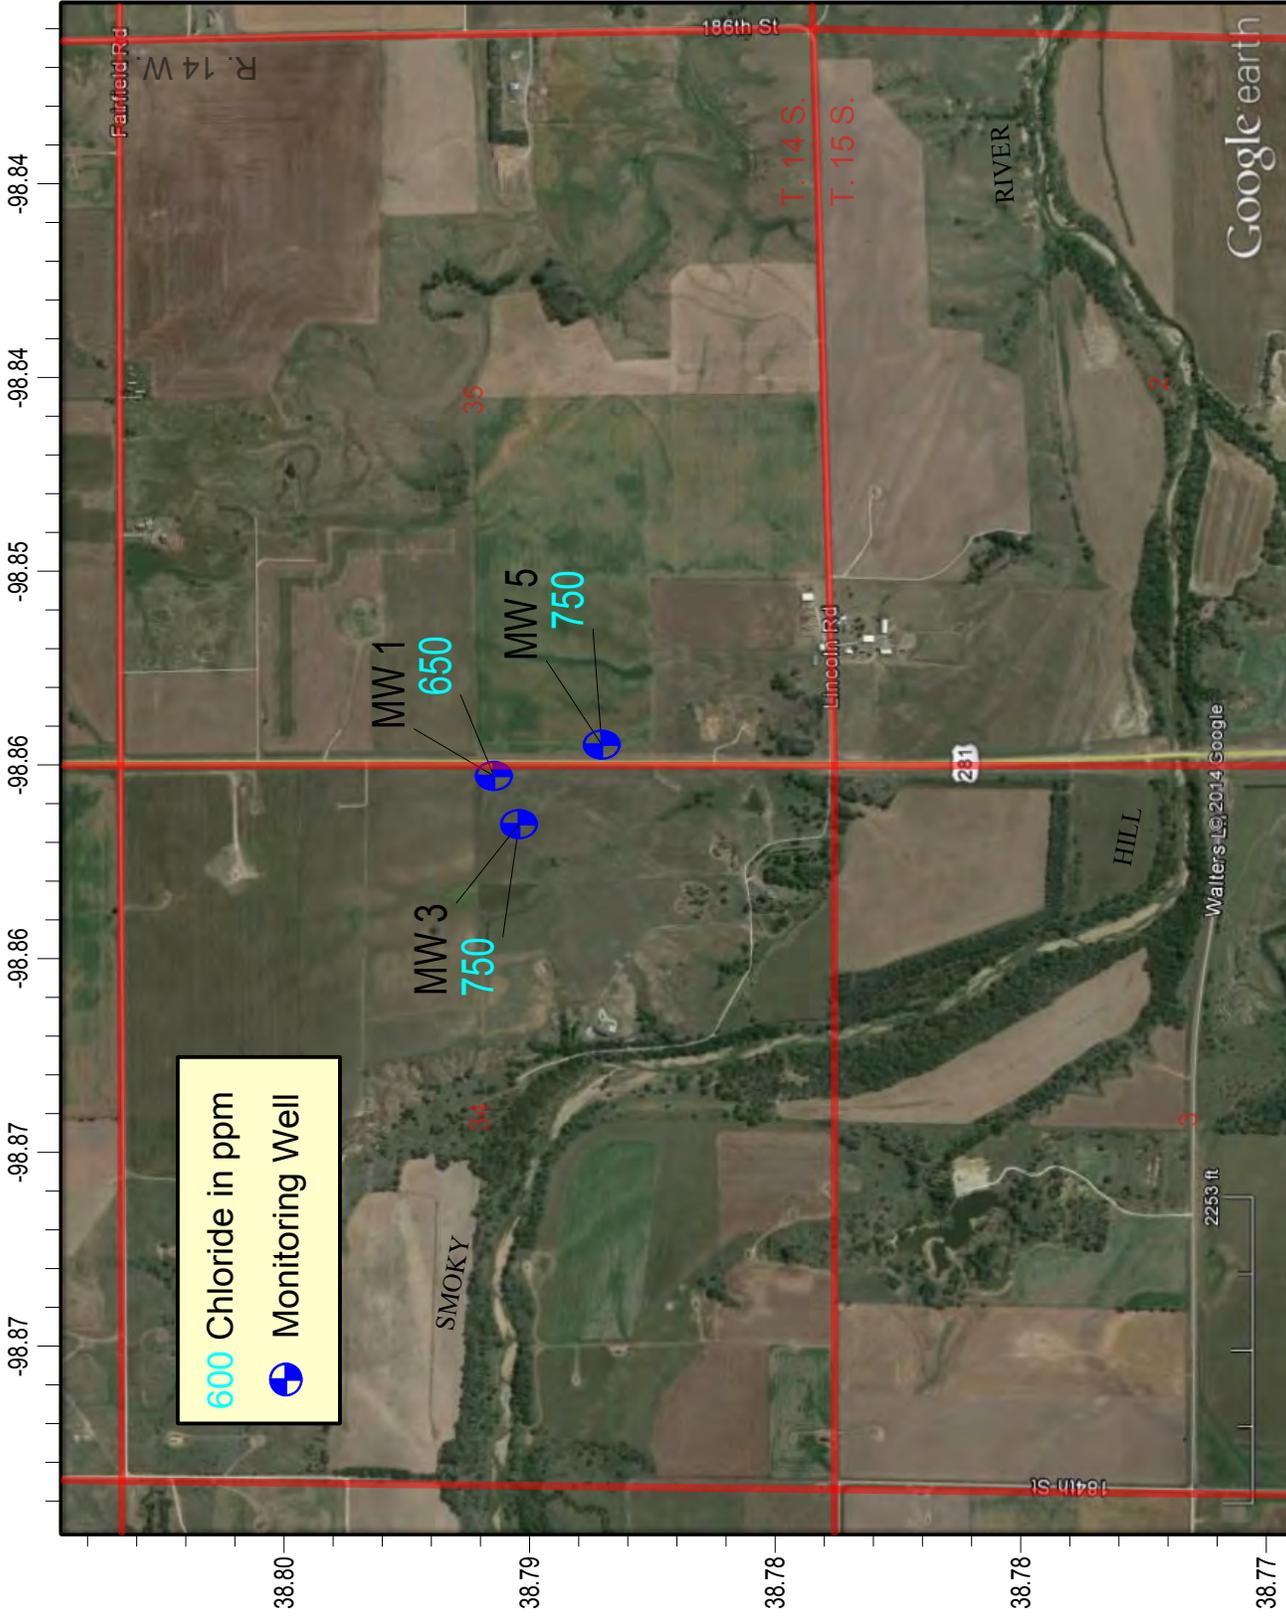



Russell Rural Water District #1 Groundwater Monitoring Site
 Sections 34 and 35, Township 14 South, Range 14 West, Russell County, Kansas
 2014 Groundwater Chloride Levels
 District #4 - Sampled 4/10/2014 - Map Drawn on 9/19/2014 by C. Neeley



Project: Sample Contamination Site

Site Location: The contamination area is located one mile north of Wichita, adjacent to the intersection of 45th Street North and Rock Road. The legal location is the NW of the NW of Section 29 Township 26 South Range 2 East, Sedgwick County.

Impact/Immediacy: KCC District #2 has lowered this site from medium immediacy level to low. The chloride intrusion affects a groundwater aquifer that is very low volume. Housing development in the area could see rise in water well installation for domestic and heating/cooling systems.

Site Description: The site is located on the outskirts of a metropolitan housing development, but is being encroached on from all sides. The topsoil is hard clay (Wellington formation). The underlying aquifer is a thin low volume zone that is directly affected by precipitation. Total depth of the monitor well is nineteen feet.

Unusual problems: A portion of the chlorides is natural and could not readily be remediated. The aquifer is low volume and difficult to clean up. The urban setting logistically makes remediation difficult. Continued residential development could see increased attempts of use of the groundwater in the area.

Status of Project: A water sample was collected in April of 2014 tested 3,600 mg/L chlorides. The chlorides have increased from 2,500 mg/L in 2013. The change in chlorides could be from multiple factors including less rainwater this year and lower water levels than in previous years.

Level of Remediation Sought:

Ideal: 250 mg/l Chloride

Target: 500 mg/l Chloride


Recommendations for Future Work: Continue to monitor site. Site is located only one mile north of the District #2 Field Office so limited resources are needed to continue monitoring this site. Remediation of this site could be started by pumping fluid from the monitoring well to the oil field salt-water tank located on site. Research and investigate any new domestic wells in the area for contamination and begin sampling domestic wells in the area for annual report.

Estimated Total Costs: \$300 per year for site inspection, sample collection, and research.

Control No.	Staff Hours/Expenditures	Fund Expenditures	
		FY 2014/15	Total
970088-00	9 Hrs. / \$230.82		
Current Contaminate Level: 3,600 mg/l Cl-			
Status:			
<input type="checkbox"/> 1. Site Assessment	<input type="checkbox"/> 2. Short Term Monitoring	<input type="checkbox"/> 3. Investigation	
<input checked="" type="checkbox"/> 4. Long Term Monitoring	<input type="checkbox"/> 5. Remediation Plan	<input type="checkbox"/> 6. Installation	
<input type="checkbox"/> 7. Remediation	<input type="checkbox"/> 8. Post Rem. Monitoring	<input type="checkbox"/> 9. Resolved	



Comments	
40	Chlorides ppm
+	Monitoring Well

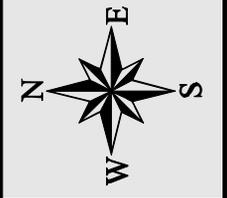

Sample 'A' Contamination Site
 NW - Sec. 29 - T 26 S - R 2 E, Sedgwick County, Kansas
2014-2015 Area Map with Chlorides
 KCC Project Code #970088-00 - District #2 - B. Milner - 4/15/14



-97.258 -97.256 -97.254 -97.252 -97.25 -97.248 -97.246 -97.244 -97.242 -97.24 -97.238 -97.236 -97.234 -97.232 -97.23 -97.228

37.776 37.774 37.772 37.77 37.768 37.766 37.764

Project: *Louis Sander Contamination Site*

Site Location: NW/4 of Section 03, Township 14 South, Range 15 West, Russell County.

Impact/Immediacy: A shallow aquifer and small drainage have been impacted by poor oil field practices. A stock well pumped by a windmill or hand pump served as the monitoring well. The immediacy level for this site is rated as low.

Site Description: The site is situated near the head of a small, intermittent tributary to Big Creek. The soils are Harney and Roxbury silt loam, and the area is divided equally between pasture along the creek, and cultivation in the higher portions of the location. Near-surface geological information is limited to data obtained through a few water well records covering many square miles; however, a reasonable hypothesis would be to expect topsoil to a depth of approximately six feet, atop a sand about ten feet thick. Shale bed rock is likely to be encountered at a depth of 15 to 20 feet below the surface, and a common depth for the area water wells is roughly 30 feet. The site is located within the Gorham oil field, which was discovered in 1926. Multiple water flood projects have been implemented in the field, and several injection wells have been drilled in the area. Past oil field including abused surface pits, have had a negative effect on the environmental health of the site.

Unusual Problems: None

Status of Project: Chloride levels were at 1,650 ppm in the stock well when it was tested in October 2005. Chloride concentrations dropped to 1,500 ppm in 2007 and again to 1,250 ppm in 2008. Samples were not collected between 2008 and 2014, due to the pump on the well being in disrepair, and incapable of lifting a sample. The well appears to be once again usable; however, staff did not attempt to operate it due to concerns associated with using unfamiliar privately owned equipment. The sample gathered in 2014 was obtained from a domestic water well to the north in Sec. 34, T. 13 S., R. 15 W. the sample from this well was tested and contained 300 ppm chloride.

Level of Remediation Sought:


Ideal: 500 ppm Chloride

Target: 1000 ppm Chloride

Recommendations for Future Work: In addition to yearly sampling, groundwater sampling along the drainage will take place in order to confirm the pollutant concentration in the area. If the chloride concentration in the well to the north of the site is representative of the remainder of the site, closure will be recommended in the near term.

Estimated Total Costs: \$300.00


Control No.	Staff Hours/Expenditures	Fund Expenditures	
		FY 2014/15	Total
970089-00	15 Hrs. / \$372.04		
Current Contaminate Level: Unknown			
Status:			
<input type="checkbox"/> 1. Site Assessment	<input type="checkbox"/> 2. Short Term Monitoring	<input type="checkbox"/> 3. Investigation	
<input checked="" type="checkbox"/> 4. Long Term Monitoring	<input type="checkbox"/> 5. Remediation Plan	<input type="checkbox"/> 6. Installation	
<input type="checkbox"/> 7. Remediation	<input type="checkbox"/> 8. Post Rem. Monitoring	<input type="checkbox"/> 9. Resolved	

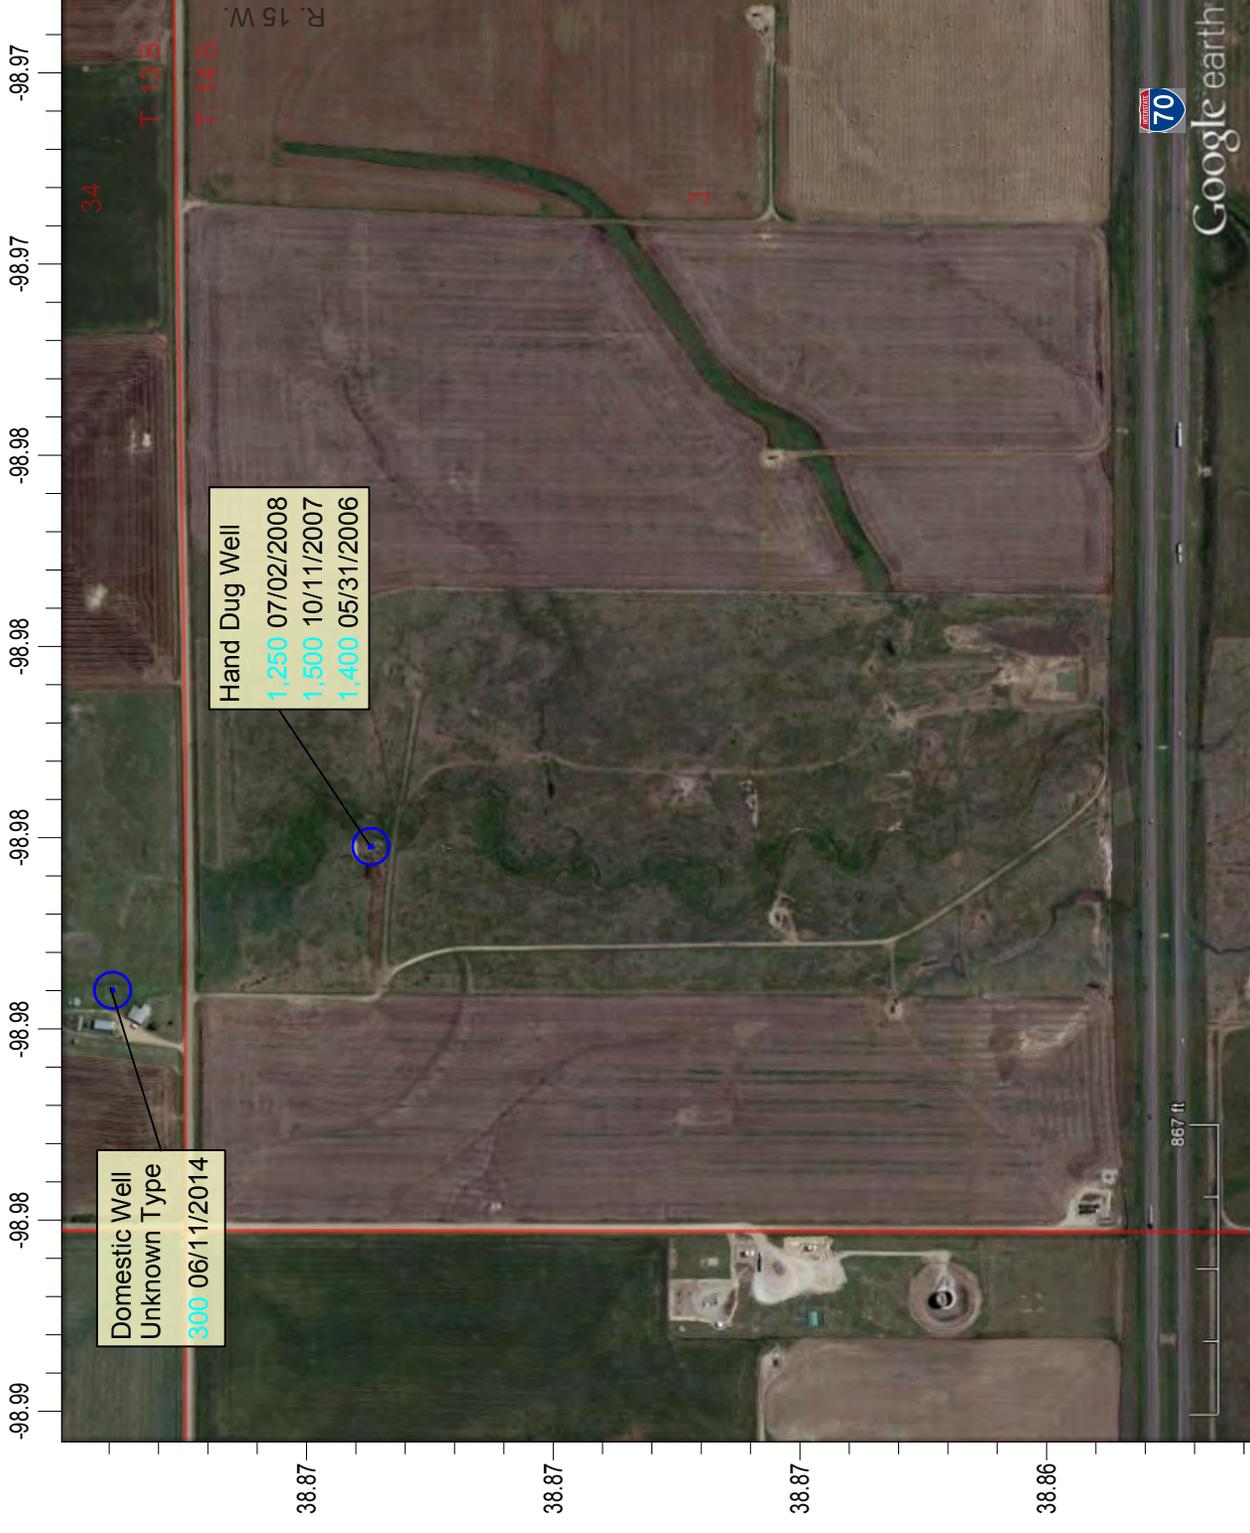

600 Chloride in ppm
 Domestic Well

Domestic Well
 Unknown Type
 300 06/11/2014

Hand Dug Well
 1,250 07/02/2008
 1,500 10/11/2007
 1,400 05/31/2006

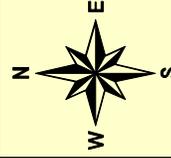

Louis Sander Groundwater Monitoring Site
 Section 3, Township 14 South, Range 15 West, Russell County, Kansas
 2014 Groundwater Chloride Levels
 District #4 - Sampled on 6/11/2014
 Map Drawn on 11/13/2014 by C. Neeley



Google earth

Project: *Schraeder Contamination Site*

Site Location: Legal location is E/2 of Section 3 and W/2 of Section 2, Township 24 South, Range 24 West, Hodgeman County.

Impact/Immediacy: Contamination to groundwater, stock wells and possibly an irrigation well in the future. Immediacy level is rated as low.

Site Description: The chloride concentration of the Ogallala formation water supplying a stock well has been high in chlorides.

Unusual Problems: None.

Status of Project: Eight groundwater samples were taken in 2014. Chlorides in these samples ranged from 40ppm chlorides at a new windmill, to 1760ppm chlorides in Well C. These values have increased slightly from the 2013 samples. There has been a slow decline in the chlorides at this site due to natural attenuation; this trend is expected to continue in the future. Irrigation well B and Irrigation well J were unable to be sampled due to the electricity not being hooked up. Windmill F is damaged and not capable of pumping so no sample was taken. Windmill D, at the landowner's residence, was running and was sampled this year.

Level of Remediation Sought:

Ideal: 250 ppm Chloride

Target: 350 ppm Chloride

Recommendations for Future Work: The landowner for Windmill F should be contacted to see if repairs are going to be made. If not, the idea of pulling the rods should be explored so the KCC can resume sampling this well. After talking with Mr. Schraeder, we should make sure to keep him advised on all activities, and formally send him a letter advising him of how all the wells on his land tested.

Estimated Total Costs: \$30,000.00.

Control No.	Staff Hours/Expenditures	Fund Expenditures	
		FY 2014/15	Total
970013-00	7 Hrs. / \$190.91		\$1,590.90
Current Contaminate Level: 40 ppm Cl- to 1760 ppm Cl-			
Status:			
<input type="checkbox"/> 1. Site Assessment	<input type="checkbox"/> 2. Short Term Monitoring	<input type="checkbox"/> 3. Investigation	
<input checked="" type="checkbox"/> 4. Long Term Monitoring	<input type="checkbox"/> 5. Remediation Plan	<input type="checkbox"/> 6. Installation	
<input type="checkbox"/> 7. Remediation	<input type="checkbox"/> 8. Post Rem. Monitoring	<input type="checkbox"/> 9. Resolved	


Legend and Comments

250 - Chloride Concentration (mg/L)

 - Monitoring Well


MW-1 - Well Number

Wells sampled 6/4/2014

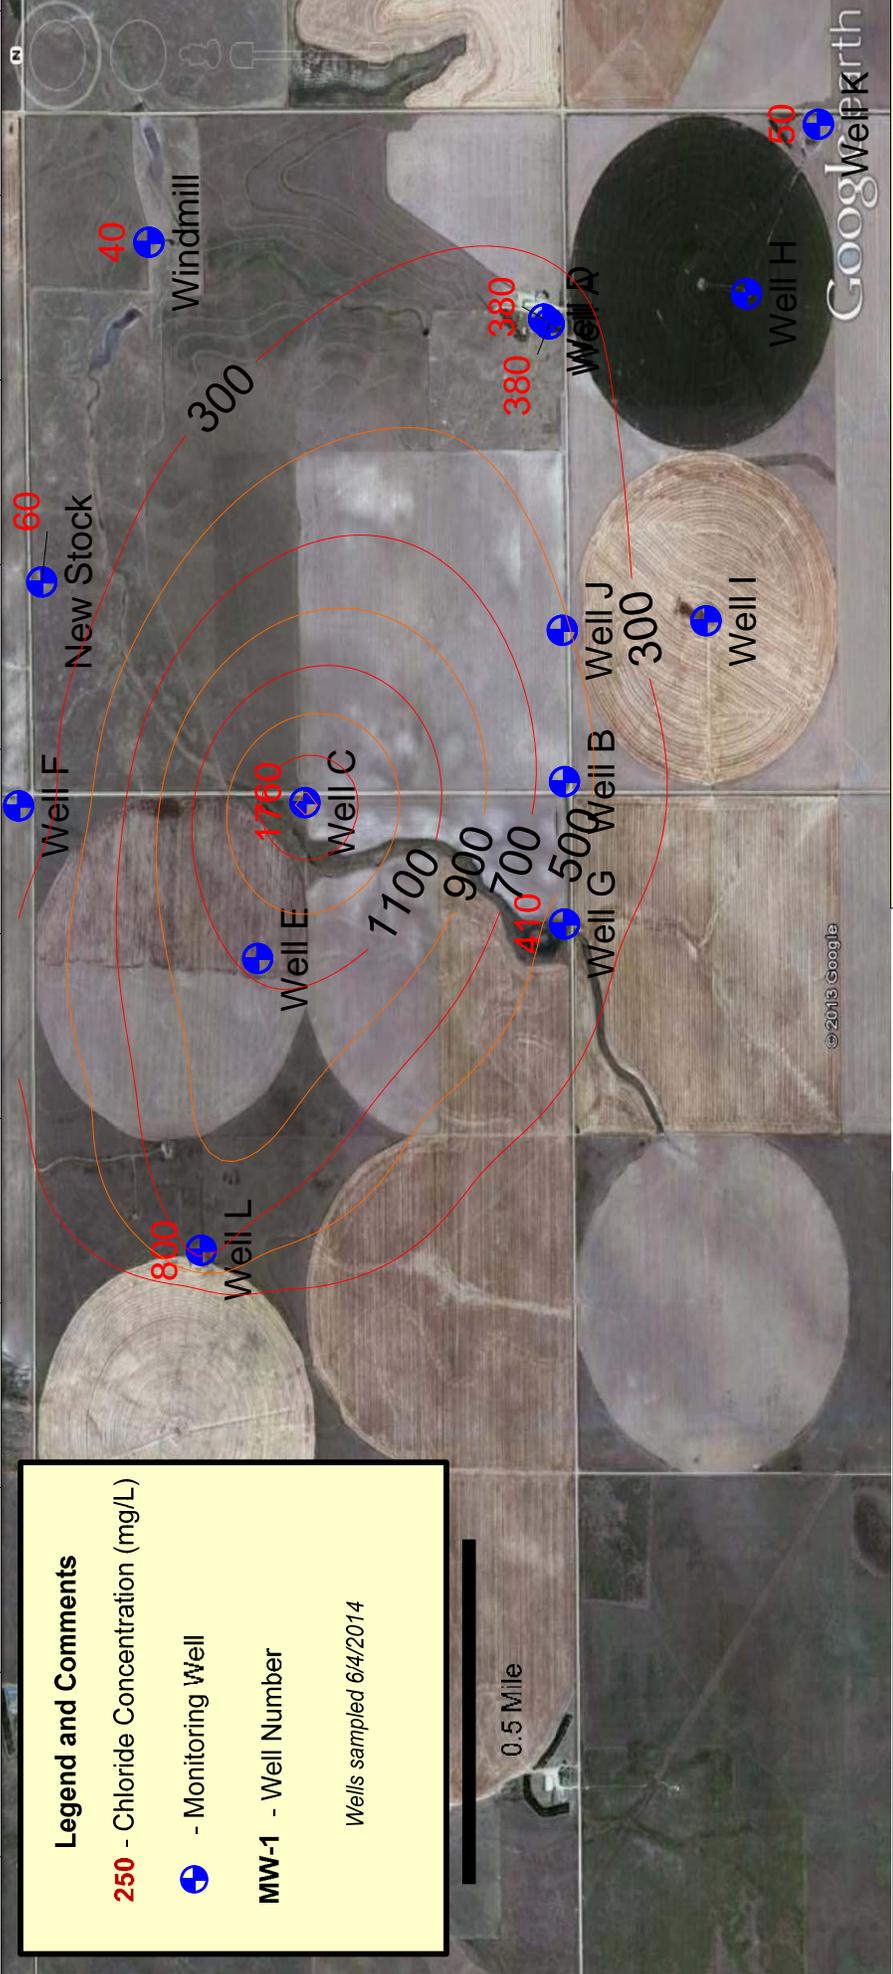

Schraeder Site
 Sections 2/3/11-T-24S-R24W
 Hodgeman County, Kansas

2013-2014 Area Map with Chlorides
 KCC Control # 970013-00 District 1
 D. Sellers 6/12/14

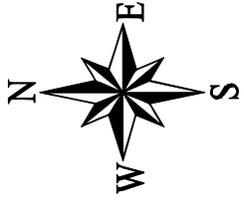


Project: *Leo Schruben-Rogers Contamination Site*

Site Location: SE/4 of Section 18, Township 7 South, Range. 17 West, Rooks County.

Impact/Immediacy: Groundwater contained in an alluvial aquifer has been impacted by oil field brine. The Immediacy for this site is rated as low.

Site Description: This site is located on the eastern edge of the city of Stockton, approximately one third of a mile from the South Fork Solomon River. The water wells in the area are used for domestic and stock purposes, and draw water from an alluvial terrace. The soil in the area of the impacted wells is rapidly permeated by contaminants, making the water quality sensitive to lease practices. Extensive past studies failed to identify a primary source for chloride ions, but a number of potential causes of the pollution were noted. These potential sources are generalized as oil field practices rather than delineated definitively, and contribute to an accumulative effect, which was confirmed by the research and water quality data. However, remediation was not initiated because a significant reduction in the chloride in the area wells was observed, and the utilization of other methods for obtaining water, i.e. municipal sources and reverse osmosis treatments.

Unusual Problems: None.

Status of Project: Several potential sources of pollution in the area have been removed over the last several years. The well on the Rogers' property has fallen appreciably since 1986, when the chloride concentration was 8,450 ppm, and has remained relatively stable in the range of 500 ppm to 750 ppm since 2008. In 2014, the chloride concentration was determined to be 625 ppm, which is on trend with the past seven years.

Level of Remediation Sought:

Ideal: 100 ppm Chloride

Target: 250 ppm Chloride

Recommendations for Future Work: This site will be monitored annually to determine if the removal of potential sources has contributed to the reduction in contaminant levels. If additional work is warranted due to a rise in contaminant levels, additional geophysical and field research may be conducted in an effort to better delineate a source.

Estimated Total Costs: \$2000.


Control No.	Staff Hours/Expenditures	Fund Expenditures	
		FY 2014/15	Total
970014-00	18 Hrs. / \$445.48		
Current Contaminate Level: 625 ppm Cl⁻			
Status:			
<input type="checkbox"/> 1. Site Assessment	<input type="checkbox"/> 2. Short Term Monitoring	<input type="checkbox"/> 3. Investigation	
<input checked="" type="checkbox"/> 4. Long Term Monitoring	<input type="checkbox"/> 5. Remediation Plan	<input type="checkbox"/> 6. Installation	
<input type="checkbox"/> 7. Remediation	<input type="checkbox"/> 8. Post Rem. Monitoring	<input type="checkbox"/> 9. Resolved	



Schruben-Rogers Groundwater Monitoring Site

Section 18, Township 7 South, Range 17 West, Rooks County, Kansas
 2014 Groundwater Chloride Levels

District #4 - Sampled 5/28/2014 - Map Drawn on 9/19/2014 by C. Neeley

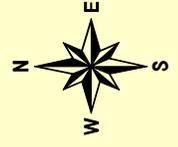

Project: Schulte Brine Contamination Site

Site Location: The legal description is eastern half of sections 7 & 18, and all of Sections 8 and 17, Township 28 South, and Range 1 West of Sedgwick County, Kansas. To the northeast lies the Wichita Mid-Continent Airport. The site is in the drainage systems of the Cowskin Creek and Dry Creek. Dry Creek is a tributary of Cowskin Creek and flows in an easterly direction across the southern part of the site. The confluence of the two creeks is approximately three miles to the southeast of Schulte.

Impact/Immediacy: The impact is to groundwater resources including public supply wells and domestic water wells. The immediacy level is rated as moderate.

Site Description: The project area consists of a groundwater plume contaminated by oilfield brine moving in an east direction. The apparent source for the contamination is salt-water disposal ponds that were associated with activities in the Schulte oil field and some wells in section 6. The site is situated between Wichita Mid-Continent Airport to the northeast and the unincorporated town of Schulte to the west. The land use is a combination of light industrial, agricultural and residential. The aquifer consists of unconsolidated sand, clay and gravel deposits. New construction of commercial/industrial complexes have occurred directly east of the recovery wells at the site. Local geology consists of topsoil underlain by a brown to reddish clay to silty clay inter mixed with sand lenses. Upper clay thickness ranges from 8.5 feet to 33 feet from east to west. Below the top clay there is poorly sorted sand and gravel beds intermixed with thin clay and silt lenses. This sand unit thins to the west unlike the clays above. Under that top sand unit is a brown to red clay silty-clay aquatard that can be up to 60 feet in thickness near the west end of the site. Below the middle clay aquatard is another sand unit. This sand unit is poorly sorted fine to coarse grained with gravel and inter-bedded clay and silt layers. A bottom clay layer separates the sand from the blue Wellington Formation bedrock.

Local hydrology is based within the two sand units that reside above the Permian bedrock but in between substantial clay layers. The middle clay aquatard separates the two aquifers and historical investigations suggest that the brine plume has in the past migrated along the top of this aquatard. Groundwater below the aquatard in the area of the plume has been tested and appears to be historically uncontaminated. The groundwater movement is to the east south-east, with almost easterly movement along the eastern edge of the site.

Unusual Problems: The construction of new structures over the possible plume down-gradient of the recovery system limits future recovery in that direction. Much of the area is for sale for future industrial expansion and could complicate continuance of the remediation of the site.

Status of Project: Remediation by the KCC began at this site on November 1, 2001. The site currently consists of 2 recovery wells, 11 monitoring wells, and one saltwater disposal well that is used to dispose of brine impacted water. On September 4th, 2014, ten groundwater monitoring wells (MW-1, MW-6, MW-7, MW-8, MW-9, MW-15, MW-101, MW-201, MW-301, MW-401) were gauged and sampled. Prior to sampling, groundwater levels were measured in each monitoring well using an electronic water level indicator. A submersible Proactive[®] Water-Spout water pump was used to purge a minimum of three well volumes of groundwater from each well before sampling. Purge water was tested for conductivity prior to being discharged onto the ground surface at the site or contained in a 250 gallon poly-tank if conductivity was high before disposed of into a deep injection well. MW-4 was not sampled due to tree roots that have worked their way into the well blocking the casing. It is doubtful that this well will be repaired and should be plugged at this time. Groundwater samples from each monitoring well were collected in one 250 (ml) polyurethane container for analysis at the KCC District #2 Laboratory. Each sample for this monitoring event was analyzed for the presence of Chloride by United States Environmental Protection Agency (USEPA) Method 9253 (Titrimetric, Silver Nitrate).

Groundwater levels below the ground surface ranged from approximately 12.42 to 30.10 feet in the sampled wells during this year's event, and decreased an average of 0.42 feet since the May 15, 2013 gauging event. Groundwater flow direction flows to the southeast towards the center of the site before turning to an easterly direction. The western hydraulic gradient was found to be 0.00077551 ft/ft between MW-1 and MW-9, and the eastern gradient was 0.003523026 ft/ft from MW-401 to MW-301. This indicates a slower water movement to the southeast before the gradient increases to the east as it approaches the Cowskin Creek.

Level of Remediation Sought:


Ideal: 250 mg/l Chloride
Target: 500 mg/l Chloride

Recommendations for Future Work: The North and East Recovery Wells alternate bi-weekly running. Continue to notify the local water-well contractors of the dangers of constructing wells through both aquifers is needed. The disposal well seems to be taking water at a rapid rate at the current time after being acidized a few years back.

The data resulting from the September 2014 groundwater sampling event show slight increases in the monitoring wells located down gradient in the center of the plume. There was a slight decrease of chlorides in the center near MW-101 and MW-08. There were similar lower chlorides on the outskirts of the plume near MW-301 and MW-7. Considerations will be taken after this year's report to determine whether this site will continue to be remediated in the future.

Estimated Total Costs: \$8,000-10,000 to upkeep the remediation system, perform annual groundwater sampling, and continue investigation of new water wells currently being installed inside the known plume.

Control No.	Staff Hours/Expenditures	Fund Expenditures	
		FY 2014/15	Total
970015-00	262.5 Hrs. / \$6,745.06	\$1,532.34	\$147,927.02
Current Contaminate Level: 40 mg/l in MW #1 to 3,500 mg/l in MW# 101			
Status:			
<input type="checkbox"/> 1. Site Assessment	<input type="checkbox"/> 2. Short Term Monitoring	<input type="checkbox"/> 3. Investigation	
<input checked="" type="checkbox"/> 4. Long Term Monitoring	<input type="checkbox"/> 5. Remediation Plan	<input type="checkbox"/> 6. Installation	
<input checked="" type="checkbox"/> 7. Remediation	<input type="checkbox"/> 8. Post Rem. Monitoring	<input type="checkbox"/> 9. Resolved	

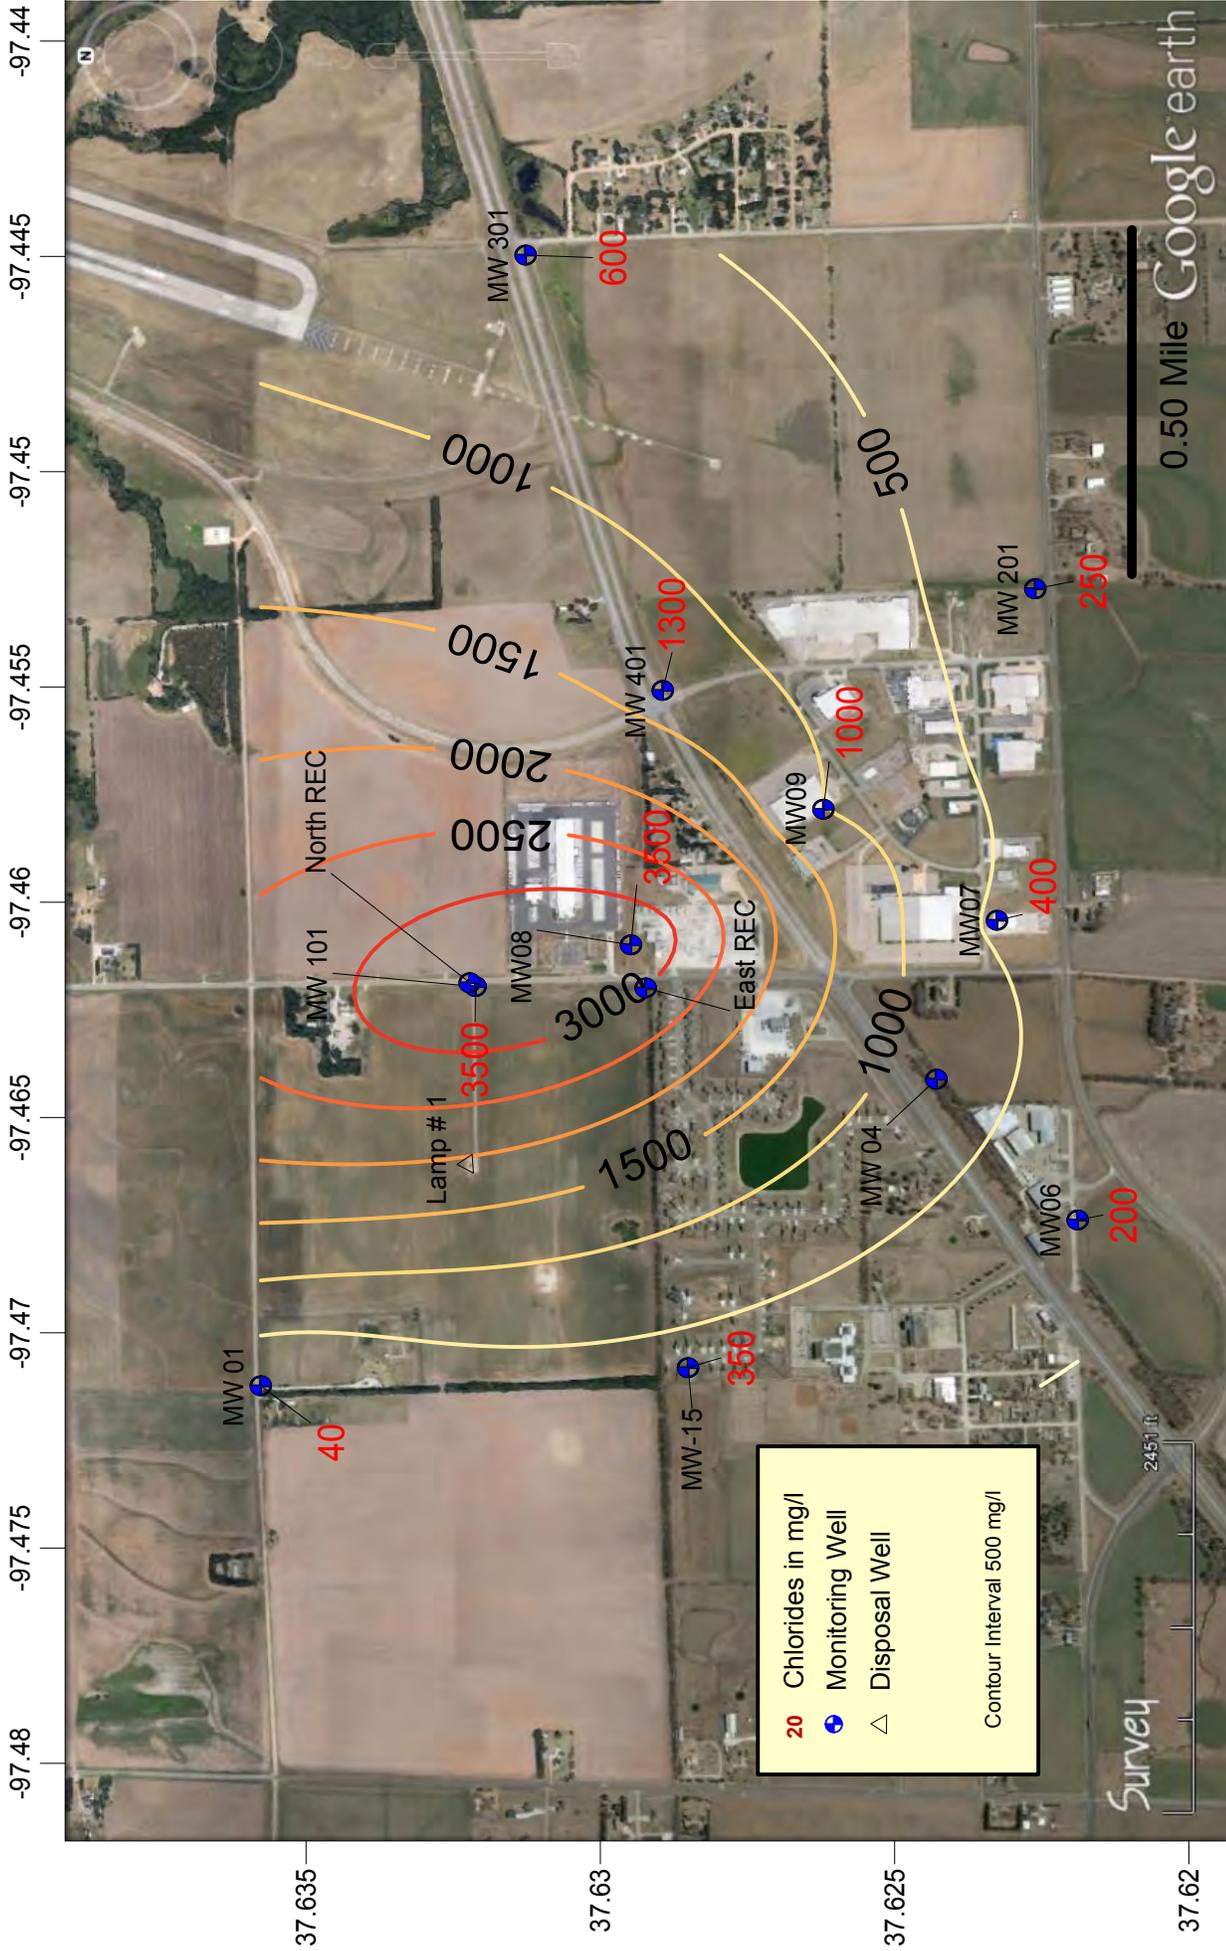

Schulte Contamination Site - Monitoring and Remediation Wells
 Sections 7 & 8, T 28 S & R 1 W, Sedgwick County, Kansas
Chloride Concentrations (mg/L) September 2014
 KCC Project Number #970015-00 - District #2 - B. Milner - Map Drawn: 9/12/14 - Measured: 9/4/14




Survey

0.50 Mile Google earth

2453 ft.

-97.48 -97.475 -97.47 -97.465 -97.46 -97.455 -97.45 -97.445 -97.44

37.635 37.63 37.625 37.62

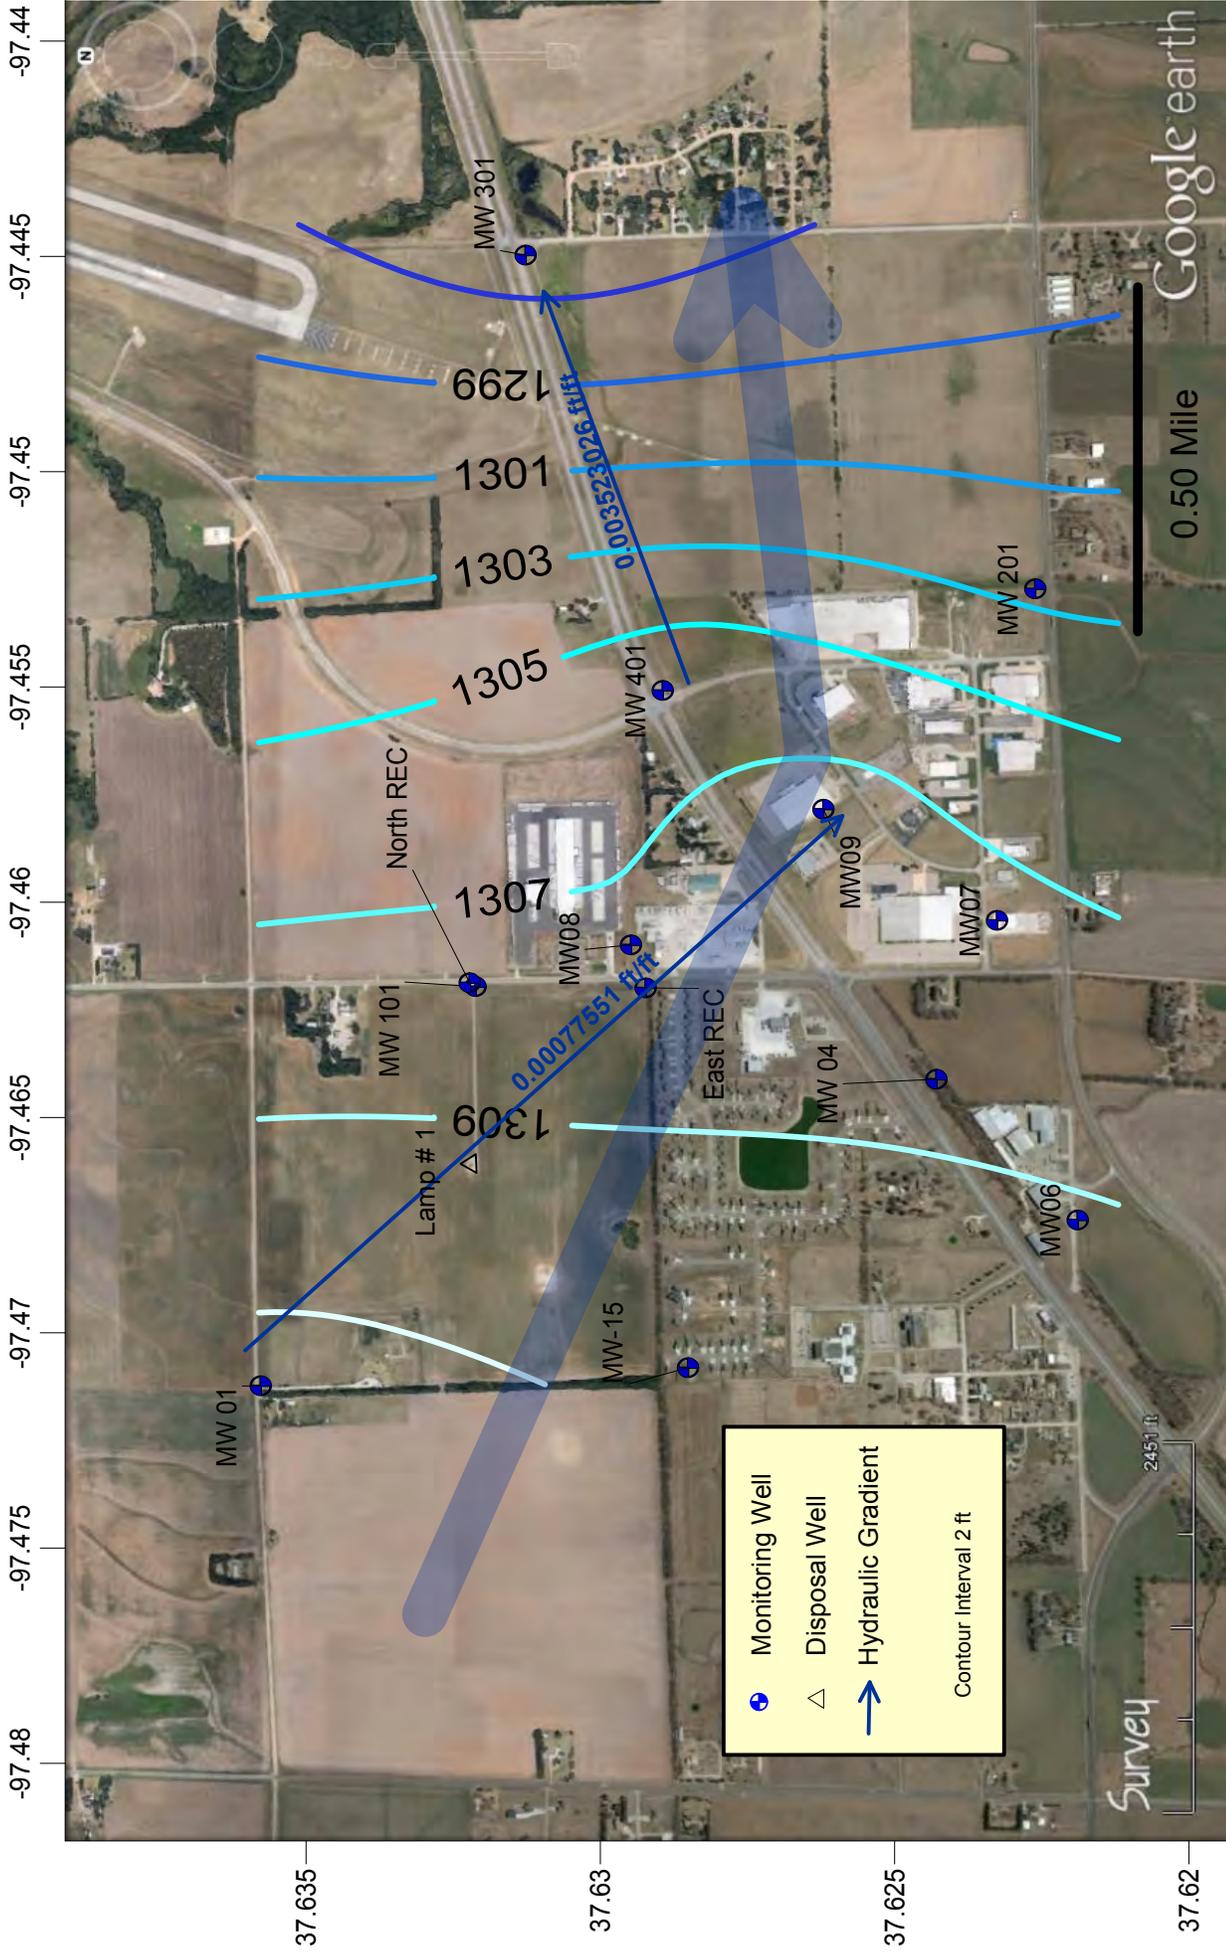

	Monitoring Well
	Disposal Well
	Hydraulic Gradient
Contour Interval 2 ft	

Schulte Contamination Site - Monitoring and Remediation Wells
 Sections 7 & 8, T 28 S & R 1 W, Sedgwick County, Kansas
Static Groundwater Elevations September 2014
 KCC Project Number #970015-00 - District #2 - B. Milner - Map Drawn: 9/12/14 - Measured: 9/4/14



Survey

Google earth

0.50 Mile

245.3 ft.

Project: Selzer -Bitikofer Contamination Site

Site Location: The Selzer-Bitikofer Site is two miles east and 2 miles south of Canton, McPherson County, Kansas, centered approximately at the corner of Iron Horse Road and 29nd Avenue, in Sections 35 and 36, Township 19 South, Range 1 West and sections 1 and 2, Township 20 South, Range 1 West. The Selzer-Bitikofer Site currently comprised of agricultural fields, pastures, and residences.

Impact/Immediacy: The site affects West Emma Creek and local groundwater. The immediacy level of the site is listed as moderate.

Site Description: Geologically, the site is located in far eastern edge of the Lower Arkansas River basin, and is characterized by fine textured soil with a silty clay loam surface soil and a strong clay pan development. Sediments at the site consist mainly of unconsolidated Pleistocene deposits of the McPherson Formation (KGS bulletin 79). The immediate area is topographically flat, with slopes ranging from 0-3 percent. Based on the site evaluation to date, the underlying material to a depth of approximately 35 feet was found to consist primarily of stiff clay and/or sandy clay, overlying fine to coarse sands of varying thickness. The sand member is underlain by an impermeable dense clay layer that is consistent throughout the site. Bedrock in the area consists of the Kiowa Shale Formation and lies approximately 50-70' below ground surface (KGS Bulletin 79). Bedrock was never encountered during site activities for verification.

Based on groundwater data from the present site investigation, shallow groundwater is found at depths ranging from approximately 6 to 13 feet bgs at the site, and groundwater flow in the surface aquifer beneath the site to the south and southwest and nearly west closer to West Emma Creek. The principal water-bearing formation in the subject site area is thin varying thickness unconsolidated sand that lies between clay layers. This sand varies from fine to coarse grained and pinches off in some locations. Based on information obtained from the Kansas Rural Water Association, the subject site area is serviced by Marion Rural Water District (RWD) #4. Based on information obtained from the KGS WWC5 Database, there no public water supply (PWS) wells located within 1-mile from the subject site. There are three domestic wells (Bitikofer, Selzer and Huebert) located within ¼-mile from the subject site, but there known unregistered and open water wells in the area.

Unusual Problems: An aggressive withdrawal system could render the local water wells and West Emma Creek dry.

Status of Project: On October 6, 2014, eight groundwater monitoring wells (MW-1, MW-3, MW-4, MW-5, MW-6, MW-7, Klaassen East, and Klaaseen West) were gauged and sampled. Due to crops in the fields the large diameter Klaassen wells could not be pumped, and were approached by foot and hand bailed 3 gallons before sampling. Each sample for this monitoring event was analyzed for the presence of Chloride by United States Environmental Protection Agency Silver Nitrate Buret Titration Method 8225. All monitoring wells were found to be above 250 mg/L chlorides, ranging from 1,400 to 3,500 mg/L. There are currently no monitoring wells capable of delineating the plumes. MW-3 will need to be dug up and repaired as the casing has broken off 1 foot below ground level, but is repairable.

Level of Remediation Sought:


Ideal: 250 mg/l Chloride

Target: 500 to 750 mg/l Chloride

Recommendations for Future Work: KCC will produce a scope of work that include the installation of monitoring wells and addition investigative borings in order to delineate the three plumes found at the Selzer-Bitikofer Site. One deep boring to bedrock is recommended to help with the investigation on the local sources. KCC may attempt to dig up and check abandoned oil and gas wells in the immediate area to verify plug integrity.

Estimated Total Cost: \$20,000 to 30,000 to perform routine sampling, research into the northern plume, and installation of multiple monitoring wells.


Control No.	Staff Hours/Expenditures	Fund Expenditures	
		FY 2014/15	Total
970093-00	51.5 Hrs. / \$1,360.82		\$12,133.50
Current Contaminate Level: 1100 mg/l (MW-6) to 4800 mg/l Cl (Klaassen East)			
Status:			
<input type="checkbox"/> 1. Site Assessment	<input type="checkbox"/> 2. Short Term Monitoring	<input checked="" type="checkbox"/> 3. Investigation	
<input checked="" type="checkbox"/> 4. Long Term Monitoring	<input type="checkbox"/> 5. Remediation Plan	<input type="checkbox"/> 6. Installation	
<input type="checkbox"/> 7. Remediation	<input type="checkbox"/> 8. Post Rem. Monitoring	<input type="checkbox"/> 9. Resolved	

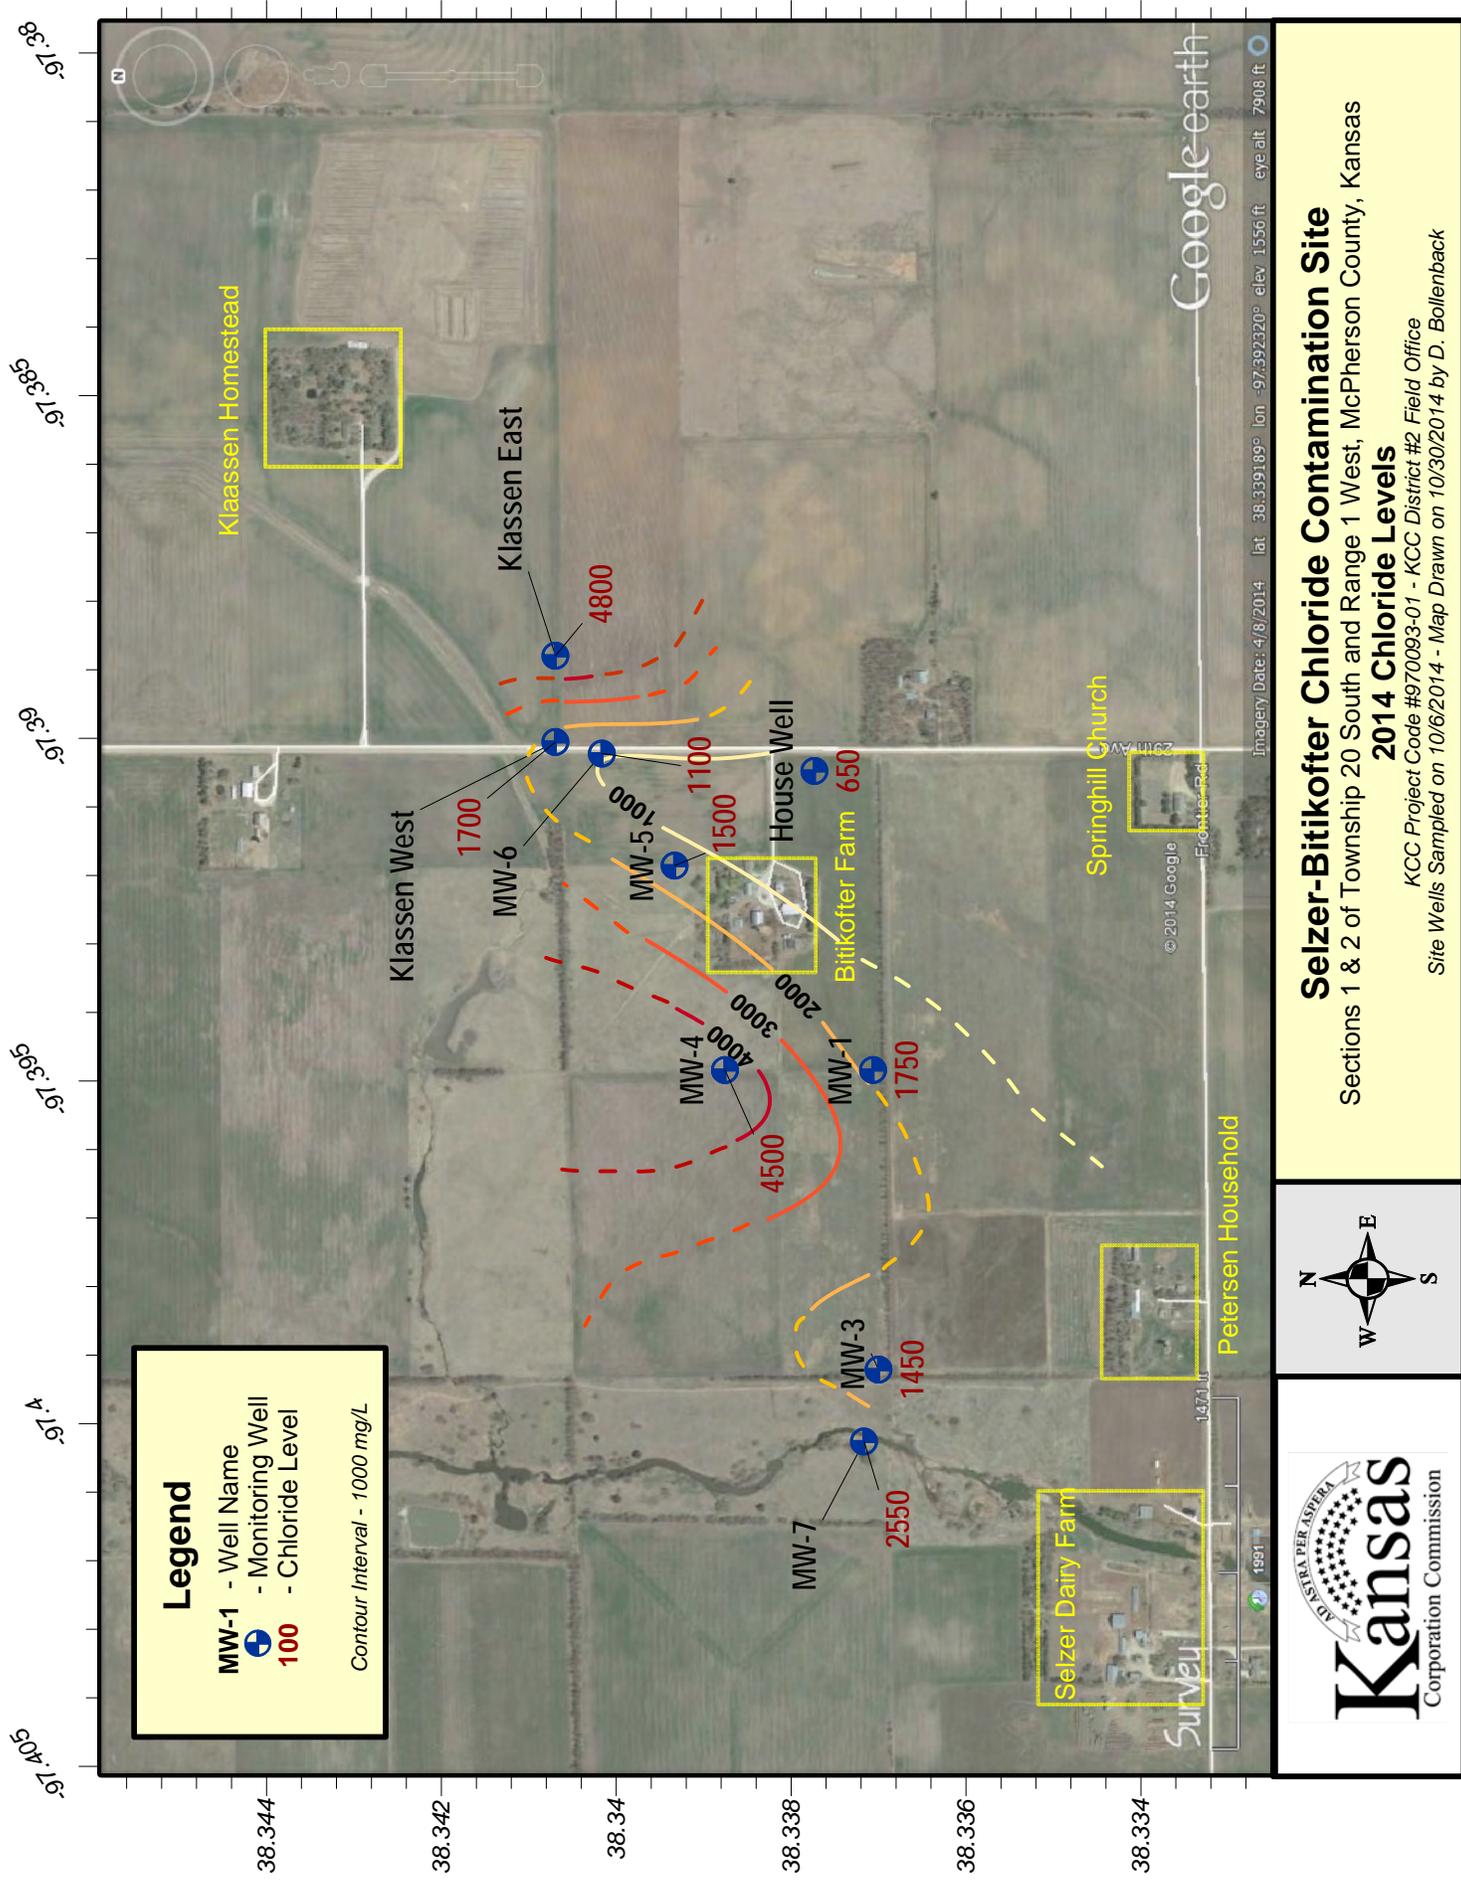

Legend

- MW-1 - Well Name
- - Monitoring Well
- 100 - Chloride Level

Contour Interval - 1000 mg/L

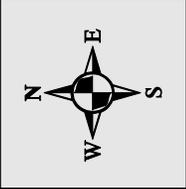

Selzer-Bitkoffter Chloride Contamination Site
 Sections 1 & 2 of Township 20 South and Range 1 West, McPherson County, Kansas
2014 Chloride Levels
 KCC Project Code #970093-01 - KCC District #2 Field Office
 Site Wells Sampled on 10/6/2014 - Map Drawn on 10/30/2014 by D. Bollenback

Google-earth
 Imagery Date: 4/8/2014 lat: 38.339189° lon: -97.392320° elev: 1556 ft eye alt: 7908 ft

Project: *Smith Finn Contamination Site*

Site Location: Legal location is SE/4 of Section 8 Township 34 South, Range 43 West, in Morton County.

Impact/Immediacy: The impact is to a house domestic well, which has exhibited high chloride levels. The PRP (Anadarko) drilled a new domestic well in January of 1989. This site has a moderate immediacy level.

Site Description: The project consists of a localized pollution of the groundwater in the Ogallala Formation. The area is on the south edge of the high plains as the terrain begins to break downward to the Cimarron River valley, which is located one and one-half miles to the south.

Unusual Problems: The threat of contaminated groundwater moving from the Smith-Finn property to land owned by the BLM. Multiple sand layers with different levels of contamination.

Status of Project: Progress continues to be made towards closure of the site. Chlorides continue to decrease overall throughout the site. The KCC and Anadarko agreed to the plugging of the MW-9 well. MW-9 was plugged on October 16, 2013. There are ongoing discussions as to whether a replacement well for the MW-9 needs to be drilled. MW 10-8, MW 11-8, and MW 12-8 have not been proposed to be plugged at this time. Much of the current work is to find the small areas that are problematic and remediate those areas.

Level of Remediation Sought:


Ideal: 250 ppm Chloride

Target: 500 ppm Chloride

Recommendation for Future Work: PW-4 will remain operational until chlorides have dropped close to or into the fresh water standard. If a decision is made to install a replacement well, it will likely be to the southeast of where MW-9 was located. As the site has continued to make significant progress in the removal of chlorides, the project will begin to transition out of a remedial phase, into a monitoring phase.

Estimated Total Costs: \$200,000 for PRP.


Control No.	Staff Hours/Expenditures	Fund Expenditures	
		FY 2014/15	Total
970095-00	9 Hrs. / \$243.49		
Current Contaminate Level: 8.02 ppm Cl- to 9,030 ppm Cl-			
Status:			
<input type="checkbox"/> 1. Site Assessment	<input type="checkbox"/> 2. Short Term Monitoring	<input type="checkbox"/> 3. Investigation	
<input checked="" type="checkbox"/> 4. Long Term Monitoring	<input checked="" type="checkbox"/> 5. Remediation Plan	<input type="checkbox"/> 6. Installation	
<input checked="" type="checkbox"/> 7. Remediation	<input type="checkbox"/> 8. Post Rem. Monitoring	<input type="checkbox"/> 9. Resolved	

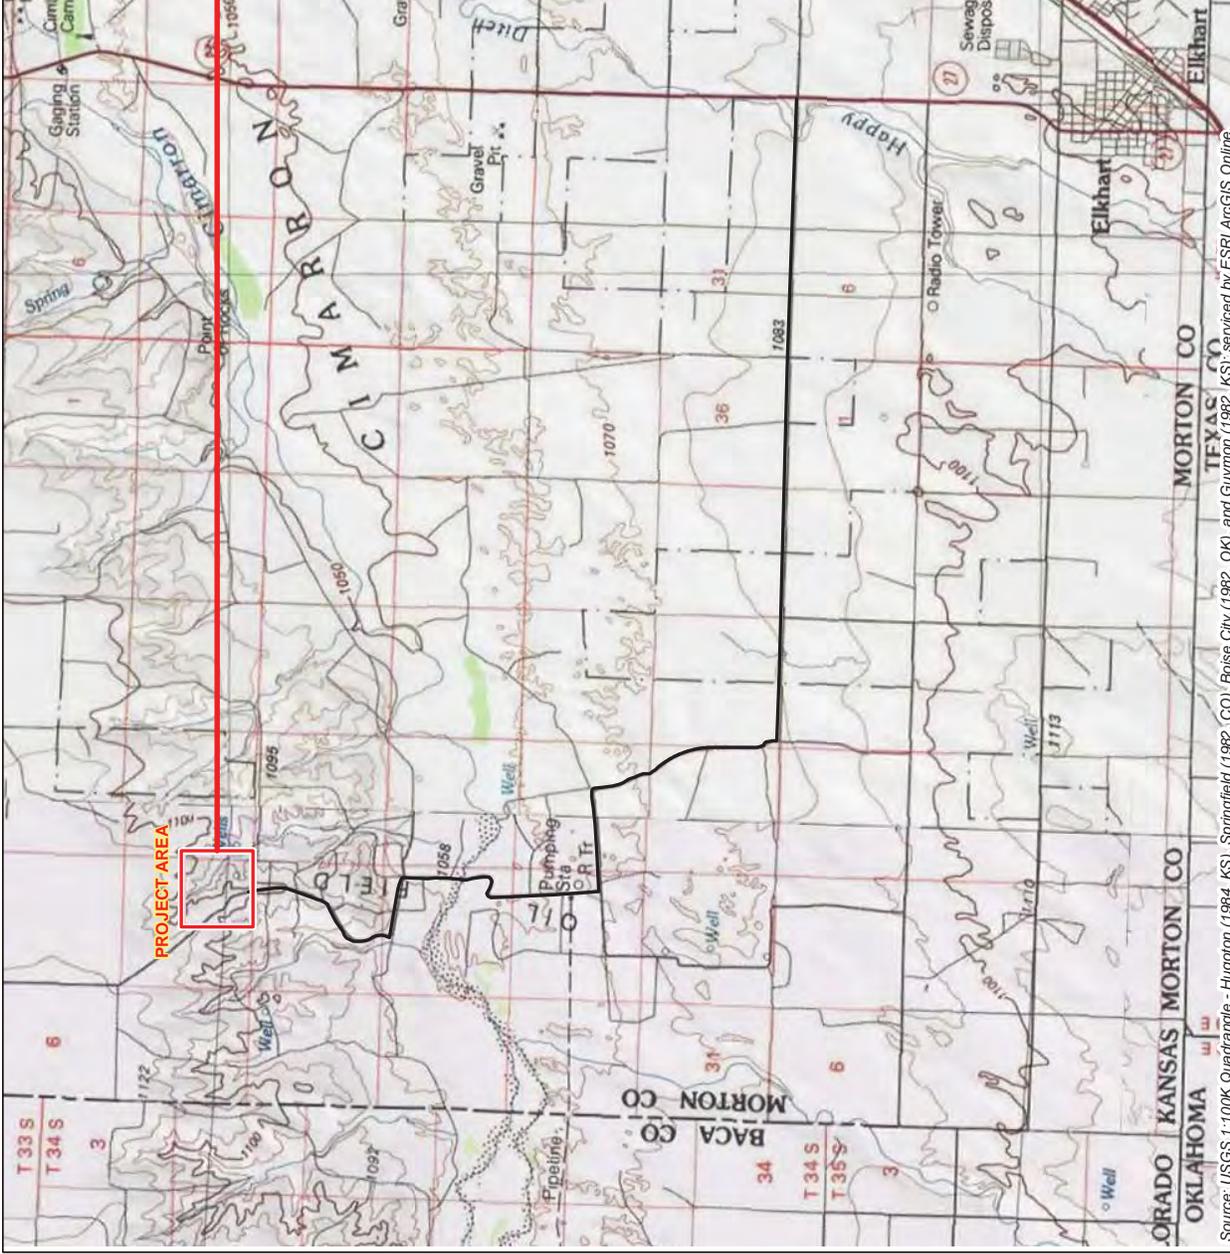

Prepared For:	Anadarko Petroleum Corporation
Designed:	PKQ
Title:	Project Area and Regional Vicinity
Drawn:	ME
Checked:	DDZ
Revised:	NA
Smith Finn - Elkhart, Kansas	
2013 Annual Report	
Morton County, Kansas	
File: O:\G02022\Fig1_SiteLocation.mxd	
Date:	2/10/2014
Figure:	1

Source: USGS 1:100K Quadrangle - Hugoton (1984, KS), Springfield (1982, CO), Boise City (1982, OK), and Guyton (1982, KS), serviced by ESRI ArcGIS Online.




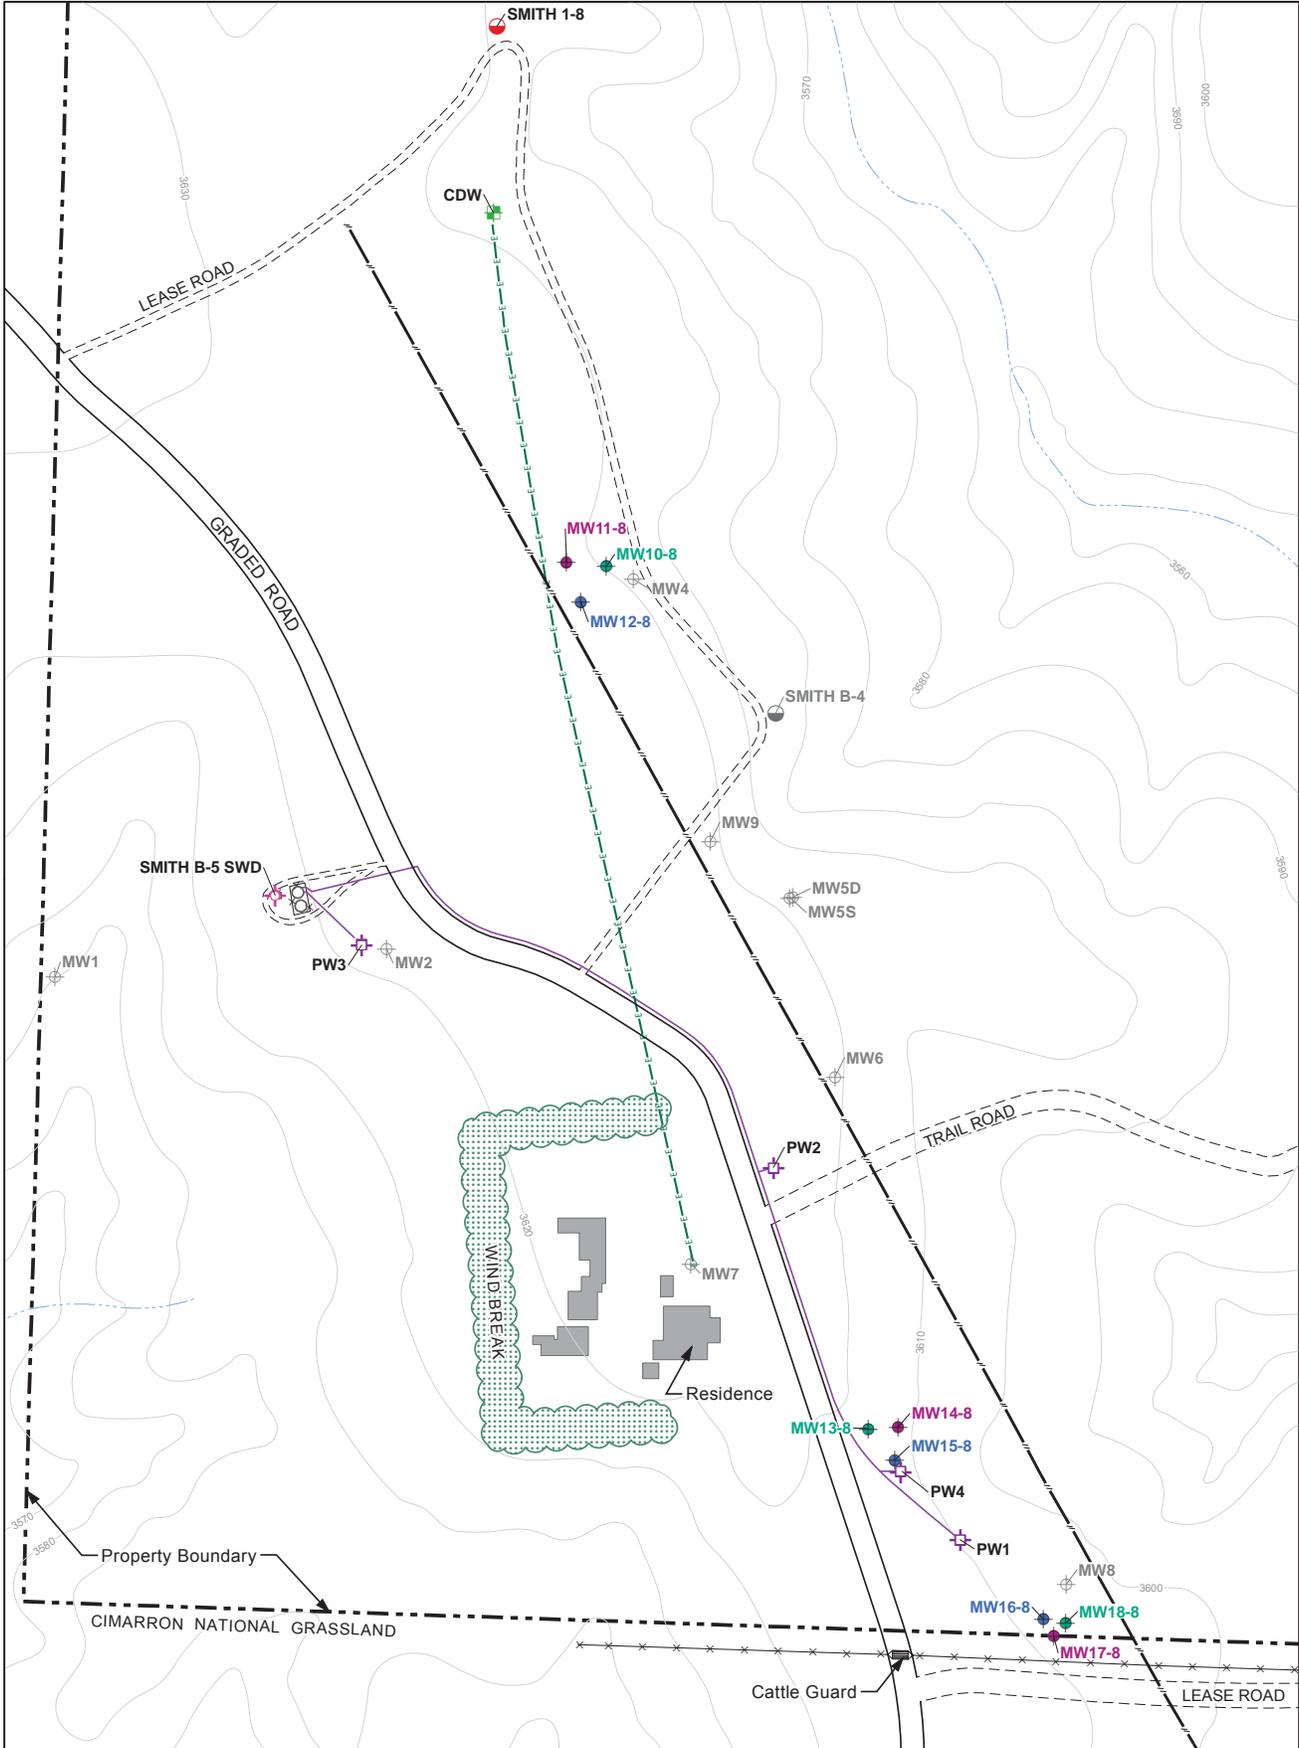


LEGEND

- | | |
|---------------------------------------|------------------------|
| Shallow Zone Monitoring Well | Pipeline |
| Intermediate Zone Monitoring Well | Underground Power Line |
| Deep Zone Monitoring Well | Discharge Line |
| Plugged and Abandoned Monitoring Well | Stream |
| Current Domestic Well | Fence |
| Recovery Well | |
| Salt Water Disposal Well | |
| Oil & Gas Well | |
| Plugged and Abandoned Oil & Gas Well | |

Contours are in 10 feet intervals.

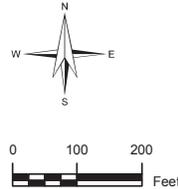

Prepared For:		Designed: PKQ
Title: Site Layout Map		Drawn: ME
Smith Finn - Elkhart, Kansas		Checked: DDZ
2013 Annual Report	Morton County, Kansas	Revised: NA
File: Q:\GC002026\Fig2_SiteLayout.mxd	Date: 2/10/2014	Figure: 2

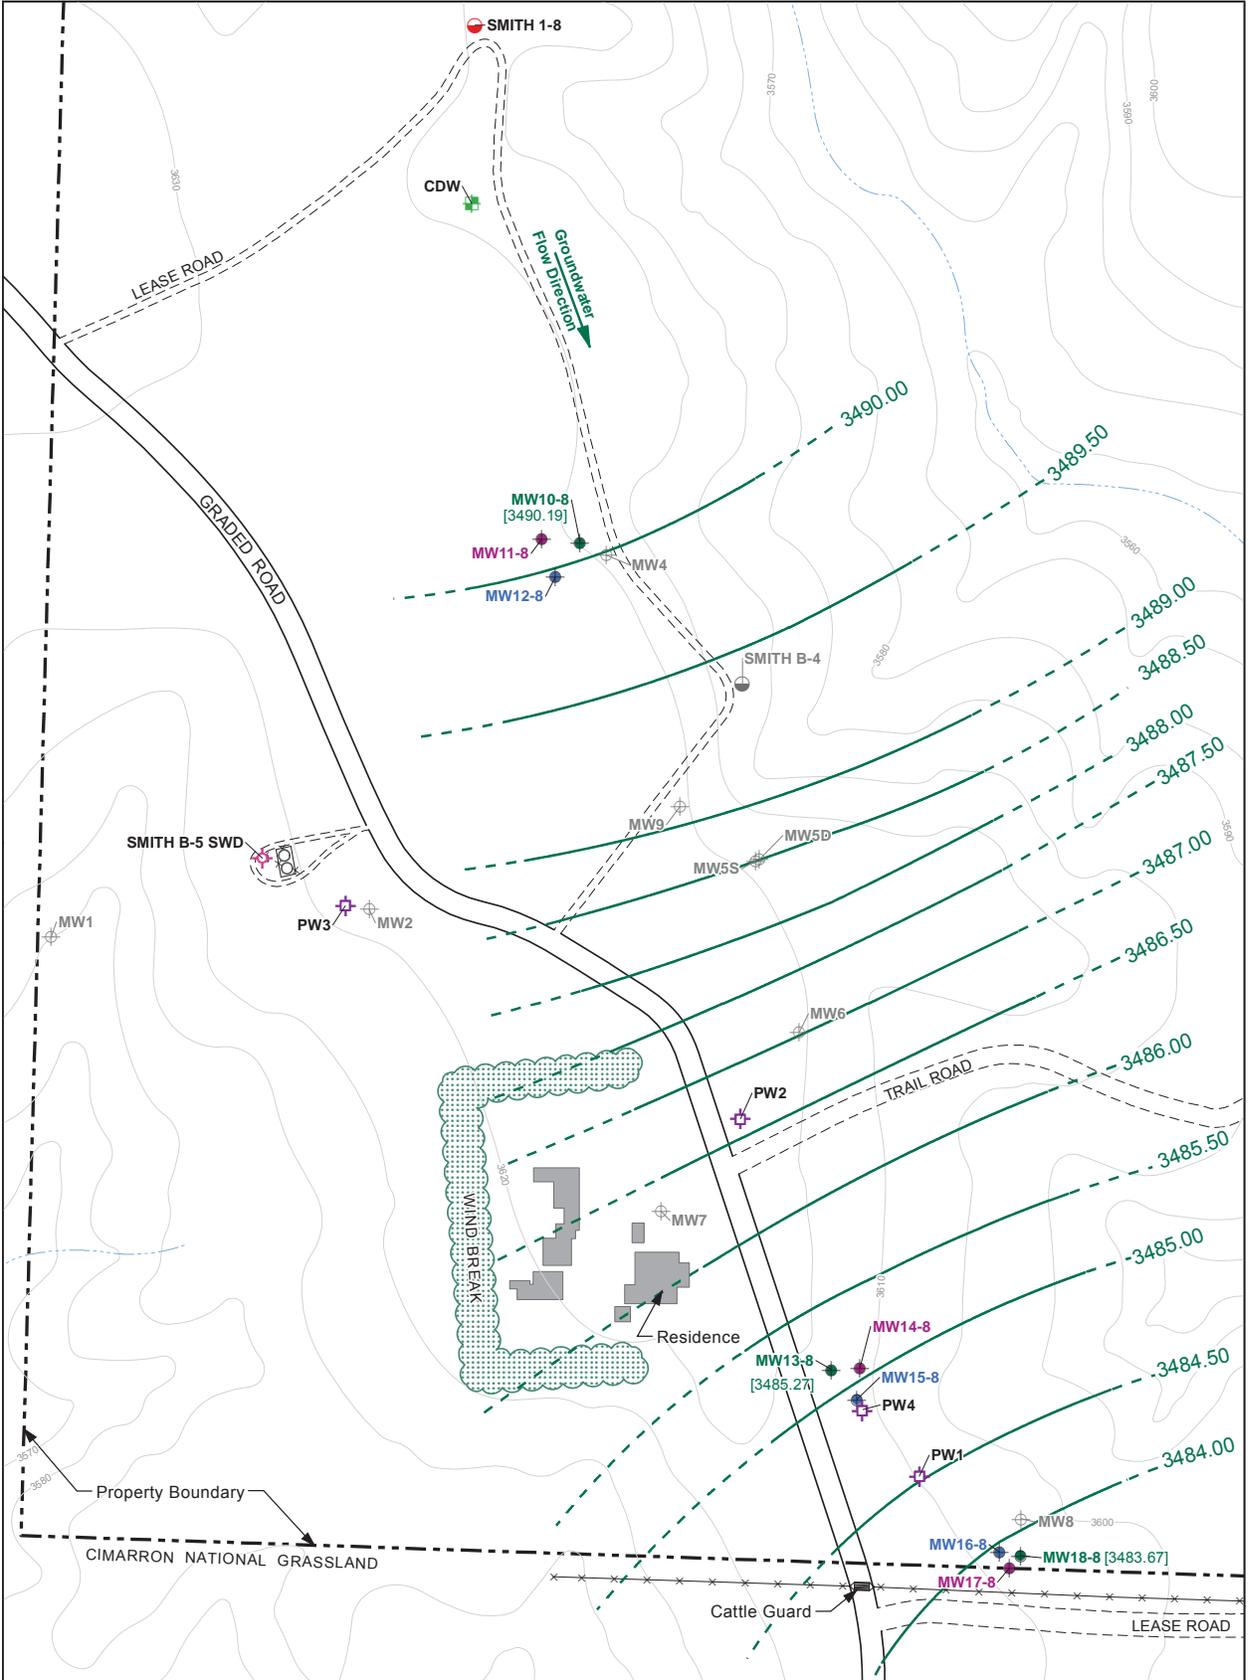

LEGEND


- Shallow Zone Monitoring Well
- Intermediate Zone Monitoring Well
- Deep Zone Monitoring Well
- Plugged and Abandoned Monitoring Well
- Current Domestic Well
- Recovery Well
- Salt Water Disposal Well
- Oil & Gas Well
- Plugged and Abandoned Oil & Gas Well

3488.00 Shallow zone groundwater gradient contour elevation (dashed where inferred)


[3483.62] Shallow zone groundwater elevation (Feet)

NOTE

1. MW9 was plugged and abandoned on October 8, 2013.
2. Groundwater extraction from PW1 and PW2 was initiated on June 8, 2006.
3. Groundwater extraction from PW3 was initiated on November 5, 2009.
4. Groundwater extraction from PW4 was initiated on June 7, 2012.

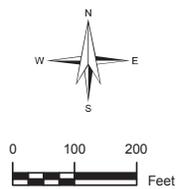

Prepared For:		Designed: PKQ
Title: Potentiometric Surface Map for Shallow Water Bearing Zone November 2013		Drawn: ME
Smith Finn - Elkhart, Kansas		Checked: DDZ
2013 Annual Report	Morton County, Kansas	Revised: NA
File: Q:\GC002026\Fig3_Potentiometric_SZ.mxd	Date: 2/10/2014	Figure: 3

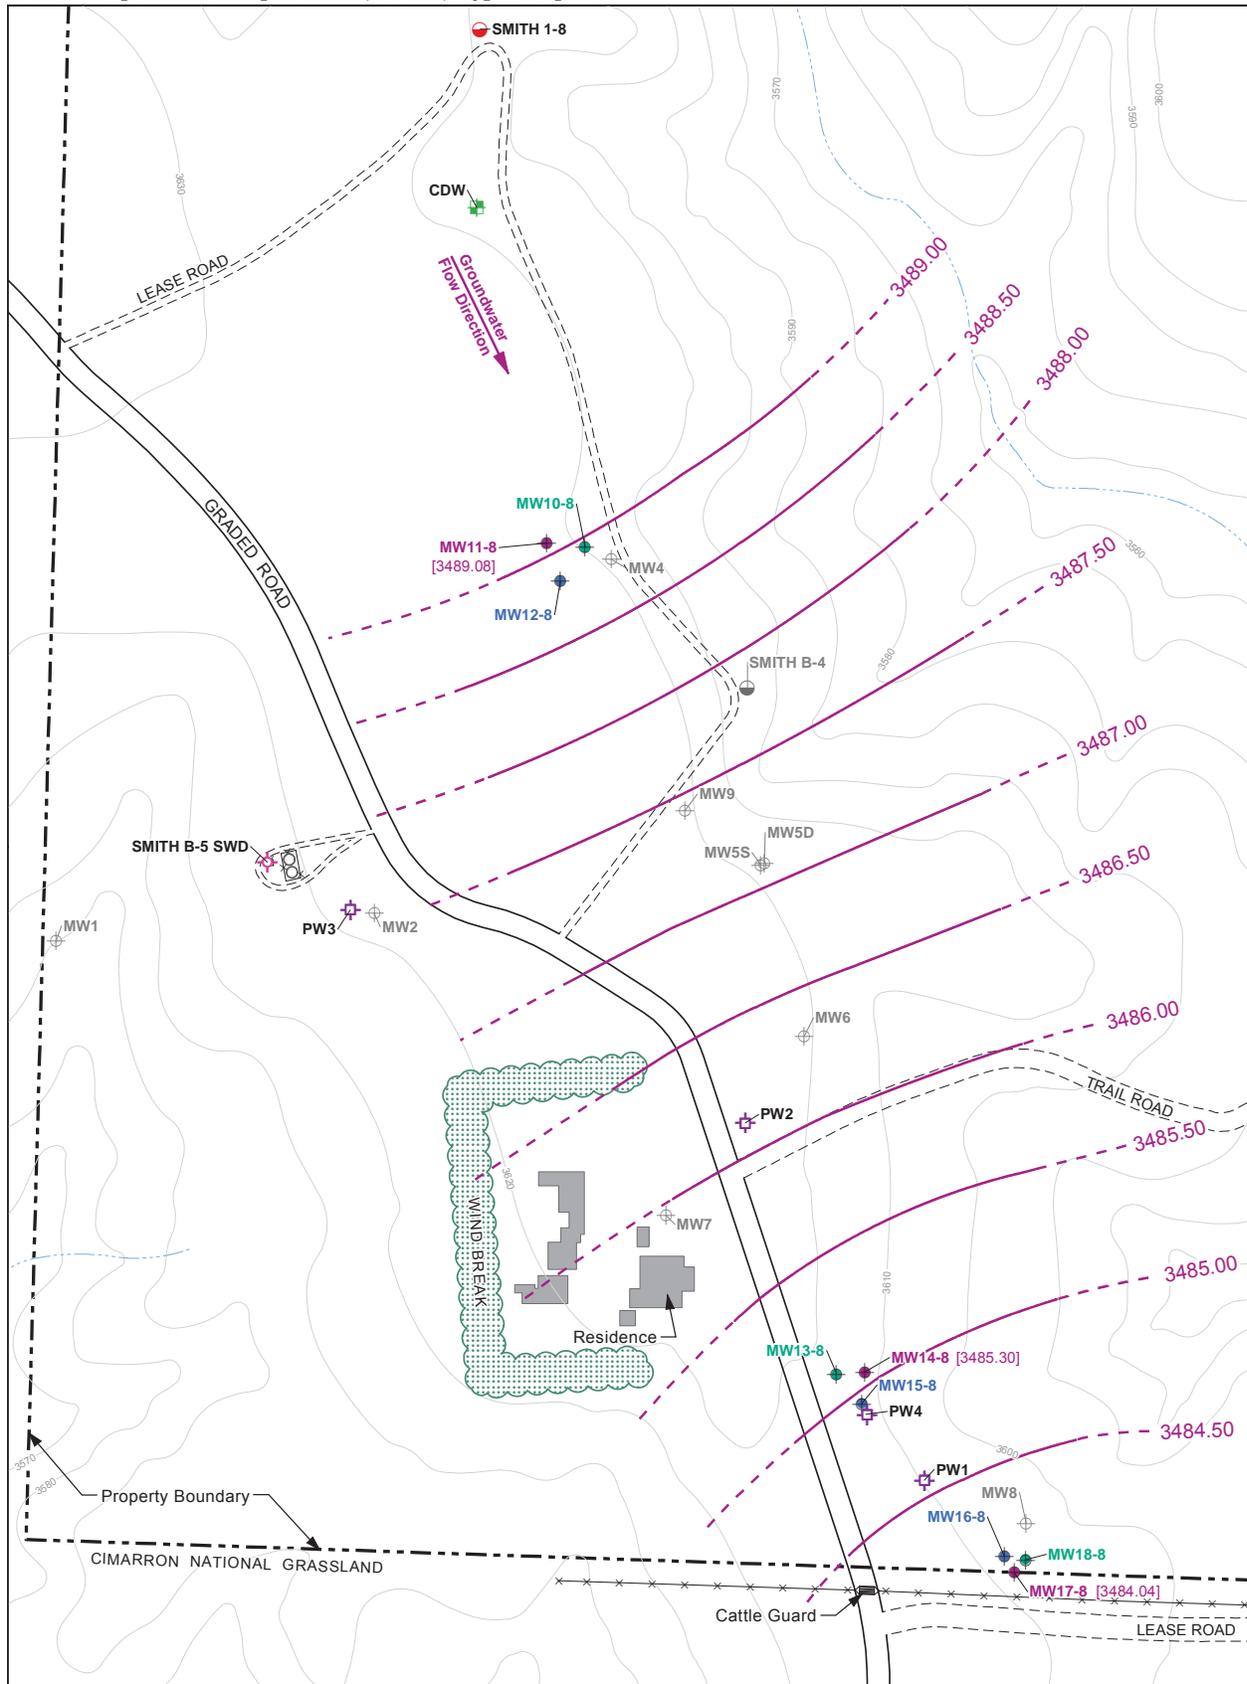


LEGEND

- Shallow Zone Monitoring Well
- Intermediate Zone Monitoring Well
- Deep Zone Monitoring Well
- Plugged and Abandoned Monitoring Well
- Current Domestic Well
- Recovery Well
- Salt Water Disposal Well
- Oil & Gas Well
- Plugged and Abandoned Oil & Gas Well


— 3488.00 Intermediate zone groundwater gradient contour elevation (dashed where inferred)
 [3483.41] Intermediate zone groundwater elevation (Feet)

NOTE

1. MW9 was plugged and abandoned on October 8, 2013.
2. Groundwater extraction from PW1 and PW2 was initiated on June 8, 2006.
3. Groundwater extraction from PW3 was initiated on November 5, 2009.
4. Groundwater extraction from PW4 was initiated on June 7, 2012.

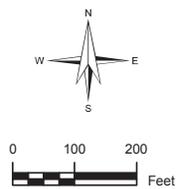

Prepared For:		Designed: PKQ
Title: Potentiometric Surface Map for Intermediate Water Bearing Zone November 2013		Drawn: ME
Smith Finn - Elkhart, Kansas		Checked: DDZ
2013 Annual Report	Morton County, Kansas	Revised: NA
File: Q:\GC002026\Fig4_Potentiometric_IJ.mxd	Date: 2/10/2014	Figure: 4

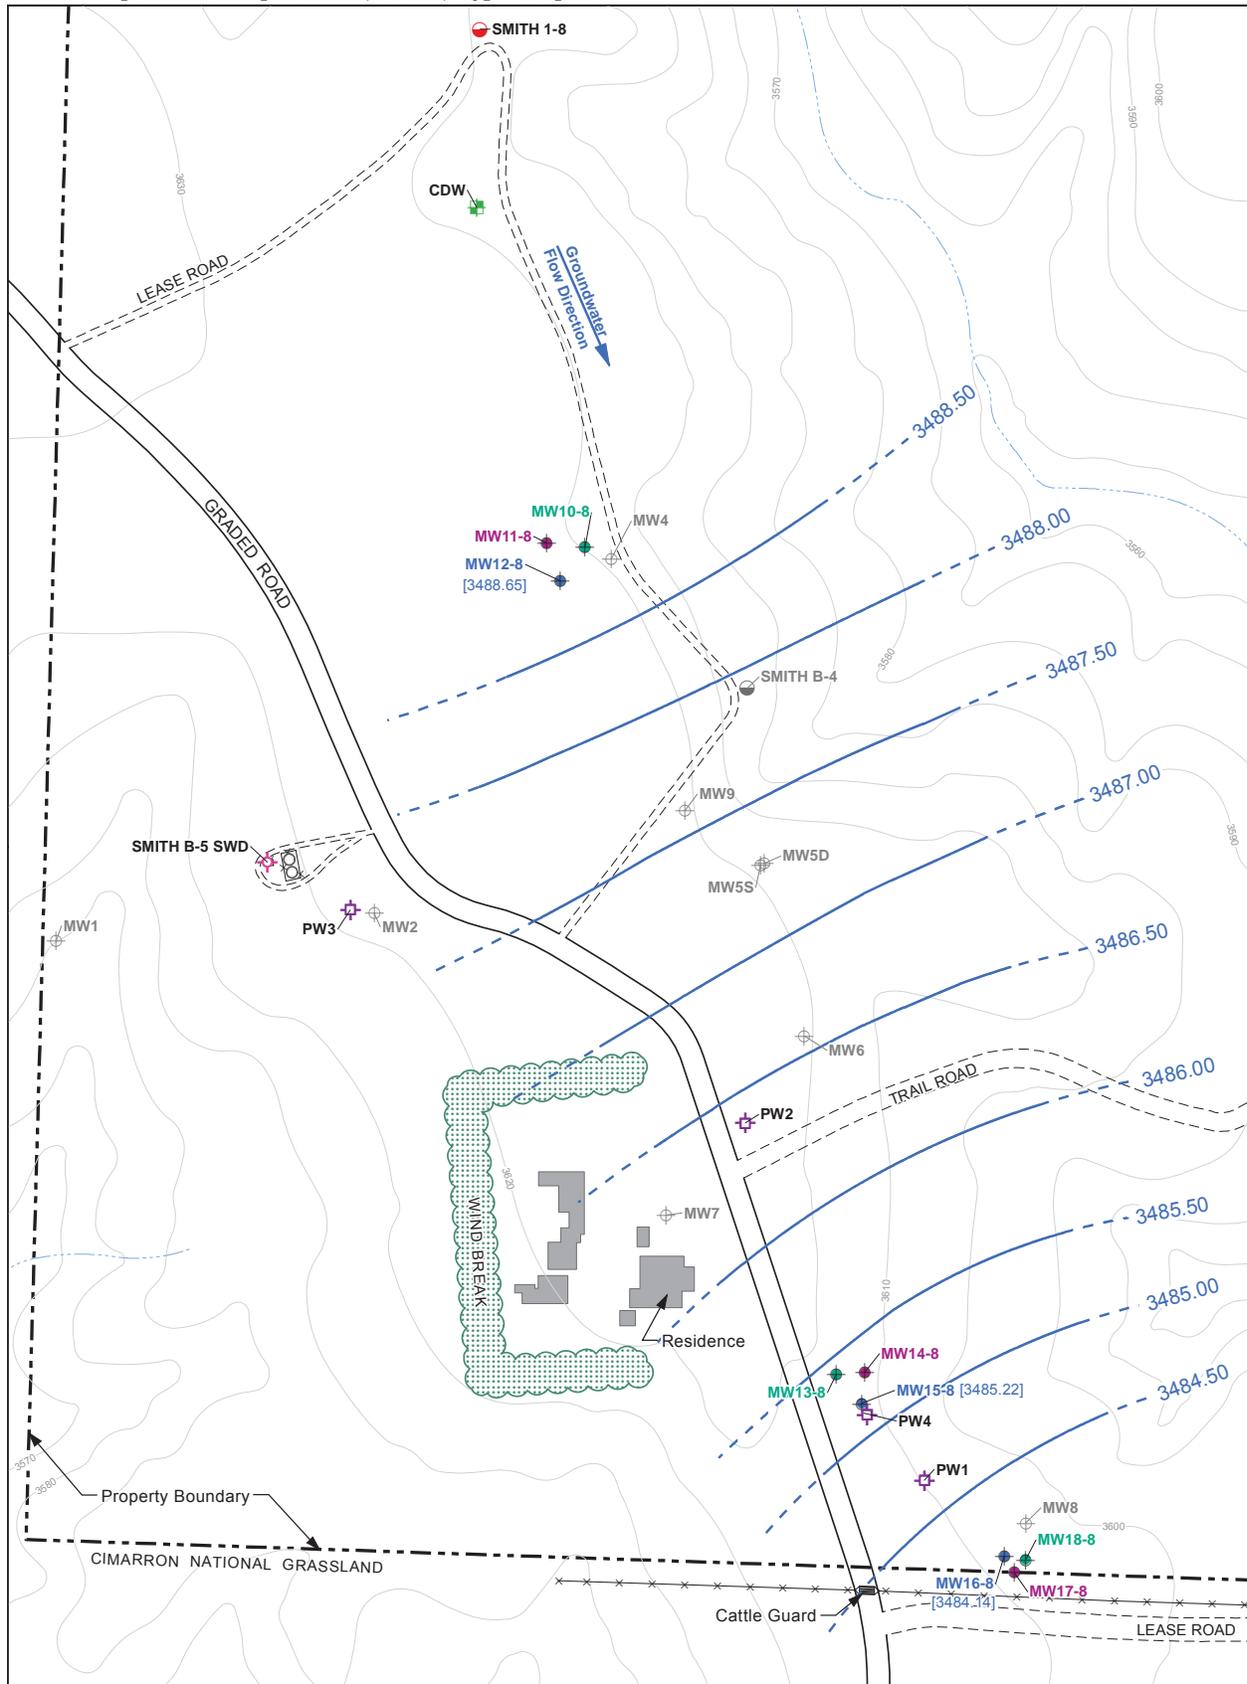


LEGEND

- Shallow Zone Monitoring Well
- Intermediate Zone Monitoring Well
- Deep Zone Monitoring Well
- Plugged and Abandoned Monitoring Well
- Current Domestic Well
- Recovery Well
- Salt Water Disposal Well
- Oil & Gas Well
- Plugged and Abandoned Oil & Gas Well


— 3488.00 Deep zone groundwater gradient contour elevation (dashed where inferred)
 [3482.99] Deep zone groundwater elevation (Feet)

NOTE

1. MW9 was plugged and abandoned on October 8, 2013.
2. Groundwater extraction from PW1 and PW2 was initiated on June 8, 2006.
3. Groundwater extraction from PW3 was initiated on November 5, 2009.
4. Groundwater extraction from PW4 was initiated on June 7, 2012.

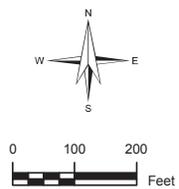

Prepared For:		Designed:	PKQ	
Title:	Potentiometric Surface Map for Deep Water Bearing Zone November 2013		Drawn:	ME
	Smith Finn - Elkhart, Kansas		Checked:	DDZ
	2013 Annual Report	Morton County, Kansas	Revised:	NA
File: Q:\GC002026\Fig5_Potentiometric_DZ.mxd	Date:	2/10/2014	Figure:	5

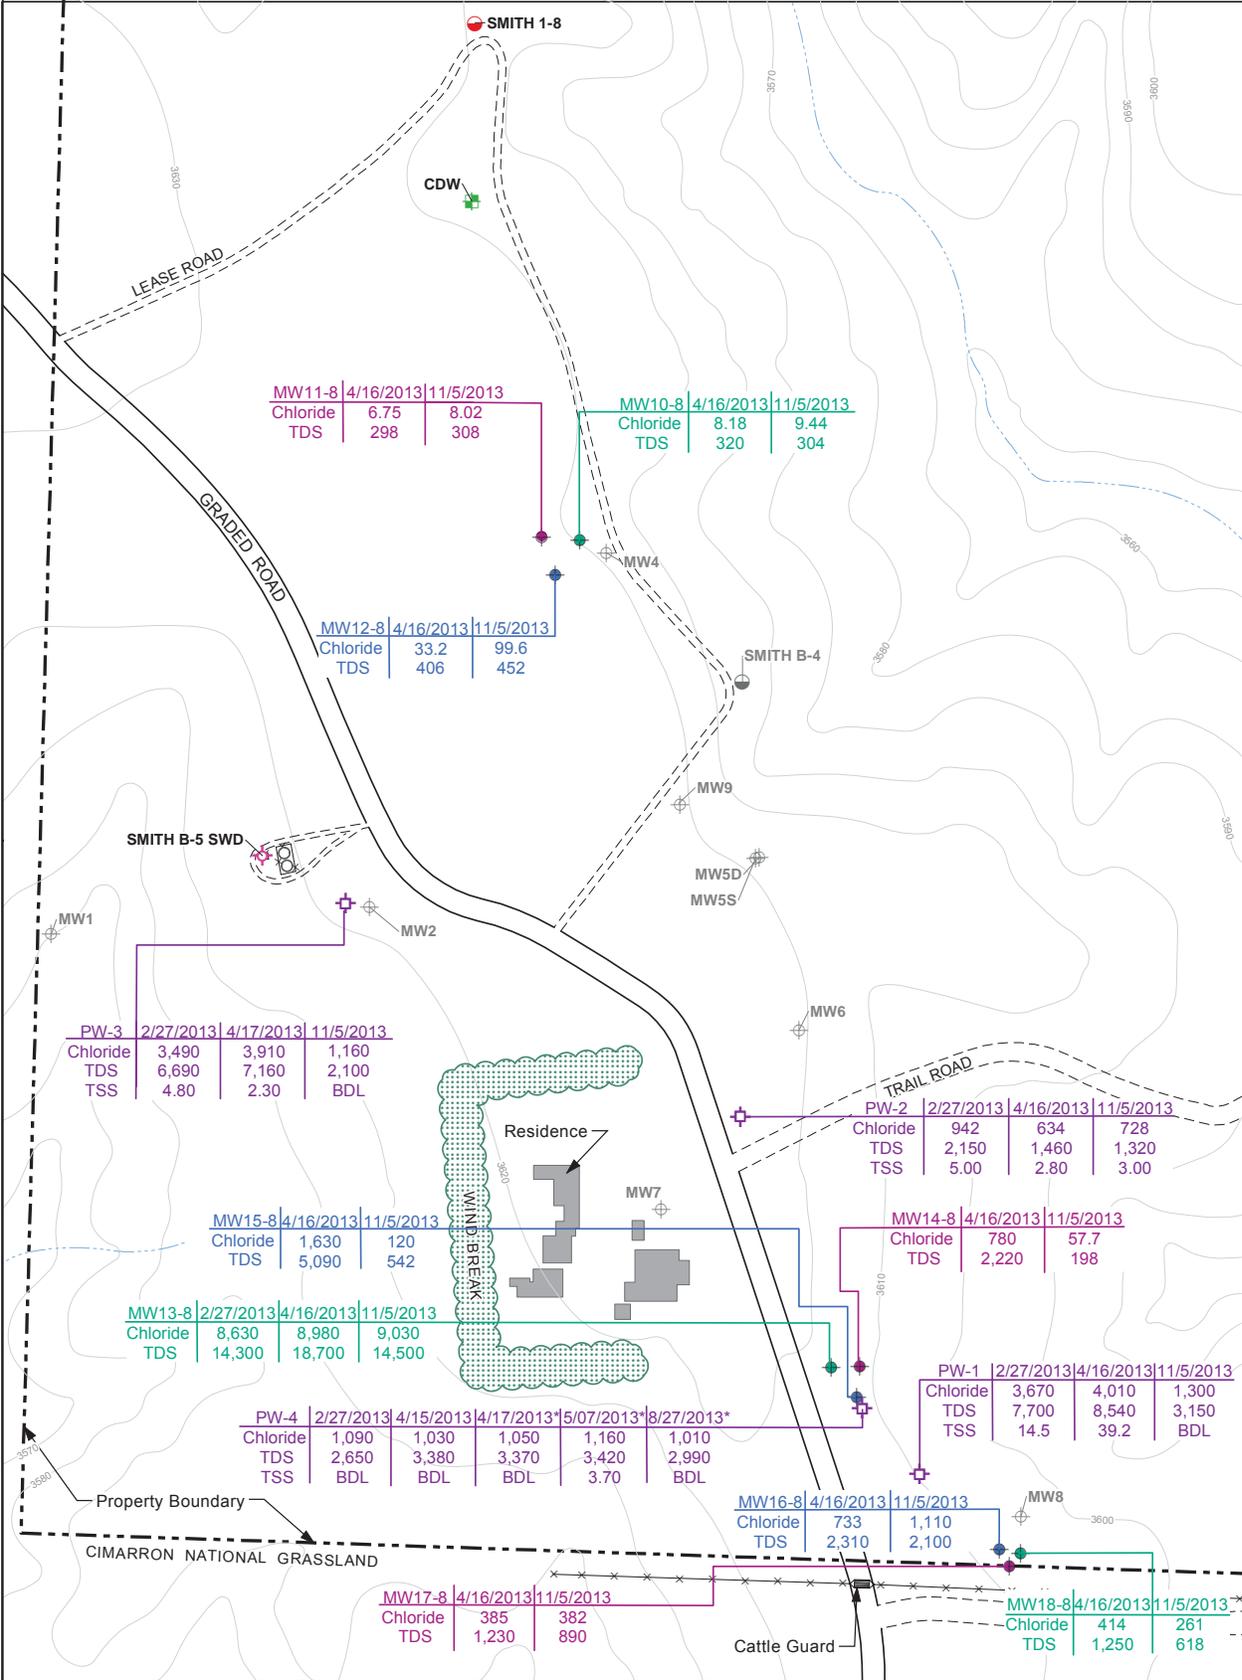


LEGEND


- Shallow Zone Monitoring Well
- Intermediate Zone Monitoring Well
- Deep Zone Monitoring Well
- Plugged and Abandoned Monitoring Well
- Current Domestic Well
- Recovery Well
- Salt Water Disposal Well
- Oil & Gas Well
- Plugged and Abandoned Oil & Gas Well

NOTE

1. MW9 was plugged and abandoned on October 8, 2013.
2. Extraction wells PW1 and PW2 screen both the shallow and intermediate zones. Extraction well PW3 and PW4 screen the shallow, intermediate, and deep zones.
3. The remedial system was optimized for cyclical recovery well operations the week of October 7, 2013. Prior to optimization, the average operational pumping rate was 15.8 gpm (PW4). Following optimization, the average operational pumping rates were 2.9 gpm (PW1) and 12.7 gpm (PW3). PW2 has been offline since November 2009.
4. All values are in milligrams per liter (mg/L).
5. The pump in PW4 was raised 20 feet on April 16, 2013 to a pump elevation of 150 feet below ground surface. An asterisk (*) indicates the sample was collected following this change in pump elevation.
6. TDS = Total Dissolved Solids
7. TSS = Total Suspended Solids
8. NS = Not Sampled
9. gpm = gallons per minute
10. BDL = Below Detection Limit

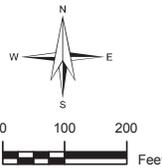

Prepared For:		Designed:	PKQ
Title:	2013 Analytical Data	Drawn:	ME
	Smith Finn - Elkhart, Kansas	Checked:	DDZ
2013 Annual Report	Morton County, Kansas	Revised:	NA
File: Q:\GC002026\Fig6_Analytical Data.mxd	Date:	Figure:	6
	2/10/2014		

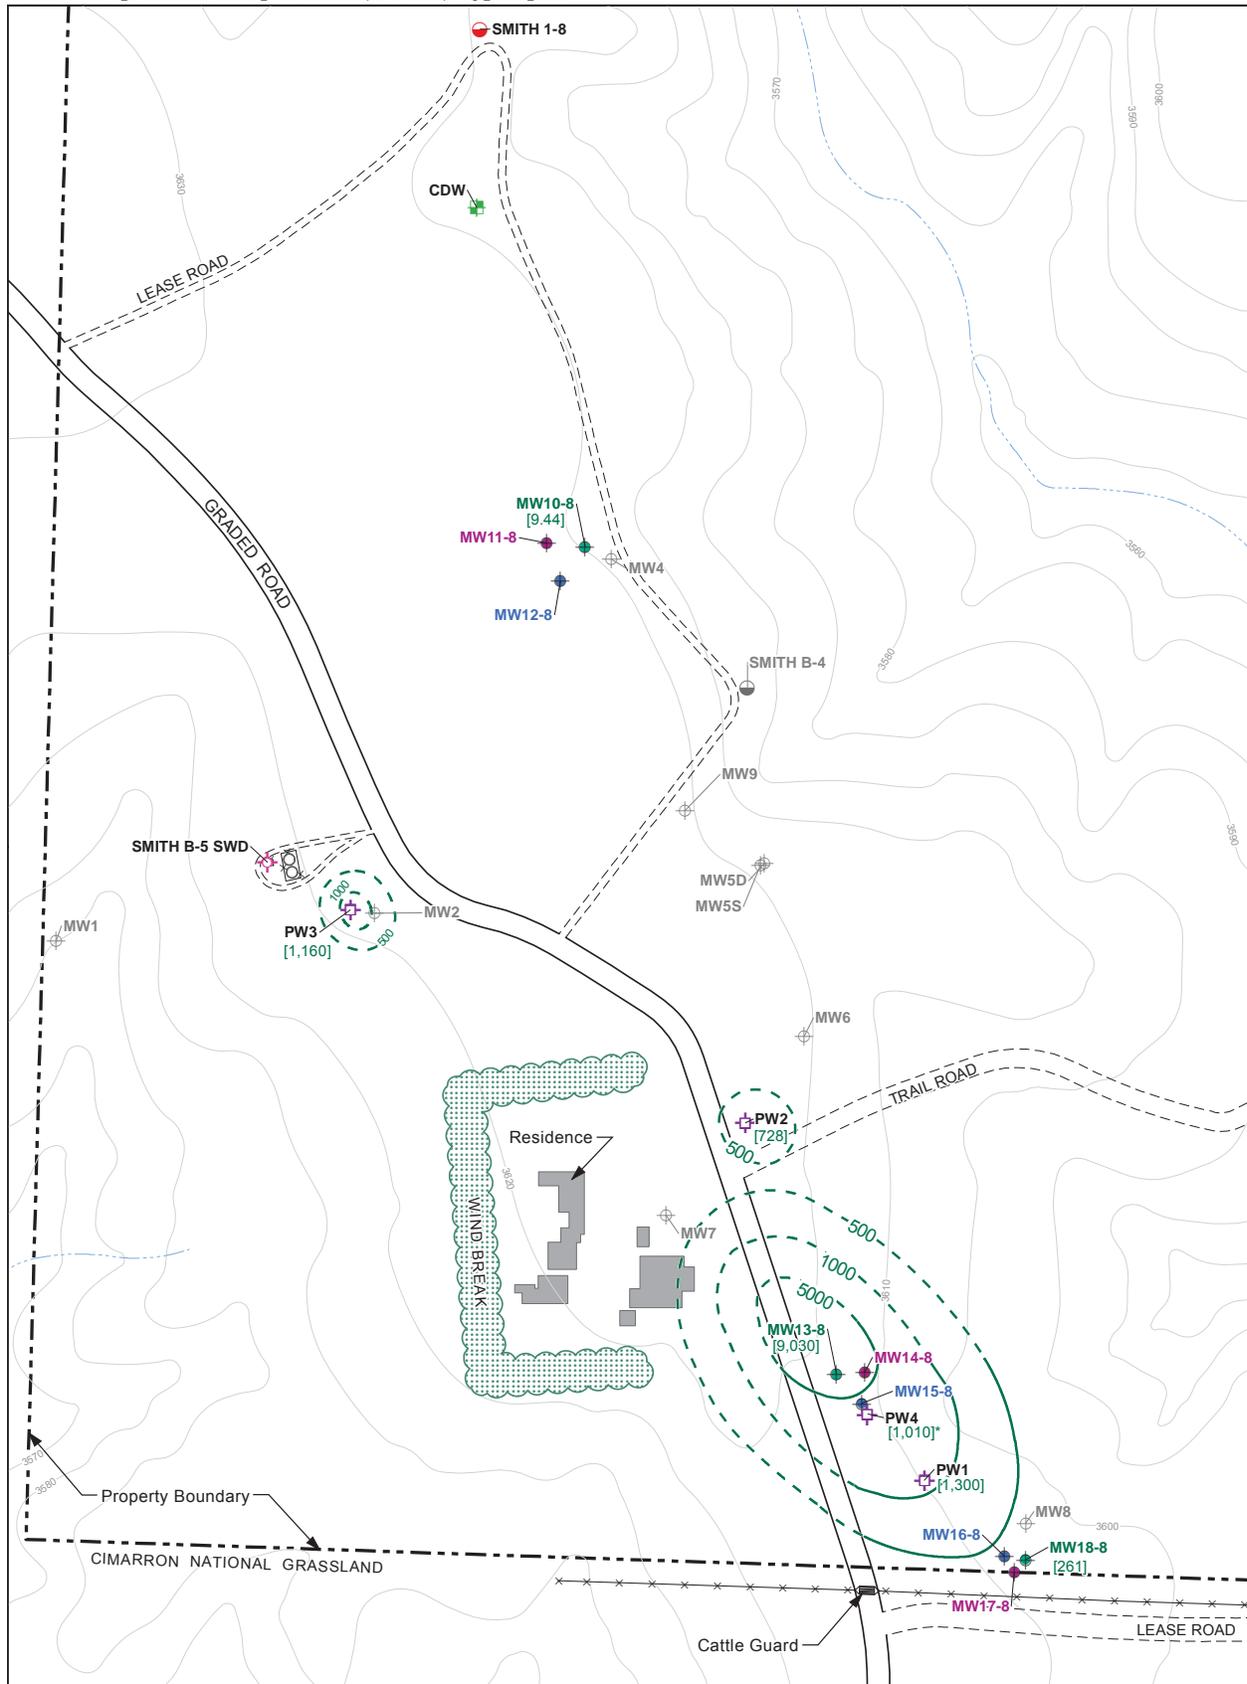

- LEGEND**
- Shallow Zone Monitoring Well
 - Intermediate Zone Monitoring Well
 - Deep Zone Monitoring Well
 - Plugged and Abandoned Monitoring Well
 - Current Domestic Well
 - Recovery Well
 - Salt Water Disposal Well
 - Oil & Gas Well
 - Plugged and Abandoned Oil & Gas Well


— 500 Chloride isoconcentration contour for shallow wells, dashed where inferred

[289] Shallow well chloride concentration (mg/L) Indicates sample was collected on August 27, 2013.


NOTE

- MW9 was plugged and abandoned on October 8, 2013.
- Extraction wells PW1 and PW2 screen both the shallow and intermediate zones. Extraction well PW3 and PW4 screen the shallow, intermediate, and deep zones.
- All values are in milligrams per liter (mg/L).

4. Chloride isoconcentration maps are interpreted from groundwater analytical results and the geophysical electrical resistivity survey.

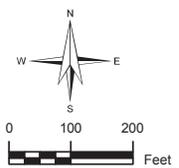

Prepared For:	Anadarko Petroleum Corporation		Designed:	PKQ
Title:	Chloride Isoconcentration Map for Shallow Wells November 2013		Drawn:	ME
	Smith Finn - Elkhart, Kansas		Checked:	DDZ
	2013 Annual Report	Morton County, Kansas	Revised:	NA
File: Q:\GC002026\Fig7_Chloride_SZ.mxd	Date:	2/10/2014	Figure:	7
ARCADIS				

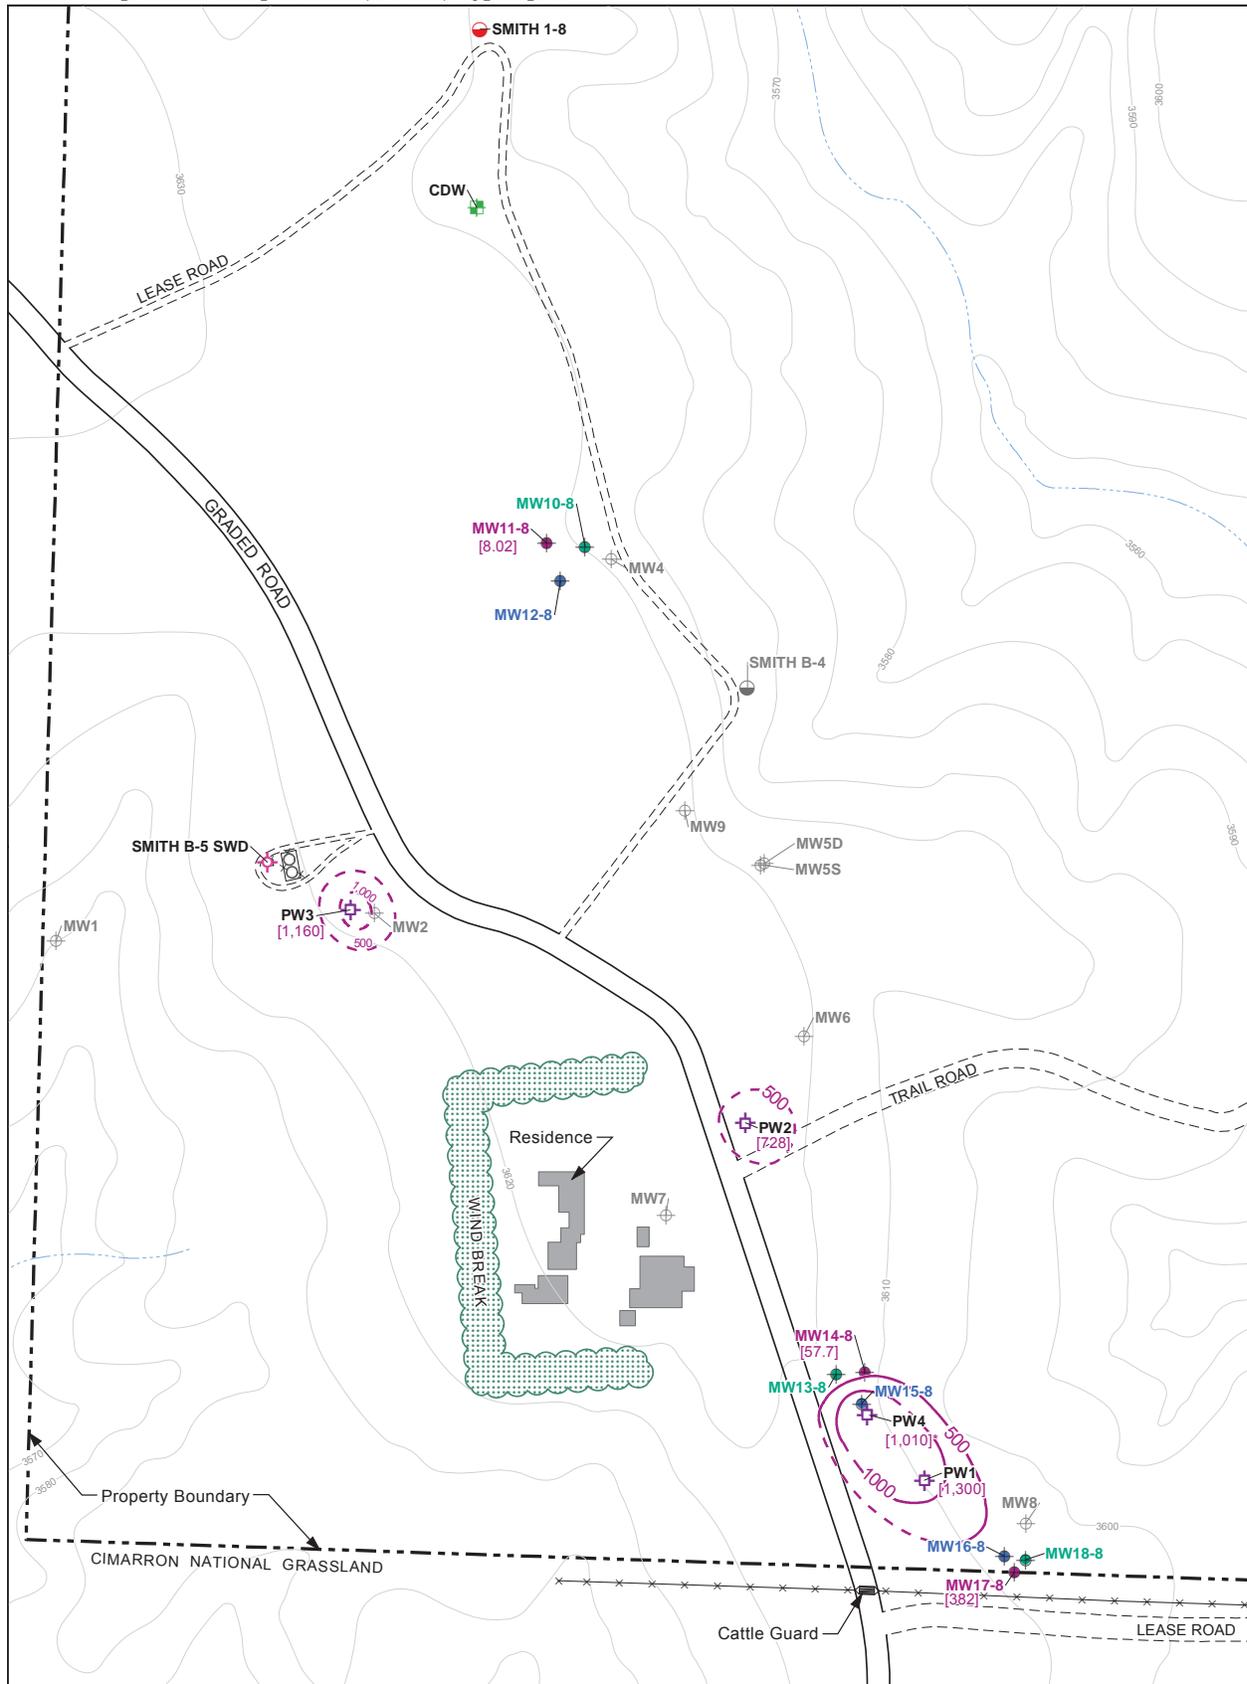

- LEGEND**
- Shallow Zone Monitoring Well
 - Intermediate Zone Monitoring Well
 - Deep Zone Monitoring Well
 - Plugged and Abandoned Monitoring Well
 - Current Domestic Well
 - Recovery Well
 - Salt Water Disposal Well
 - Oil & Gas Well
 - Plugged and Abandoned Oil & Gas Well

— 500 Chloride isoconcentration contour for intermediate wells, dashed where inferred


[137] Intermediate well chloride concentration (mg/L)

• Indicates sample was collected on August 27, 2013


NOTE

- MW9 was plugged and abandoned on October 8, 2013.
- Extraction wells PW1 and PW2 screen both the shallow and intermediate zones. Extraction well PW3 and PW4 screen the shallow, intermediate, and deep zones.
- All values are in milligrams per liter (mg/L).

4. Chloride isoconcentration maps are interpreted from groundwater analytical results and the geophysical electrical resistivity survey.

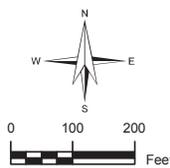

Prepared For:		Designed:	PKQ
Title:	Chloride Isoconcentration Map for Intermediate Wells November 2013	Drawn:	ME
	Smith Finn - Elkhart, Kansas	Checked:	DDZ
2013 Annual Report	Morton County, Kansas	Revised:	NA
File: Q:\GC002026\Fig8_Chloride_IJ.mxd	Date:	Figure:	8
	2/10/2014		

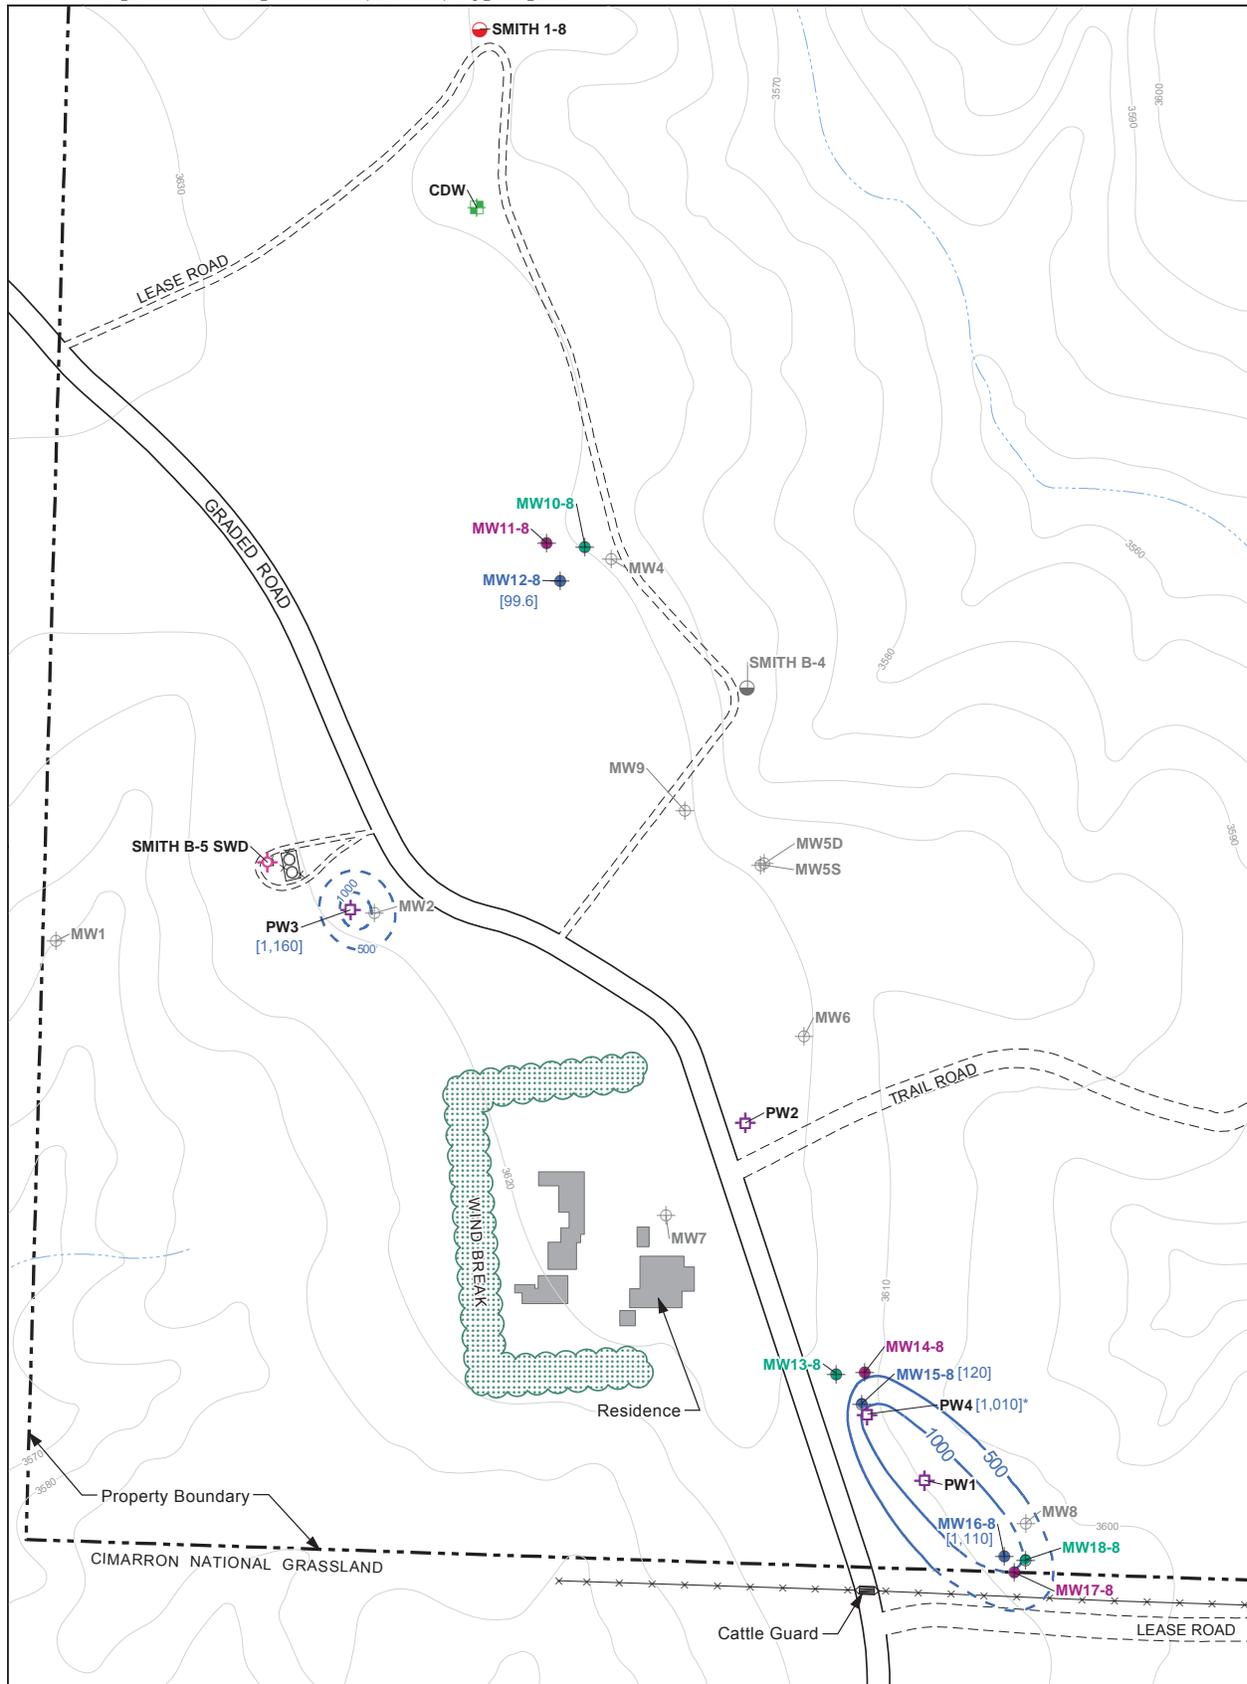

LEGEND

- Shallow Zone Monitoring Well
- Intermediate Zone Monitoring Well
- Deep Zone Monitoring Well
- Plugged and Abandoned Monitoring Well
- Current Domestic Well
- Recovery Well
- Salt Water Disposal Well
- Oil & Gas Well
- Plugged and Abandoned Oil & Gas Well

— 500 Chloride isoconcentration contour for deep wells, dashed where inferred


[784] Deep well chloride concentration (mg/L)

• Indicates sample was collected on August 27, 2013.

NOTE






1. MW9 was plugged and abandoned on October 8, 2013.
2. Extraction wells PW1 and PW2 screen both the shallow and intermediate zones. Extraction well PW3 and PW4 screen the shallow, intermediate, and deep zones.
3. All values are in milligrams per liter (mg/L).

4. Chloride isoconcentration maps are interpreted from groundwater analytical results and the geophysical electrical resistivity survey.

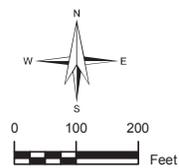

Prepared For:		Designed: PKQ
Chloride Isoconcentration Map for Deep Wells November 2013 Smith Finn - Elkhart, Kansas		Drawn: ME
		Checked: DDZ
2013 Annual Report	Morton County, Kansas	Revised: NA
File: Q:\GC002026\Fig9_Chloride_DZ.mxd	Date: 2/10/2014	Figure: 9

Figure 10
Recent Groundwater Elevation Trends

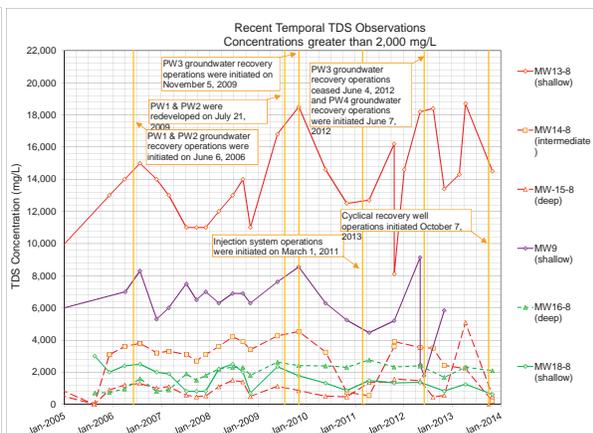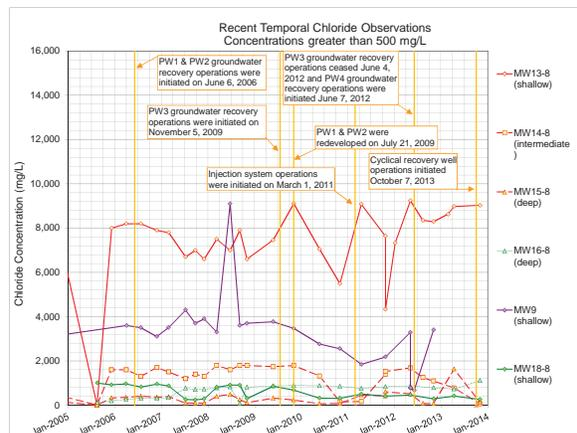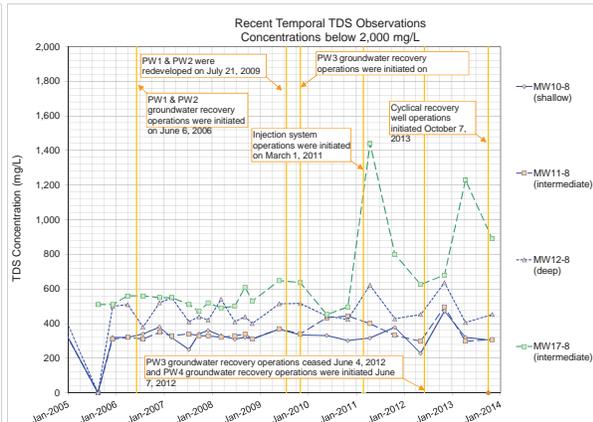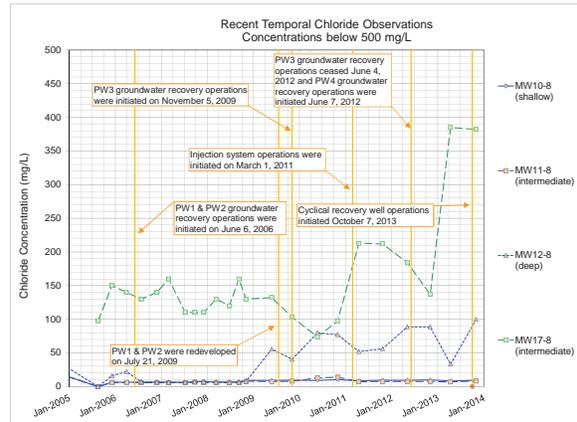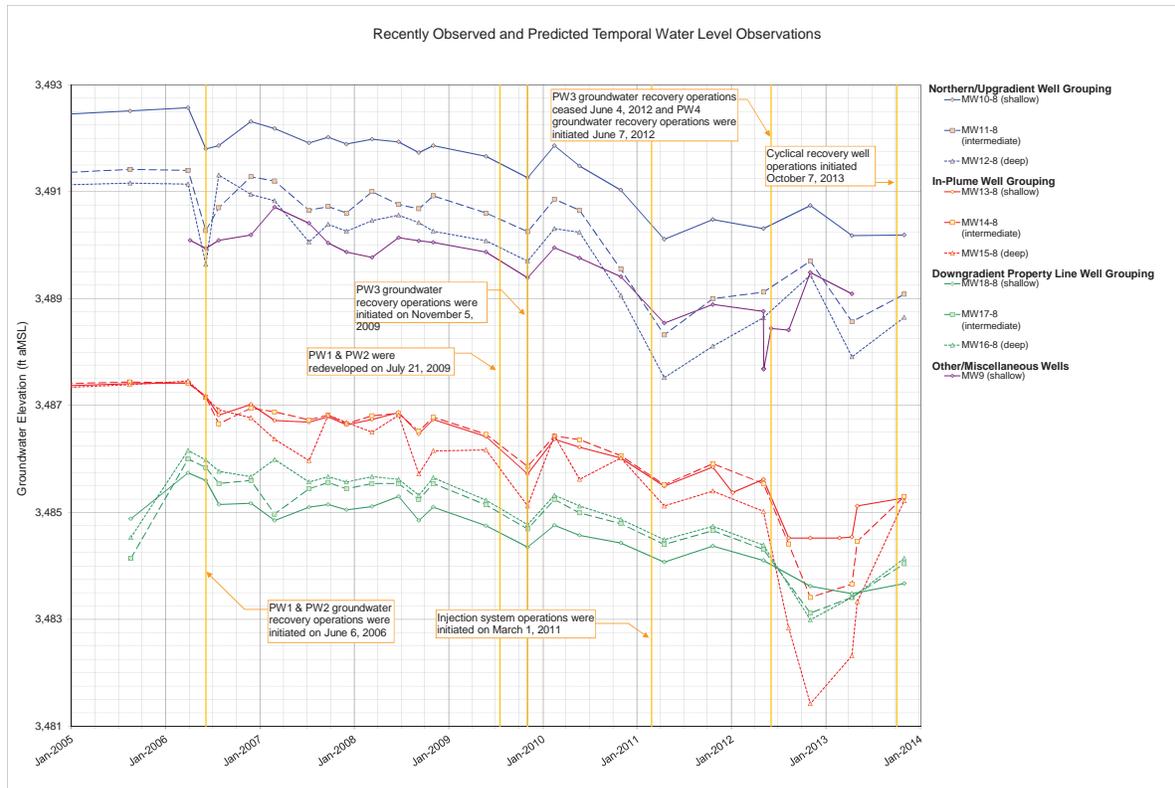

Project: South Spivey Contamination Site

Site Location: The site area is located 3.5 miles south of the city of Spivey, near an unnamed tributary of the Chikaskia River. The legal location is in Sections 27 and 34 of Township 30 South, Range 8 West, in Kingman County.

Impact: The impacts are to groundwater resources associated with local domestic wells. The site is rated as low immediacy level.

Site Description: The project area lies within an intermittently flowing creek bed within the large Spivey-Grabs oil and gas field. The area is remote and the surface use is primarily the grazing of cattle. The surface geology is composed of unconsolidated sand and silt. Underlying this upper layer are fine-grained sands and silts that form the aquifer. The aquifer delivers a small amount of water, but the fluid level is very shallow making the aquifer easily accessible. The depth to the first confining layer is roughly 9 to 12 feet. In December 1994 General Atlantic Resources implemented a remediation plan and began withdrawing contaminated groundwater in the SE quarter of section 27. Due to low water yields the recovery system was shut down in 2000 and the K.C.C. is doing post remediation monitoring.

Unusual problems: Withdrawal rate is low due to low permeability of aquifer.

Status of Project: The KCC has placed the South Spivey Site in an annual sampling program. Natural attenuation of the site is occurring but chloride readings have varied somewhat over the years with the annual precipitation amounts. The contaminated aquifer is so shallow chlorides levels seem to be in direct correlation with precipitation. The highest chloride concentration was from well A-2 and well OB with 1,300 ppm chlorides in 2014.

Level of Remediation Sought:

Ideal: 250 mg/l Chloride

Target: 750 mg/l Chloride


Recommendations for Future Work: Continue sampling all monitoring wells and surface waters on an annual basis. No other action is needed at this time.

Estimated Total Costs: \$1000 per year for sampling, testing, and research.


Control No.	Staff Hours/Expenditures	Fund Expenditures	
		FY 2014/15	Total
970096-00	46 Hrs. / \$1,158.30		
Current Contaminate Level: 10 mg/l to 1,300 mg/l Cl⁻			
Status:			
<input type="checkbox"/> 1. Site Assessment	<input type="checkbox"/> 2. Short Term Monitoring	<input type="checkbox"/> 3. Investigation	
<input checked="" type="checkbox"/> 4. Long Term Monitoring	<input type="checkbox"/> 5. Remediation Plan	<input type="checkbox"/> 6. Installation	
<input type="checkbox"/> 7. Remediation	<input type="checkbox"/> 8. Post Rem. Monitoring	<input type="checkbox"/> 9. Resolved	

R 8 W

T 30 S

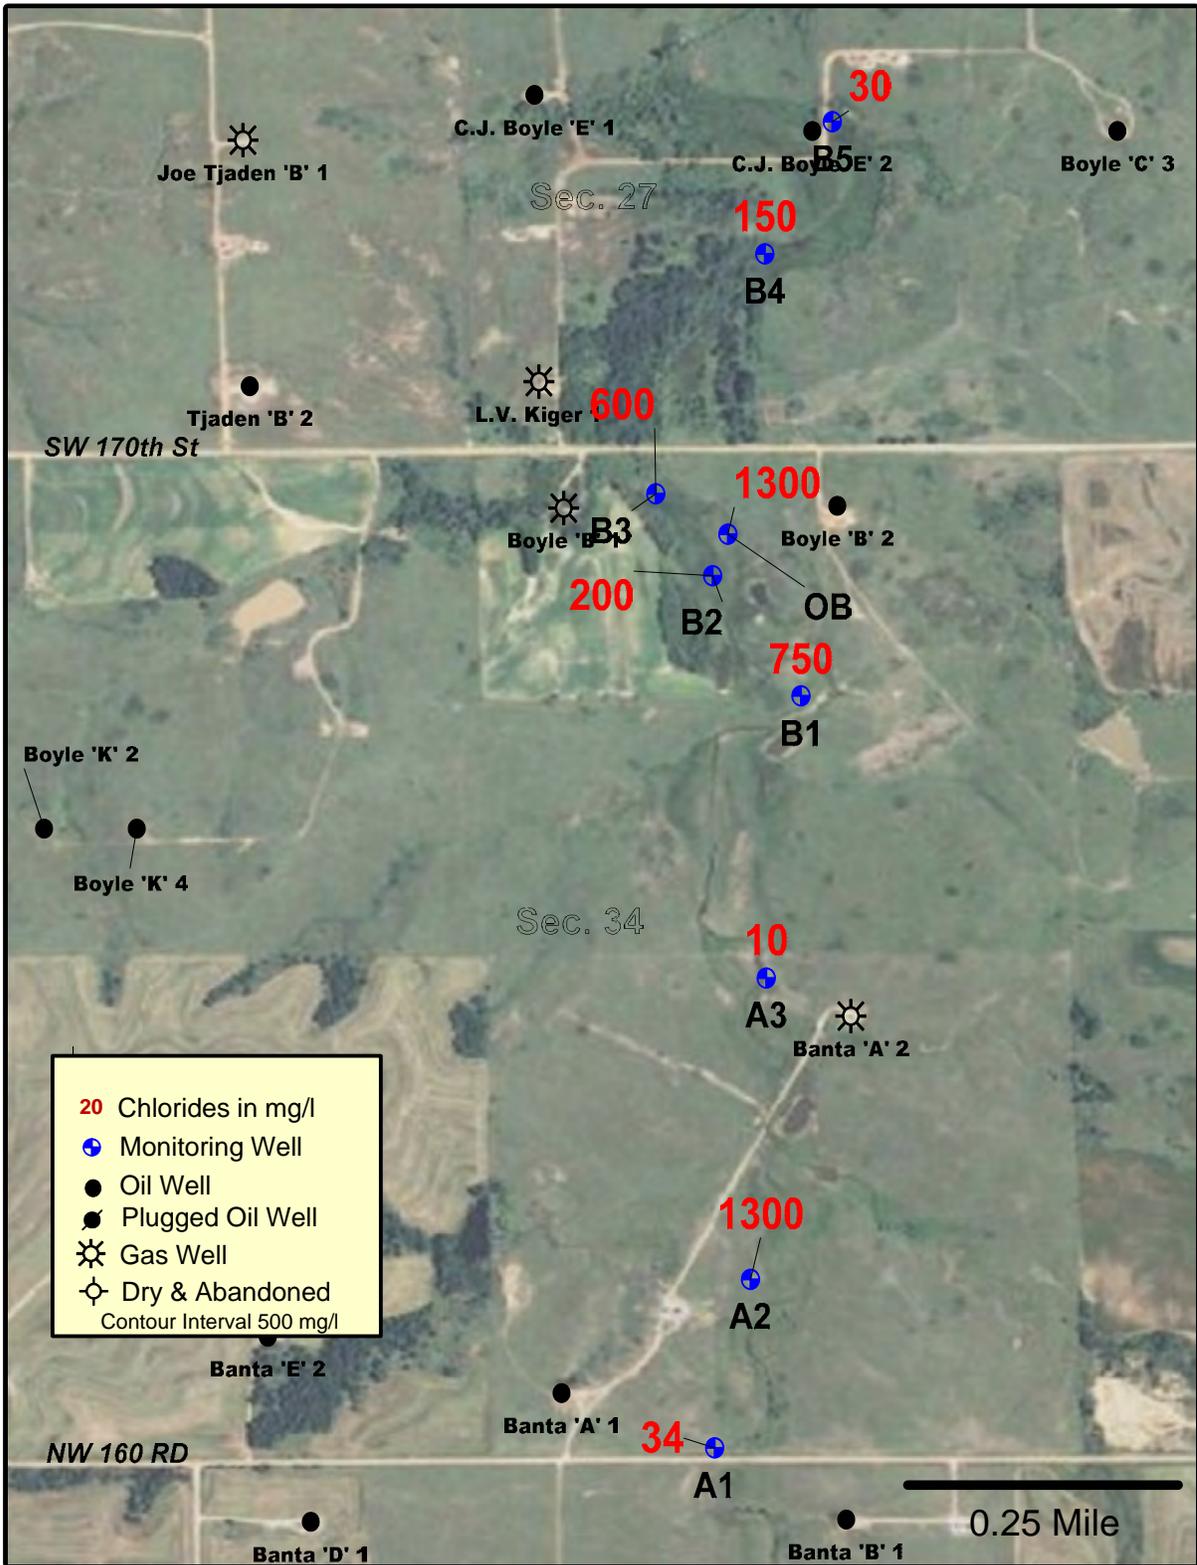

20	Chlorides in mg/l
⊕	Monitoring Well
●	Oil Well
●	Plugged Oil Well
☼	Gas Well
⊙	Dry & Abandoned
Contour Interval 500 mg/l	

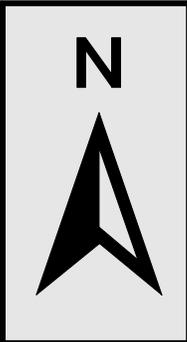

SOUTH SPIVEY SITE

Control No. 970096-00

2014-2015 Chloride Concentration Map

Section 27 & 34 - T30S -R8W, Kingman County

District #2 - B. Milner 9/29/14

Project: South Wichita Chloride Study

Site Location: The South Wichita site is located near the intersection of the Kansas Turnpike and the Wichita Valley Center Floodway. The site is centered roughly near the intersection of 63rd St. South and Broadway, in south Wichita. The legal location is as follows: Sections 28, 29, 31, 32, 33, and 34 of Township 28 South, Range 1 East and Sections 3 and 4 of Township 29 South, Range 1 East.

Impact: The past impacts or potential impacts are to irrigation, domestic and municipal water uses. A low level of immediacy is warranted for this site due to the low levels of Chlorides. The area has a very high demand for water resources.

Site Description: The project area consists of an attenuated groundwater plume created by oilfield brine moving in a southeasterly direction. The site is situated in an area that is residential, agricultural, commercial and light industrial many of which utilize the local groundwater aquifer for water. The surface geology is composed of unconsolidated sand and silt. Underlying this zone are sands and gravels that form the aquifer. Historically, the aquifer has delivered large quantities of variable quality drinking water. The depth of most of the domestic water wells in the area range from 30 to 50 feet.

Unusual Problems: Even after 20-plus years many of the public still remember and are interested in the brine pollution in the area. The site was originally discovered at the historically popular Blood Orchard which was ruined by brine contamination and the associated death of the fruit trees, which were never been brought back. The brine pollution has caused lingering hard feelings from many of the area residents.

Status of Project: This historical chloride plume from Blood Orchard has moved to the east-southeast at a very slow rate and has continued to decrease in chloride levels every year. Water levels averaged across the monitoring well matrix increased by 1.40 feet from last year. Chloride levels in 2014 have continued in the downward trend that we recorded in 2013 or are stable. The calculated approximate Hydraulic Gradient between Monitoring Well MW-801 and MW-401 is 0.001103161 ft/ft. Only monitoring well 11A was above the KDHE drinking water standard and KCC ideal level of 250 mg/l Chlorides.

Level of Remediation Sought:


Ideal: 250 mg/l Chloride

Target: 500 to 750 mg/l Chloride

Recommendations for Future Work: KCC District #2 has placed this site into a biannual sampling program. All but one well was tested to be in the ideal range for this last sampling year. The next sampling event is scheduled for the 2016-17 year. KCC will evaluate at that time the potential for closure of the site upon analyzing the results. Due to the huge public demand for water resources in the immediate area and the lingering but limited petroleum production, it is recommended that after closure that the monitoring well network should be shrunk but some wells maintained as a proactive measure in case of new or unforeseen saltwater contamination.

Estimated Total Costs: \$500 for staff time performing a drive by site check and preparing legislative report during the 2015-16 year.

Control No.	Staff Hours/Expenditures	Fund Expenditures	
		FY 2014/15	Total
970016-00	52 Hrs. / \$1,373.96		\$10,767.02
Current Contaminate Level: Highest level is 260 mg/l @ MW-11A			
Status:			
<input type="checkbox"/> 1. Site Assessment	<input type="checkbox"/> 2. Short Term Monitoring	<input type="checkbox"/> 3. Investigation	
<input checked="" type="checkbox"/> 4. Long Term Monitoring	<input type="checkbox"/> 5. Remediation Plan	<input type="checkbox"/> 6. Installation	
<input type="checkbox"/> 7. Remediation	<input type="checkbox"/> 8. Post Rem. Monitoring	<input type="checkbox"/> 9. Resolved	

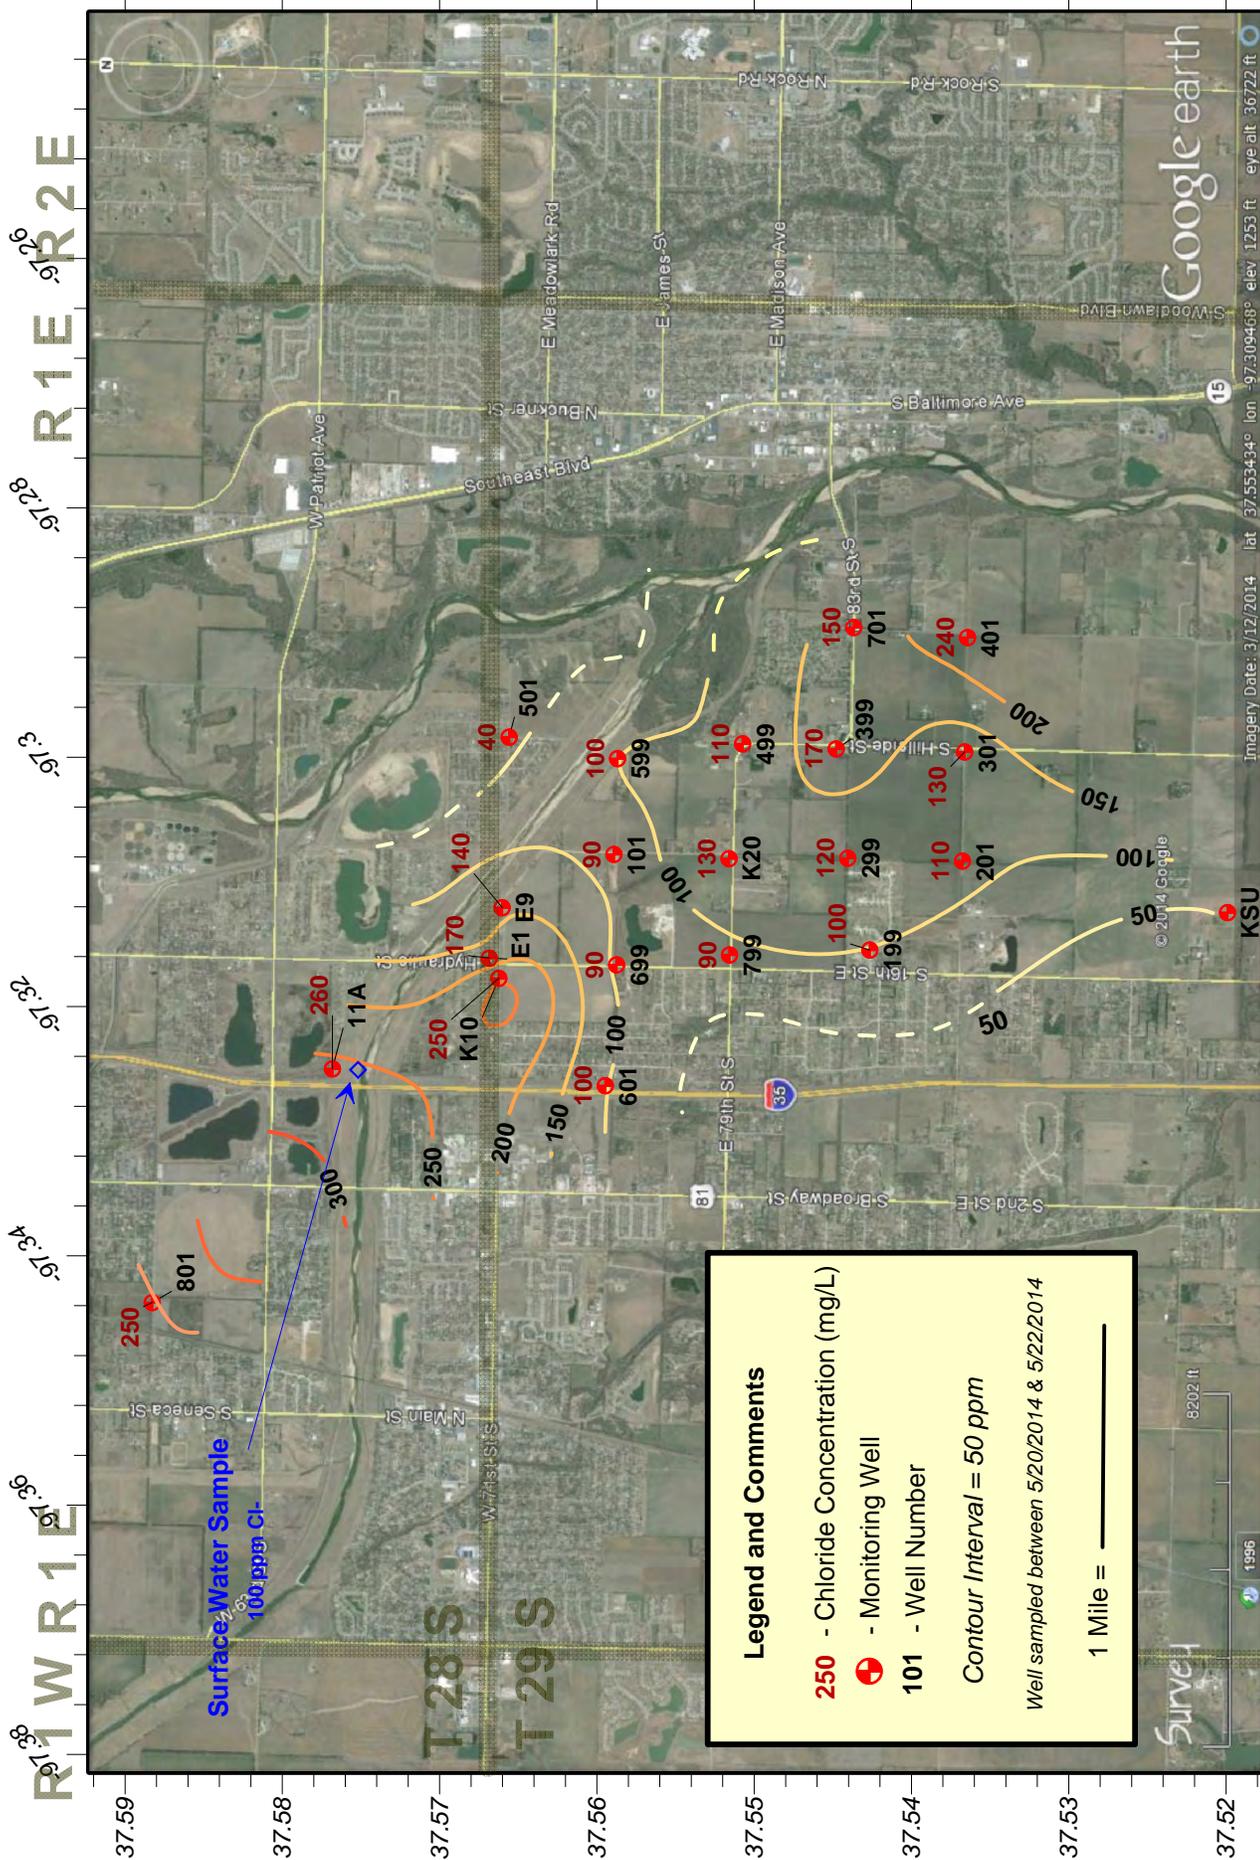

Legend and Comments

- 250** - Chloride Concentration (mg/L)
- Monitoring Well
- 101** - Well Number

Contour Interval = 50 ppm

Well sampled between 5/20/2014 & 5/22/2014

1 Mile = _____



South Wichita Contamination Site - #970016-00
Multiple Section of T28 & 29 S and R 1 E, Sedgwick County, Kansas
2014 Annual Groundwater Sampling Event - Chloride Concentrations
KCC District #2 - Drawn by: D. Bollenback on 9/29/2014

imagery Date: 3/12/2014 lat 37.553434° lon -97.309468° elev 1253 ft eye alt 36722 ft

Google earth

Survey123

Project: Stowe- Zaid Contamination Site

Site Location: The site is five miles south of the intersection of US 56 and Plume Street on the east side of Rice County. This site is in northwest part of Welch-Bornholdt oil field, and the lease has no production at the present time. The location is the SE/4 NE/4 Section 24, Township 20 South, Range 6 West, Rice County.

Impact/Immediacy: Impact is to the soil and groundwater. This site should be classified as low immediacy with the possibly of effecting domestic and stock wells and the aquifer of the Little Arkansas River. There is a rural water line in the area, which can provide service to the homes.

Site Description: Vegetation throughout the scar area has remained the same over the past years. Shallow groundwater levels and underflow are keeping the scar in place, as heavy rains might be pushing chlorides up onto the surface. The farmer planted soy beans on the land in 2014. There were large areas of scarred soil clearly visible during this visit. The Little Arkansas River is located half mile to the southwest of the site and that is the direction of the ground water flow, northeast to southwest. Investigations have shown that drilling pits and a tank battery could be the sources of the pollution.

Unusual Problems: The ground water table is very shallow due to the close proximity to the Arkansas River.

Status of the Project: The auger data from 2001 along with old aerial photos indicates the source area to be located northeast of the scar area. Up gradient and down gradient delineation has not been achieved to this date. The 2014 water sampling was done September 16, 2014. The lower aquifer tested at 160 mg/l chlorides. The upper water horizon was dry in shallow MW 1, so there is no data for MW-1S in this report. MW-2 at the toe of the scar tested slightly lower in 2014 at 1,000 mg/l. Evidence appears to show that an aquatard is preventing the chlorides from moving down to the lower aquifer.

Recommendation for Future Work: Continue to sample monitoring wells. Due to the shallow nature of the contaminated aquifer it maybe possible to recover chloride polluted water via shallow recovery wells or trench system, but there is no disposal scenario available near by to dispose of the fluids. In light of this fact long term monitoring is suggested for the site.


Level of Remediation Sought:

Ideal: 50 mg/l

Target: 350 mg/l

Estimated Total Costs: \$800 annually for field inspection and monitoring, and research into ideas/alternatives to remediating the site or at least expediting the attenuation.

Control No.	Staff Hours/Expenditures	Fund Expenditures	
		FY 2014/15	Total
20000035-001	14 Hrs. / \$374.94		\$4,057.85
Current Contaminate Level: 1,000 mg/l, MW #2, 9/16/2014			
160 mg/l Cl- Deep Aquifer 9/16/2014			
Status:			
<input type="checkbox"/> 1. Site Assessment	<input type="checkbox"/> 2. Short Term Monitoring	<input type="checkbox"/> 3. Investigation	
<input checked="" type="checkbox"/> 4. Long Term Monitoring	<input type="checkbox"/> 5. Remediation Plan	<input type="checkbox"/> 6. Installation	
<input type="checkbox"/> 7. Remediation	<input type="checkbox"/> 8. Post Rem. Monitoring	<input type="checkbox"/> 9. Resolved	

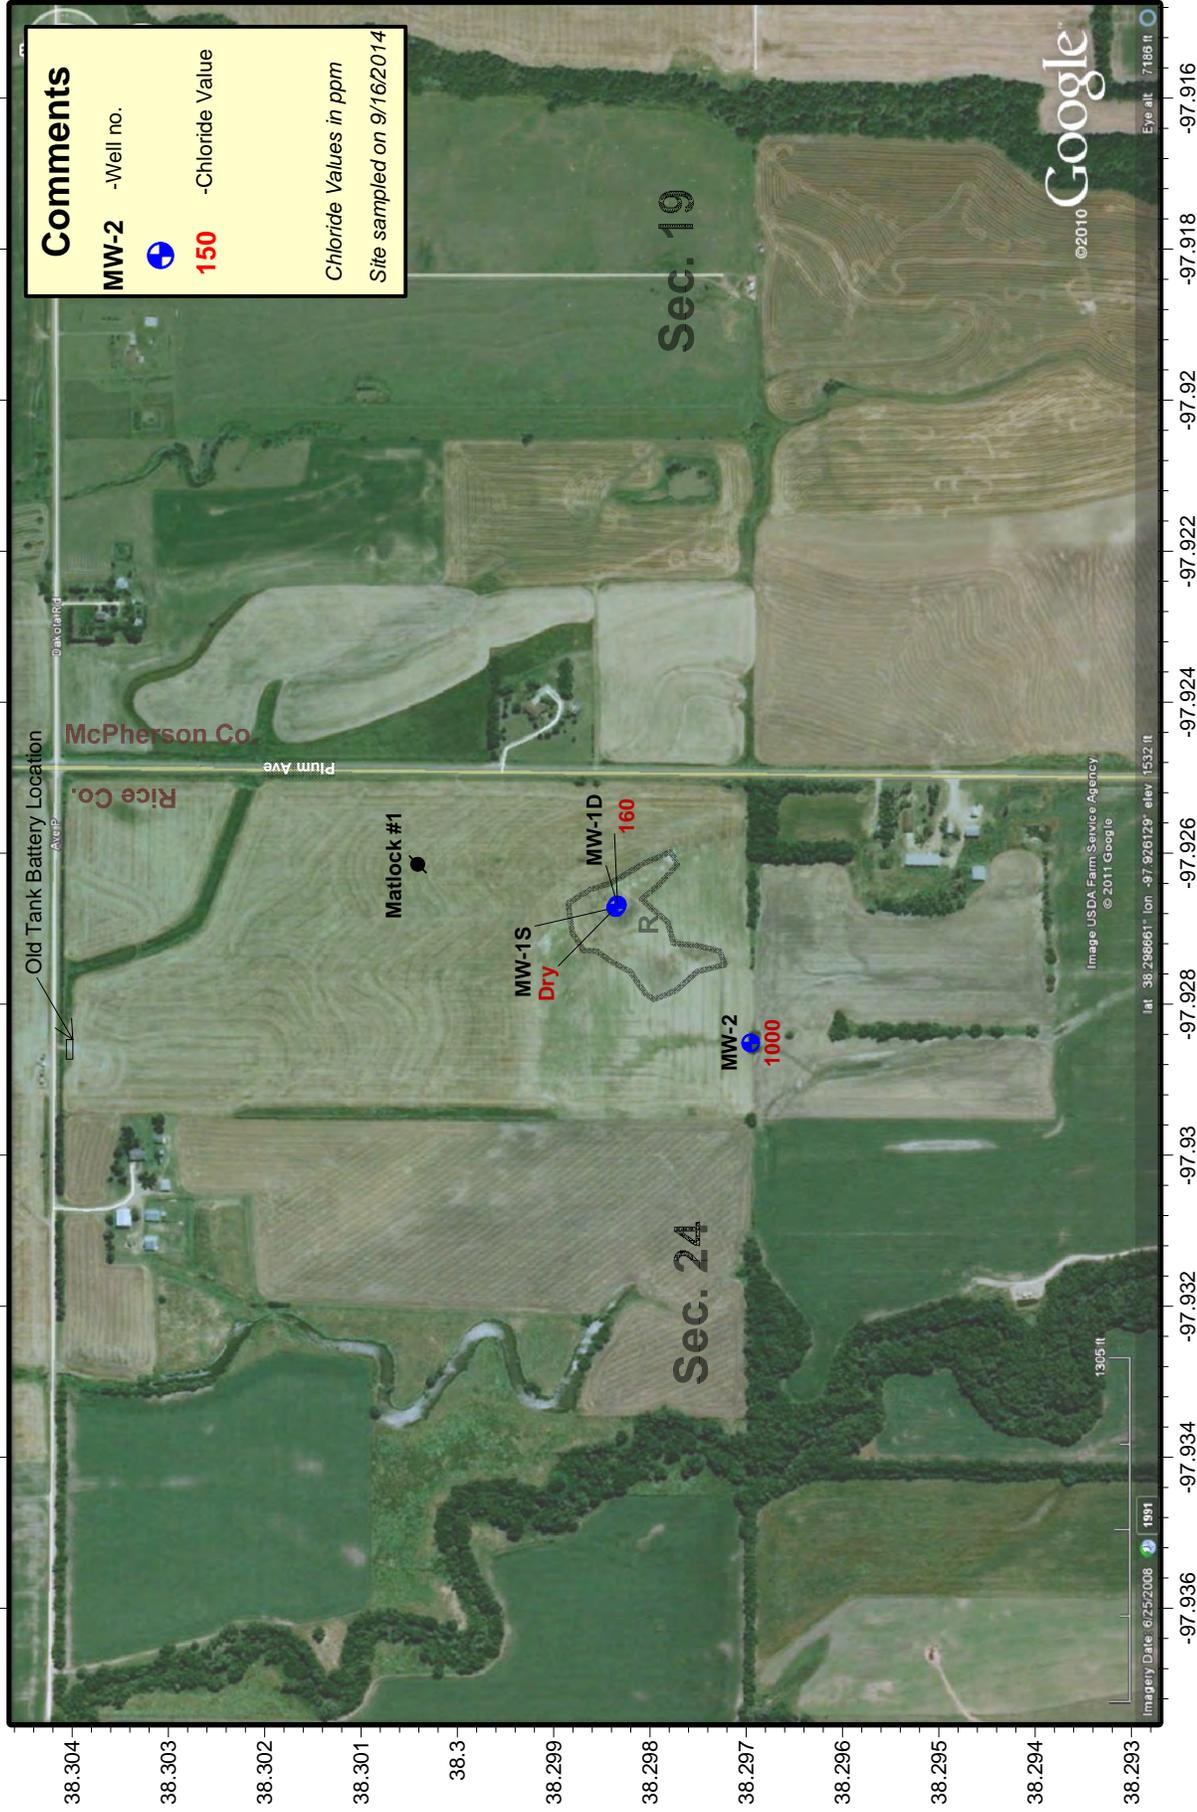



Kansas
Corporation Commission



Stowie-Zaid Contamination Site
NE - Sec. 24 - T 20 S - R 6 W, Rice County, Kansas
2014-15 Chloride Concentrations
KCC Code #20000035-001 - District #2 - D. Bollenback - 11/17/2014

Project: Trostle Contamination Site

Site Location: The site area is 2.3 miles west and 2.75 miles south of the town of Murdock, Kansas. The legal description is northeastern quarter of section 33, Township 28 South, and Range 6 West of Kingman County, Kansas. The site is in the drainage systems of Sand Creek which is located 1 mile north of the site. Sand Creek is a tributary of the South Fork Ninnescah River.

Impact/Immediacy: The high chlorides will impact the ground water affecting stock wells in the immediate area, as well as low lying draws which are usually dry, but containing water with high chlorides after a rainfall. The aquifer is very low yielding. There are erosion effects to the terrain where there is no vegetation. Site is classified as low immediacy.

Site Description: The area most affected is around the Trostle salt-water disposal well. There are seven monitoring wells below the Trostle salt-water disposal well that also have elevated chlorides. The most likely cause was something related to the salt-water tank such as discharges. This site was historically remediated via an interceptor trench but the system was abandoned after the holding tanks failed and the site was placed into the monitoring phase of investigation. There has only been one reported spill at the SWDW since 2005. Local hydrology is a perched aquifer system. Precipitation that infiltrated the Pleistocene Alluvium moves downward until it hit the impermeable red Ninnescah shale. Groundwater then flows down gradient on top of the shale. The general movement of fluids in the perched water table flows to the northwest.

Unusual Problems: None.

Status of Project: On June 17, 2014, eleven groundwater monitoring wells were sampled. A polyethylene disposable bailer was used to attempt purge a minimum of three well volumes of groundwater from each well before sampling. Almost all wells bailed dry before 3 well volumes could be purged, and those wells were sampled after recharge had taken place. Purge water was tested for conductivity and contained in a 250 gallon poly-tank if conductivity was high. All contained water was disposed into an authorized SWDW. Groundwater samples from each monitoring well were collected in one 250 (ml) polyurethane container for analysis at the KCC District #2 Laboratory. Each sample for this monitoring event was analyzed for the presence of Chloride by United States Environmental Protection Agency USEPA Silver Nitrate Buret Titration Method - Method 8225

The data resulting from the June 2014 groundwater sampling event show a marked increase in chlorides in MW-1, MW-2, MW-3, MW-4, MW-5, and MW-10. There was a marked decrease in MW-8. All other monitoring wells were similar levels to 2013.

Level of Remediation Sought:

Ideal: 250 mg/l Chloride

Target: 500 mg/l Chloride

Recommendations for Future Work: The KCC will sample all monitoring wells and the two surface water locations over the 2015-16 year in continuance of the current monitoring phase of this site. Due to the increased chlorides near the SWDW tank battery an investigation into a possible new source of brine contamination should be conducted. KCC will put together a scope of limited Geoprobe borings to investigate around the tank battery.

Estimated Long Term Cost: The estimated cost to the KCC will be \$800 per year for inspection of site, running an analysis of the water, and data and report preparation. A limited boring investigation would cost in the range of \$1500-3000.

Control No.	Staff Hours/Expenditures	Fund Expenditures	
		FY 2014/15	Total
980038-001	13 Hrs. / \$348.65		
Current Contaminate Level: 110 mg/l in MW-6 to 15,000 mg/l chlorides in MW-1			
Status:			
<input type="checkbox"/> 1. Site Assessment	<input type="checkbox"/> 2. Short Term Monitoring	<input checked="" type="checkbox"/> 3. Investigation	
<input checked="" type="checkbox"/> 4. Long Term Monitoring	<input type="checkbox"/> 5. Remediation Plan	<input type="checkbox"/> 6. Installation	
<input type="checkbox"/> 7. Remediation	<input type="checkbox"/> 8. Post Rem. Monitoring	<input type="checkbox"/> 9. Resolved	

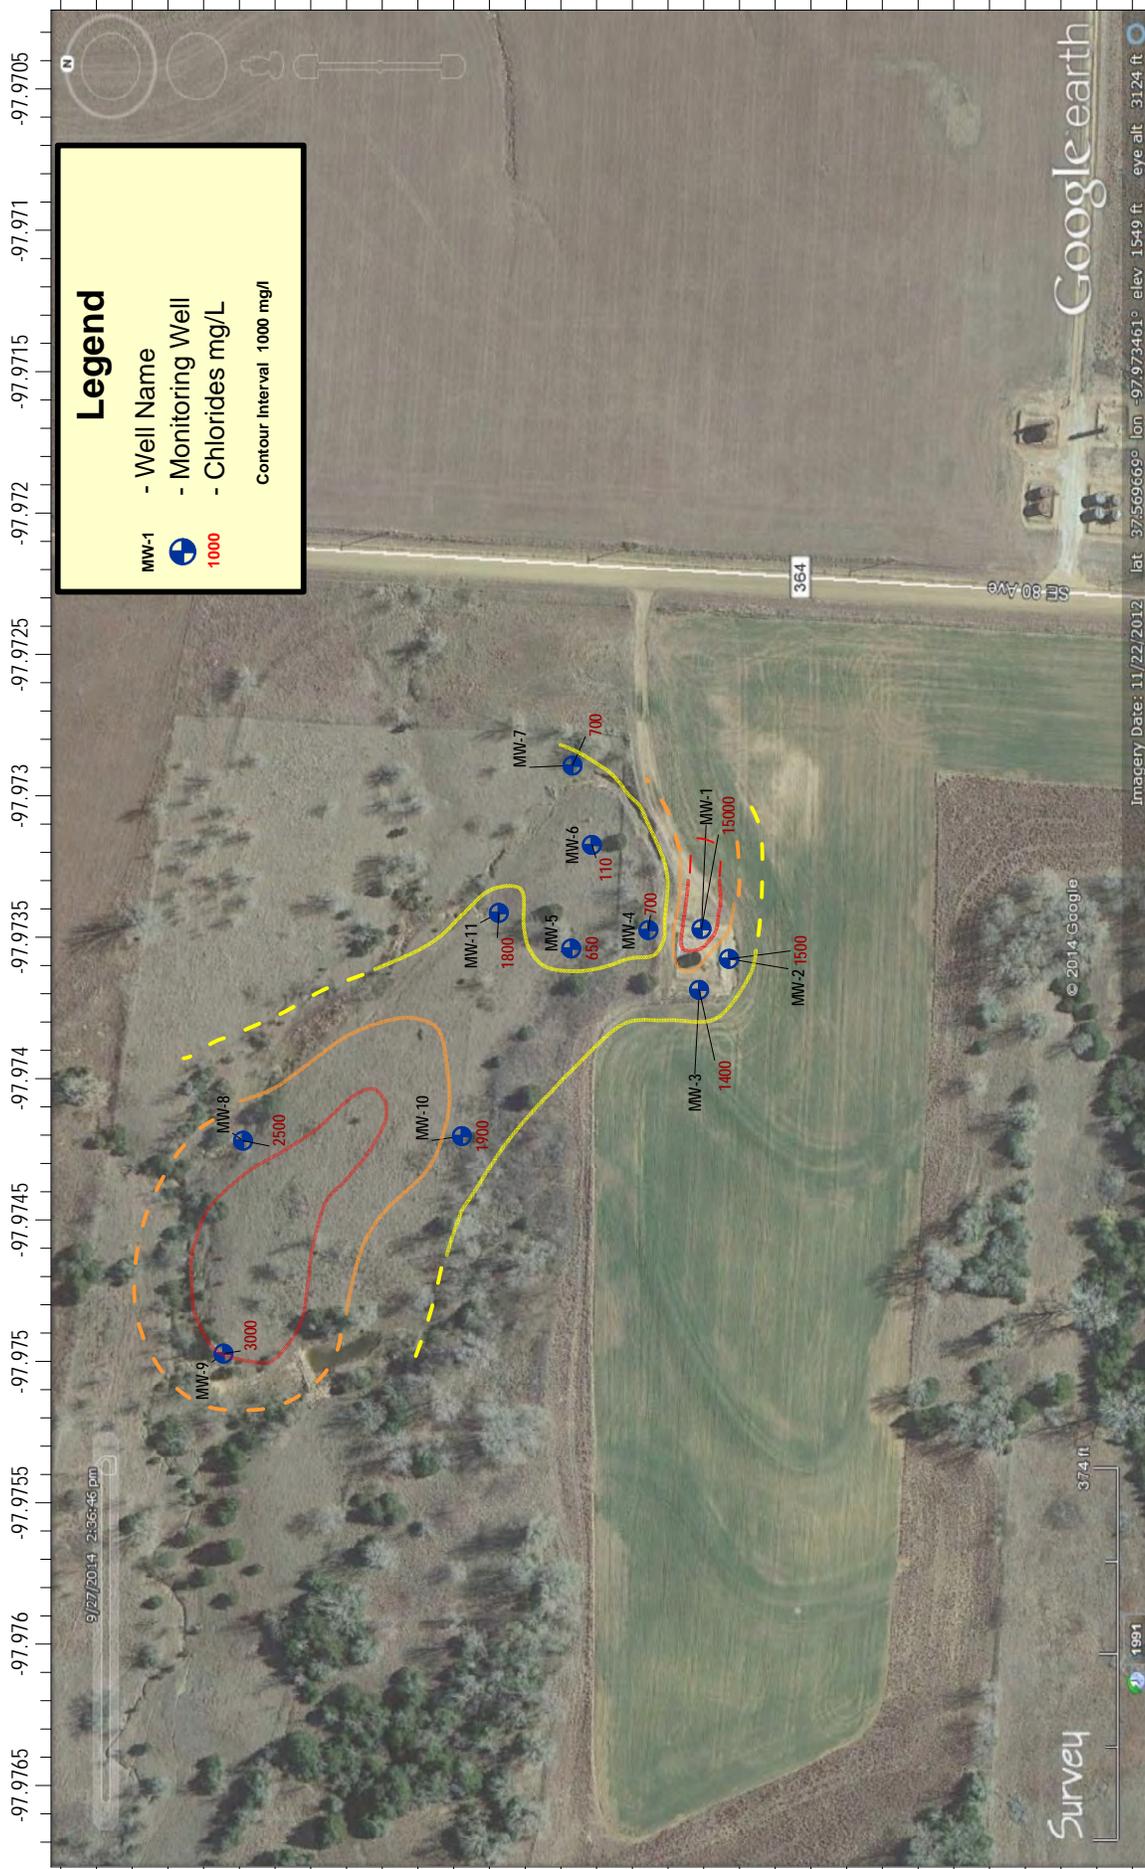


Figure 1

Trostle Post-remediation and Monitoring Site

2014 Groundwater Sampling - Chloride Concentration Isopact

Section 33 of T28S and R6W, Kingman County, Kansas

KCC Control Number: #980038-001 - Wells sampled on 6/17/2014 - Map Drawn 10/10/2014 by D.Bollenback

Project: Voshell Site

Site Location: The Voshell site includes a portion of the Voshell Oil Field, and a large area between Elyria and Moundridge, Kansas. Parts of Townships 20 and 21 South and Ranges 2 and 3 West are within the Site boundaries.

Impact/Immediacy: Impact is to the shallow Equus Beds underlying the Voshell Oil Field, which has been affected by elevated chloride levels. Resources impacted include domestic and irrigation wells. The site is classified as moderate immediacy level.

Site Description: The land surface is flat irrigated farmland, which is dissected by Dry Turkey Creek and Running Turkey Creek. The aquifer ranges in thickness from eighty feet in the east of the site area to approximately two hundred feet in the west. The axis of the relatively thick McPherson channel can be mapped from the center of Section 31, T21S, R3W to the NW corner of Section 19 to the center of Section 5, and then northward from that point. The aquifer appears to contain several aquitards, which may or may not be continuous throughout the area.

Unusual Problems: Movement of the chloride plume toward irrigation wells has been somewhat accelerated by the effect of well pumping. The plume will continue to migrate toward the McPherson channel located to the west of the Voshell Oil Field as long as there is deep pumping of the Equus Bed aquifer. New irrigations wells are drilled every year in the immediate area, and can cause erratic hydraulic movements of the plumes.

Status of the Project: In May of 2004, a cooperative agreement between the Kansas Corporation Commission (KCC) and the Equus Beds Groundwater Management District No. 2 (GMD 2) was entered into for the drilling of 10 groundwater monitoring wells in the Voshell oil field. The GMD 2 is responsible for water sampling and providing water quality data to the KCC of those wells. The initial seven wells were drilled north to south through the project area, and were drilled down to the Wellington shale bedrock. Approximately 21 wells associated with the Running Turkey Creek site monitored by the KCC have been moved under the control number of the Voshell site since 2012.

The KCC wells were sampled by KCC District #2 staff in October of 2014. There are multiple wells that are in need of repair or need to be plugged due to age or damage. Due to a malfunction of the air lift manifold many of the southern wells were hand bailed instead of air purged. KCC believes that change in purge method is the reason for lower chloride values in the high chloride wells. The known plumes appear to be slowly moving to the southwest. KCC has begun water record research into the area west of the site during the 2014 year.

Level of Remediation Sought:


Ideal: 250 ppm Chloride

Target: 500 ppm Chloride

Recommendation for Future Work: KCC plans to plug and/or repair all wells needing remedial work. KCC has discussed with GMD #2 adding additional monitoring wells west of the line of GMD wells on the west edge of the site. KCC and GMD could join resources in achieving this. Some detail delineating within the site boundaries are also recommended especially near the high chloride plume within the Voshell Oil Field. KCC will put together a scope of work in order to initiate this work. KCC recommends continued monitoring of this site.

Estimated Total Costs: Cost of funding field work on repairs and sampling might be as much as \$700-1000. Office research into the expansion of the well matrix will cost in staff time only. Funding provided by the KCC for this monitoring program will not exceed \$20,000 without written mutual agreement of both parties. KCC believes a cost estimate of \$20,000-30,000 dollars will be needed for the installation of new monitoring wells to delineate the site.

Control No.	Staff Hours/Expenditures	Fund Expenditures	
		FY 2014/15	Total
20030059-001	30 Hrs. / \$795.58	\$302.12	\$19,276.56
Current Contaminate Level: MW-105 - 4,500 mg/l.			
Status:			
<input type="checkbox"/> 1. Site Assessment	<input type="checkbox"/> 2. Short Term Monitoring	<input checked="" type="checkbox"/> 3. Investigation	
<input checked="" type="checkbox"/> 4. Long Term Monitoring	<input type="checkbox"/> 5. Remediation Plan	<input type="checkbox"/> 6. Installation	
<input type="checkbox"/> 7. Remediation	<input type="checkbox"/> 8. Post Rem. Monitoring	<input type="checkbox"/> 9. Resolved	

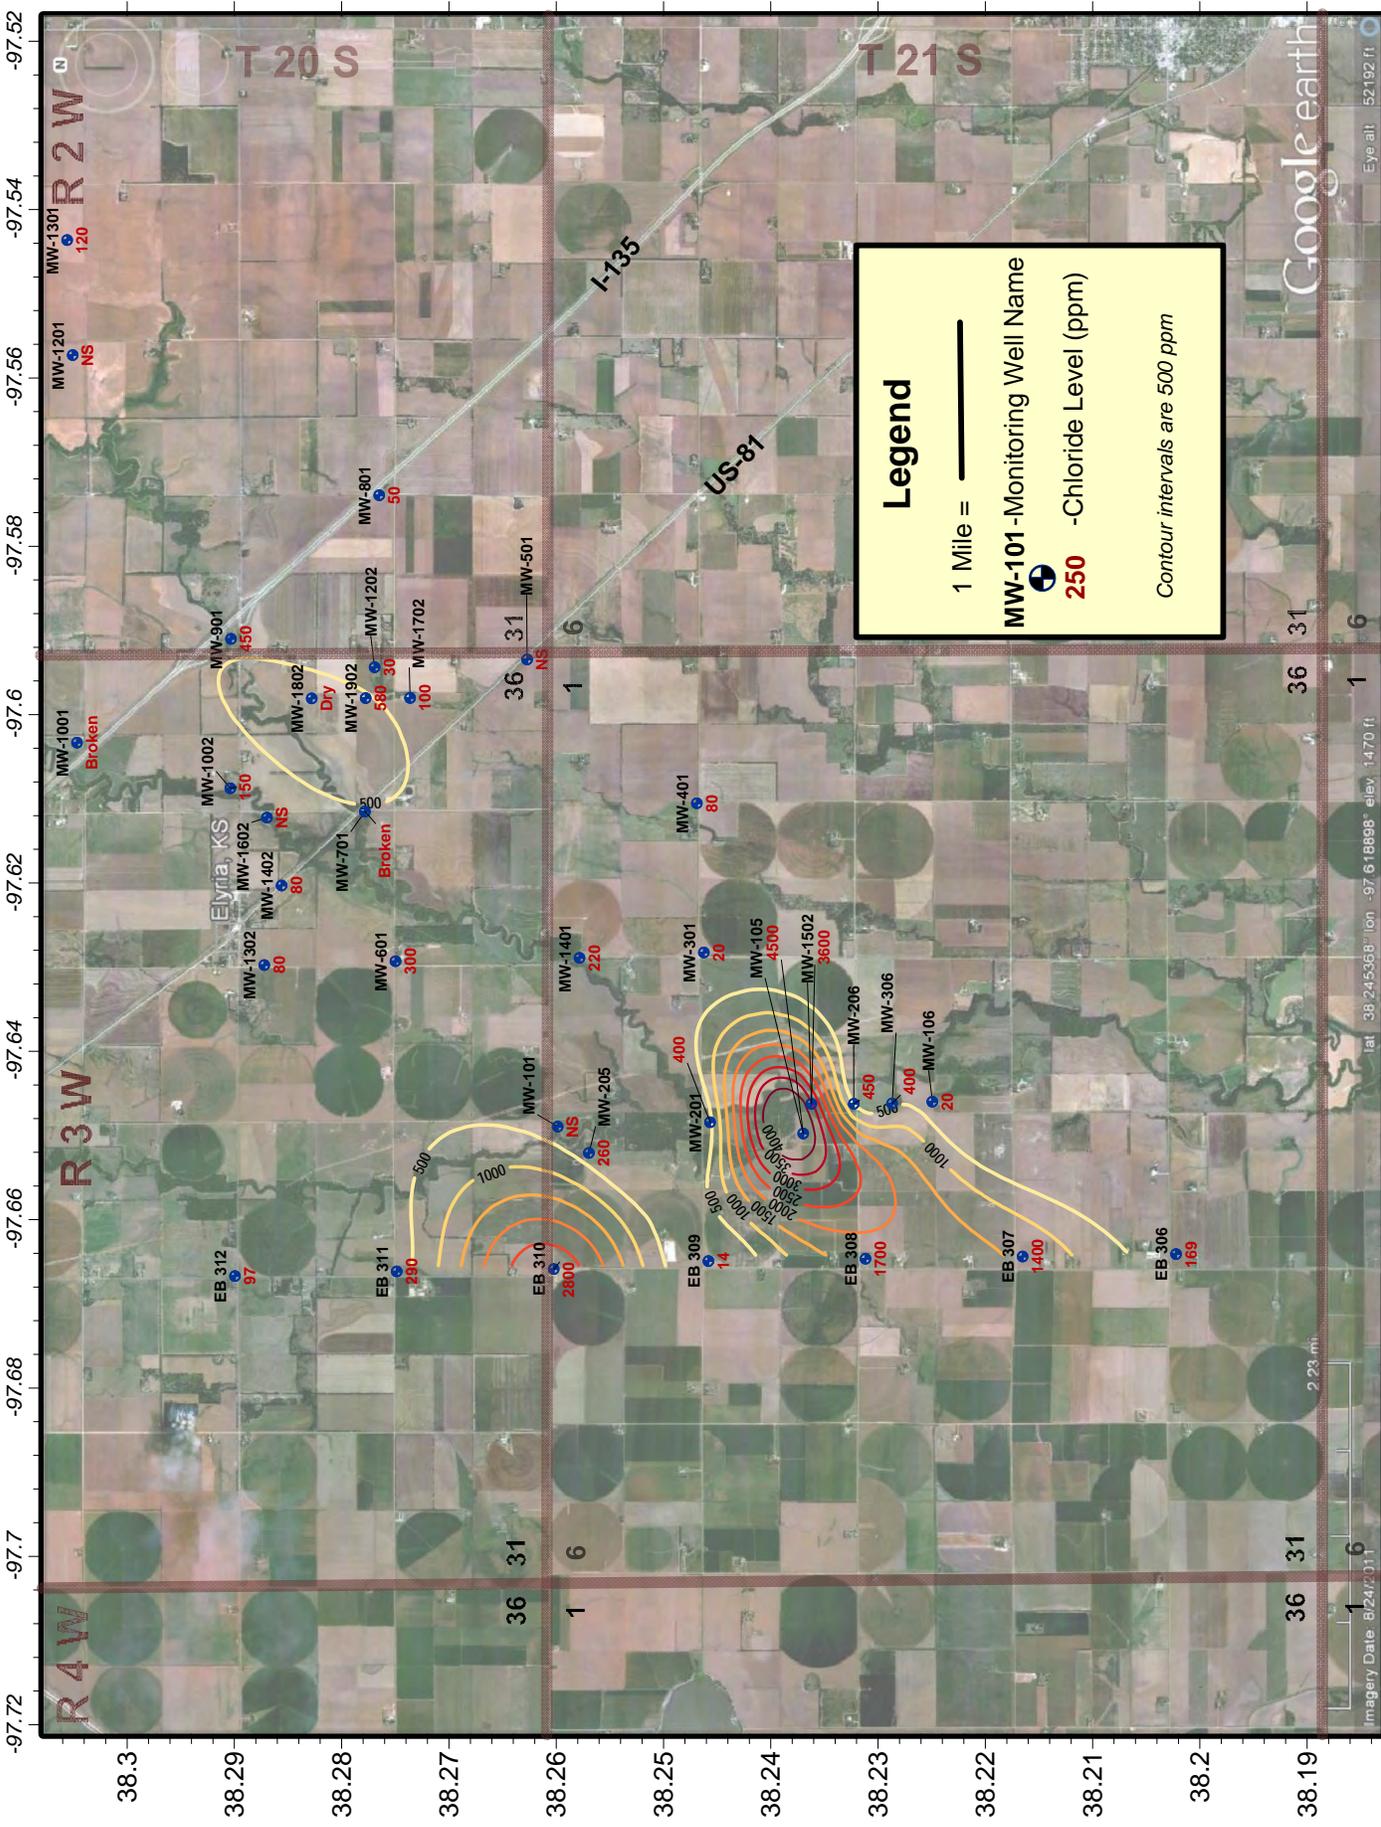

Legend

1 Mile =

MW-101 - Monitoring Well Name

250 - Chloride Level (ppm)

Contour intervals are 500 ppm

Voshell Contamination Site
 Multiple Section of Townships 20 & 21 South and Range 2 & 3 West, McPherson County, Kansas
2013 Groundwater Chloride Levels Map
 District #2 - Control Number #20030059-001 - Sampled in October 2014 - Drawn on 11/21/2014 by D.Bollenback



Google earth
 Eye alt: 52192 ft
 lat: 38.245368° lon: -97.618898° elev: 1470 ft
 Imagery Date: 8/24/2011
 2.23 mi

Project: *Wildboy's Land & Cattle Contamination Site*

Site Location: Legal location is NE/4 of Section 28, Township 33 South, Range 11 West, Barber County, 9 miles S of Medicine Lodge on Hwy 281, 1E, 1S, 1E into farmstead.

Impact/Immediacy: The impact is to the groundwater and surface water of the area. Immediacy level is rated at moderate to high.

Site Description: The site is located within the Medicine Lodge River Valley.

Unusual Problems: None.

Status of Project: During 2014, a total of five samples were taken, three from monitoring wells and two from stock wells. The oil field supply well could not be sampled this year. In general, the chlorides at this site have been quite variable. Since the last sampling event in 2014, chlorides have been relatively higher. Current chlorides at the site are between 660 ppm in the western most stock well, and 5000ppm in MW-3. Current number of monitoring wells does not provide adequate coverage of the plume in order to evaluate the extent to the south and southeast.

Level of Chloride Sought:


Ideal: 250 ppm Chloride

Target: 500 ppm Chloride

Recommendations for Future Work: Additional monitoring wells or temporary sampling points (auger holes) should be added to the site in order to evaluate the extent of the plume to the east and southeast. The site will be assessed to determine where additional sample points are needed, and for the installation of a permanent down gradient monitoring well. Should chloride levels change significantly in future sampling, implementation of a remedial system will be investigated.

Estimated Total Cost: Installation of recovery system and disposal facility with long term monitoring. Costs associated with the installation of the disposal well are attached to the Harbaugh site.

Control No.	Staff Hours/Expenditures	Fund Expenditures	
		FY 2014/15	Total
970017-00	4.5 Hrs. / \$125.19	See Harbaugh	
Current Contaminate Level: 660 ppm Cl- to 5000 ppm Cl-			
Status:			
<input checked="" type="checkbox"/> 1. Site Assessment	<input type="checkbox"/> 2. Short Term Monitoring	<input type="checkbox"/> 3. Investigation	
<input checked="" type="checkbox"/> 4. Long Term Monitoring	<input type="checkbox"/> 5. Remediation Plan	<input type="checkbox"/> 6. Installation	
<input type="checkbox"/> 7. Remediation	<input type="checkbox"/> 8. Post Rem. Monitoring	<input type="checkbox"/> 9. Resolved	

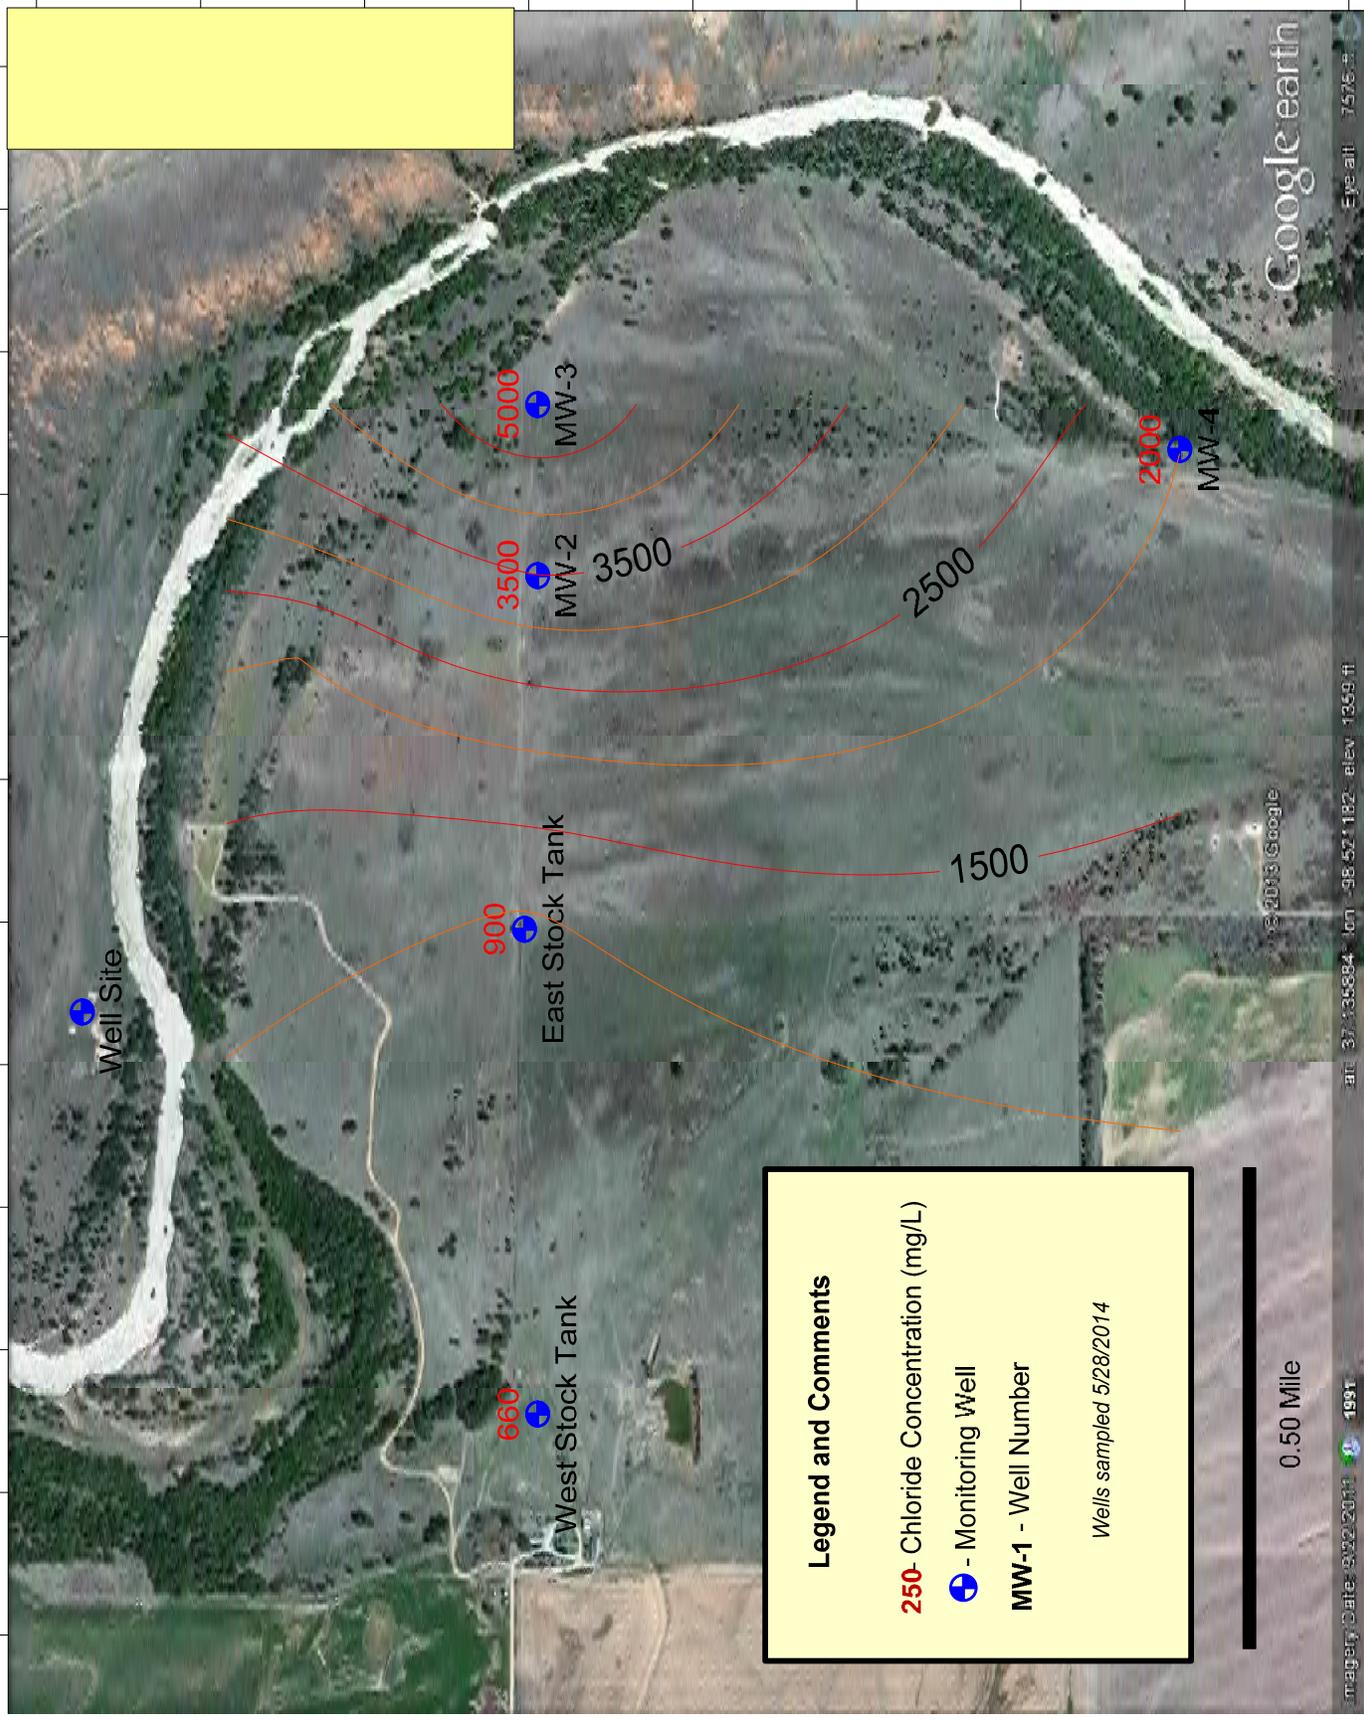

Google earth

imagery Date: 8/22/2011 1991
 at: 37.135884, lon: -98.521182, elev: 1359 ft
 Eye alt: 7576 ft

Legend and Comments

250- Chloride Concentration (mg/L)

● - Monitoring Well

MW-1 - Well Number

Wells sampled 5/28/2014

0.50 Mile

Wildboys Site
2013-2014 Area Map with Chlorides
 Sections 28/33-T-33S-R11W
 Barber County, Kansas
 KCC Control # 970017-00 District 1
 D. Sellers 6/13/14

Kansas
 Corporation Commission

Project: Wingate Contamination Site

Site Location: NE/4 of Section 17, Township 29 South, Range 17 East, Wilson County.

Impact/Immediacy: Impact is to the groundwater and soil. Immediacy level is rated as low.

Site Description: This site is located on gently sloping land used for agriculture. Much of the scar is located in a low-lying drainage area next to or within a waterway. Brine seepage originates from the Thayer coal bed or Cottage Grove Sandstone Member, which overlies the Chanute Shale in the higher areas.

Unusual Problems: This property is leased by Quest Cherokee. The Mary Douglas property located in the next ¼ section east contained 22 abandoned wells, many of which had high fluid levels and were old style completions. These abandoned wells are contributing to the source of the brine commingling with the shallow aquifer impacting the Wingate property. These wells were plugged by the State and the project was completed in February of 2009.

Status of Project: Four new monitoring wells were constructed on this project in early 2012. These wells were sampled two times in 2014 on the following dates: 2/18/2014 and 7/31/2014. Statistical analysis of samples collected from these four new monitoring wells indicates overall Cl- concentrations are trending down. The results of these samples are as follows:

WIN1: 2,800 and 2,000 ppm Cl- **WIN2:** 2,100 and 1,800 ppm Cl-
WIN3: 1,200 and 1,600 ppm Cl- **WIN4:** 3,000 and 2,800 ppm Cl-

Level of Remediation Sought:

Ideal: 250 ppm Chloride
Target: 500 ppm Chloride

Recommendation for Future Work: Sample semi annually. This site should possibly be expanded to include the Mary Douglas property located in NW 16-T29S-R17E WL Co.. Sampling in 2014 indicates that the primary source of brine is coming from the SSE of this project. Graphical analysis of the Cl- concentrations in these four wells indicate a general trending down. However spikes in the graph indicate periods of influx of brines moving through the system possibly indicating an undiscovered bore hole commuting with this shallow ground water zone reflecting increased flood and or disposal fluids from active operations completed within the same zone or CBM wells that have been shut in or pumping at reduced rates temporarily increasing formation pressures allowing greater communication with a possible unknown open bore hole. Further monitoring of existing wells and possible additional monitoring wells will help to delineate the extent and condition of this aquifer. Further review of KGS well data and GIS information has provided information on two additional possible locations of abandoned wells for further filed investigation.

Estimated Total Costs: Four new monitoring wells were completed at a cost of \$8,196 in 2012.



Control No.	Staff Hours/Expenditures	Fund Expenditures	
		FY 2014/15	Total
970107-00	40 Hrs. / \$1,058.48		\$8,296
Current Contaminate Level: 1,200 ppm Cl- to 3,000 ppm Cl-			
Status:Active			
<input type="checkbox"/> 1. Site Assessment	<input type="checkbox"/> 2. Short Term Monitoring	<input checked="" type="checkbox"/> 3. Investigation	
<input checked="" type="checkbox"/> 4. Long Term Monitoring	<input type="checkbox"/> 5. Remediation Plan	<input type="checkbox"/> 6. Installation	
<input type="checkbox"/> 7. Remediation	<input type="checkbox"/> 8. Post Rem. Monitoring	<input type="checkbox"/> 9. Resolved	

KANSAS CORPORATION COMMISSION

Wingate Remediation Site
NE 17 - T29S-R17E
Wilson County, Kansas
Project 970170-00

11/20/2014

District 3

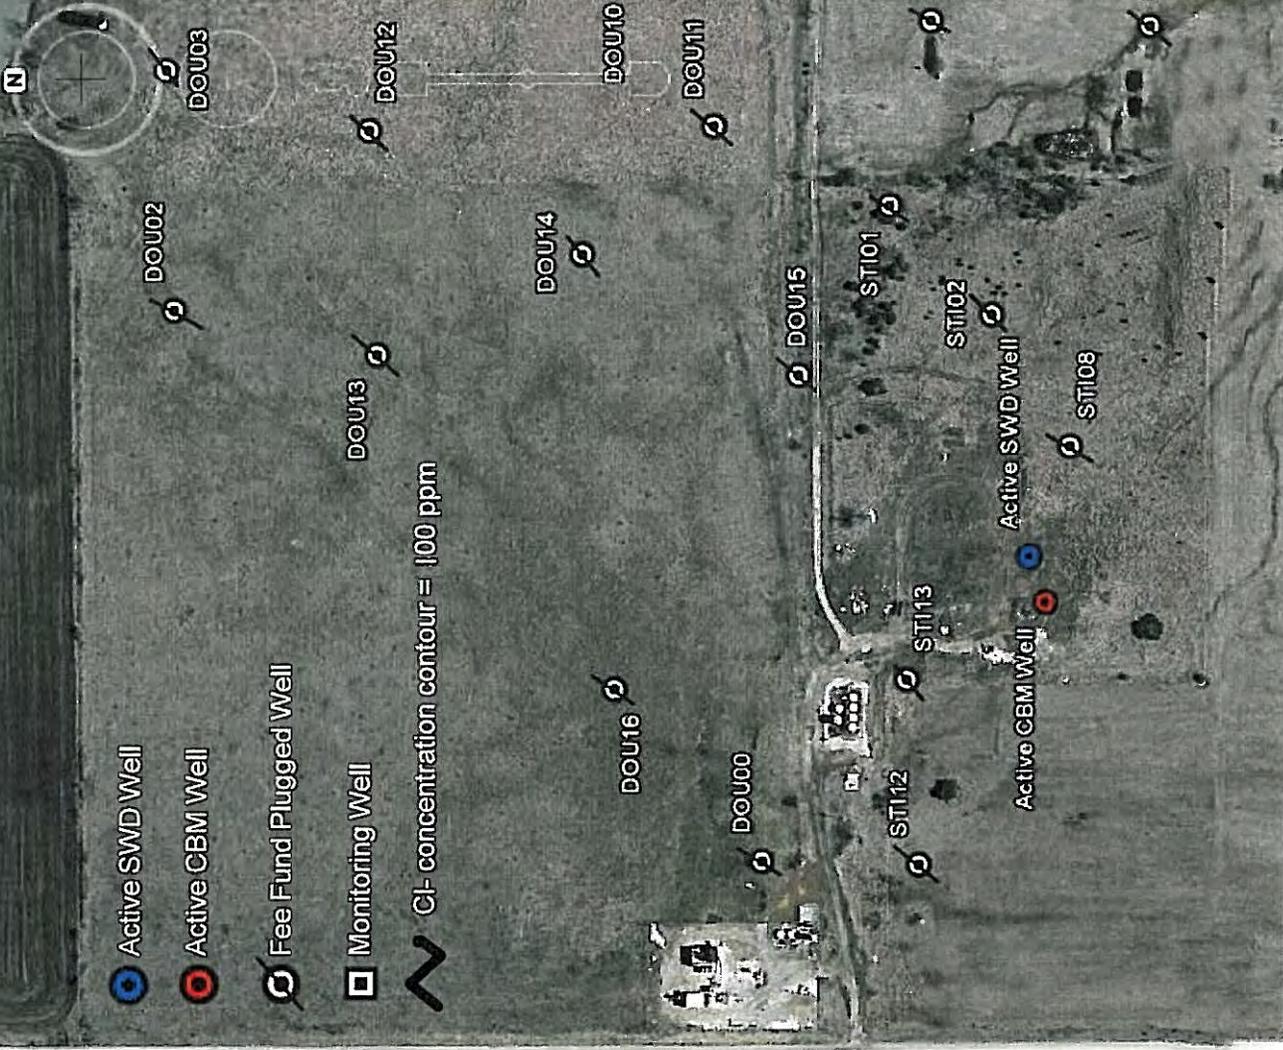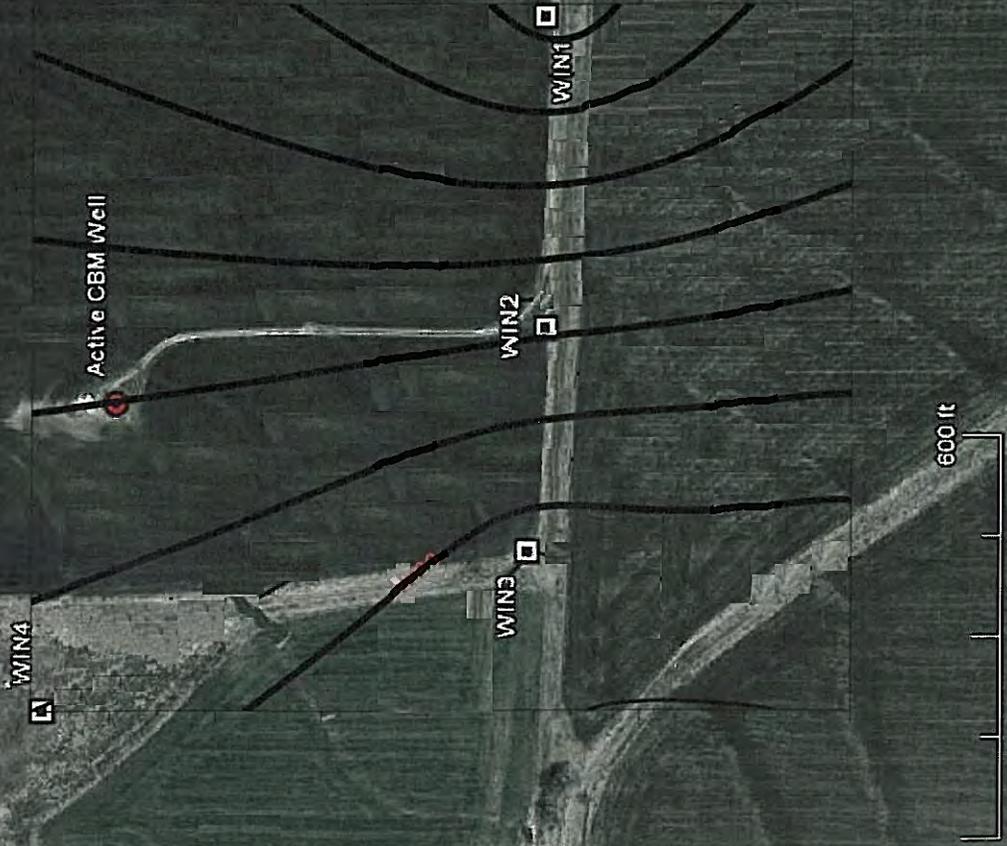

Project: Yeoman Site

Site Location: The Yeoman site is located in the center of the southeast quarter of section 35 T 28S R7W. This area is five miles south and three miles east of the city of Kingman in Kingman County.

Impact/Immediacy: The abandoned Yeoman #1 located in the center of the SE/4 has charged up shallow zones in the Permian Red Beds with gas. The site classification is high due to the remaining gas in place even after producing the gas from 5 monitoring / recovery wells.

Site Description: The Yeoman #1 is located in pasture used for grazing cattle. The Permian Red Beds are encountered at a depth of 50' consisting of very soft, sandy weathered red shale. The unconsolidated alluvium above the Red Beds consists of a fine to medium grain sand that is the primary shallow aquifer for this area. There are five monitoring /recovery wells offsetting the abandoned Yeoman #1 that were drilled to a total depth of 150 feet with gas encountered as shallow as 110 feet. Each monitoring / recovery well has approximately 90 feet of 7 inch surface casing set.

Unusual Problems: In early 2009, KCC staff became aware of gas coming up an abandoned water well in the SW corner of Sec. 30-28-6W, over a mile away from the Yeoman #1. The property owner is Harold Reid, and the water well is referred to as the Reid water well.

Status of the Project: Currently there are five monitoring / recovery wells directly offsetting the Yeoman #1 that are being produced by Don Graber (Gra Ex LLC, KCC Lic. #33921) under an agreement with the KCC. Mr. Graber has been producing the recovery wells since November 2009 and has recovered a total of 109,207 Mcf as of August 1, 2014. For the past 12 months the five monitoring / recovery wells have averaged 64 Mcf per day into the sales line. This is up from 60.4 Mcf per day for the prior 12 months. A total cumulative amount of 170,965 Mcf of gas has been recovered from these 5 recovery wells starting back in April 2006. (From KGS Production Data)

In April 2010 the KCC District 2 office drilled an additional 6 monitoring wells around the perimeter of section 36 in the section east of the Yeoman site. This was done in an attempt to delineate the escaped gas, and follow the upward trend of the Permian red beds to the northeast. Gas was found at all 6 locations with small initial shut-in pressures varying from 15 to 37 psi. The Permian red beds were encountered as shallow as 14 feet in MW #8 in the NE corner of section 36 as compared to 44 feet in MW #6 that was drilled in the SE/4 of section 35 and is the closest monitoring well drilled to the 5 recovery wells.

Consistent recovery has occurred over the last 5 years, and recovery amounts are staying level. Don Graber has reported a consistent 9 psi of pressure at the compressor for 2014. KCC is researching the area for possible new monitoring/recovery wells to help elevate the shallow gas issue.

Level of Remediation Sought:

Ideal: N/A

Target: N/A Complete the plugging of the Yeoman #1 once escaped gas has been depleted from the Red Beds.

Recommendation for Future Work: Continue to monitor gas production very closely with Don Graber. KCC staff recommends that Mr. Graber produce gas from MW #6, the closest MW to the 5 recovery wells in an attempt to accelerate the depletion of the gas in the charged up zone.

Estimated Total Costs: Plugging of the Yeoman #1 will be less than \$25,000 and can be done through KCC fee fund. Additional installation of wells plus staff time on research and investigation would be an estimated \$20,000.

Control No.	Staff Hours/Expenditures	Fund Expenditures	
		FY 2014/15	Total
20060021-001	10 Hrs. / \$269.78		\$93,690.76
Current Contaminate Level: Shallow Aquifer <70 ppm Cl- Water from Permian Red Beds tested 625 ppm Cl- in well #5 at 150' TD Total Gas Produced to date: 170,965 Mcf (KGS Production Data)			
Status:			
<input type="checkbox"/> 1. Site Assessment	<input type="checkbox"/> 2. Short Term Monitoring	<input type="checkbox"/> 3. Investigation	
<input checked="" type="checkbox"/> 4. Long Term Monitoring	<input type="checkbox"/> 5. Remediation Plan	<input type="checkbox"/> 6. Installation	
<input checked="" type="checkbox"/> 7. Remediation	<input type="checkbox"/> 8. Post Rem. Monitoring	<input type="checkbox"/> 9. Resolved	



Yeoman Escaped Shallow Gas Site
SE/4 of Section 35 and All of Section 36-T28S-R7W, Kingman Co., KS
Site Map for 2014-15 Legislative Reports
District #2 Control No. 20060021-001 11-4-2014 D. Bollenback

